

STATE OF OREGON
COUNTY OF POLK
CERTIFICATE OF WATER RIGHT

RECEIVED

APR 18 1997

WATER RESOURCES DEPT.
SALEM, OREGON

This Is to Certify, That **FRANK B. DOLL**

of Route 2, Box 200, Monmouth , State of Oregon , has made proof
to the satisfaction of the STATE ENGINEER of Oregon, of a right to the use of the waters of
Luckiamute River

a tributary of Willamette River

for the purpose of
irrigation

under Permit No. 19349 of the State Engineer, and that said right to the use of said waters
has been perfected in accordance with the laws of Oregon; that the priority of the right hereby
confirmed dates from March 8, 1950,

that the amount of water to which such right is entitled and hereby confirmed, for the purposes
aforesaid, is limited to an amount actually beneficially used for said purposes, and shall not exceed
0.36 cubic foot per second

or its equivalent in case of rotation, measured at the point of diversion from the stream.
The point of diversion is located in the Lot 3 (NW $\frac{1}{4}$ SE $\frac{1}{4}$), Section 24, Township 9 South,
Range 6 West, W. M.

The amount of water used for irrigation, together with the amount secured under any other
right existing for the same lands, shall be limited to one-eighthieth of one cubic foot per second
per acre, or its equivalent for each acre irrigated and shall be further limited
to a diversion of not to exceed 2 $\frac{1}{2}$ acre feet per acre for each acre irrigated
during the irrigation season of each year,

and shall
conform to such reasonable rotation system as may be ordered by the proper state officer.

A description of the place of use under the right hereby confirmed, and to which such right is
appurtenant, is as follows:

2 $\frac{1}{4}$.2 acres in Lot 3 (NW $\frac{1}{4}$ SE $\frac{1}{4}$)
4.8 acres in the NW $\frac{1}{4}$ SE $\frac{1}{4}$
Section 24
Township 9 South, Range 6 West, W. M.

Land on which water is to be used is a part of that described as follows:
That part of the NW $\frac{1}{4}$ SE $\frac{1}{4}$ lying Northerly of the Luckiamute River, the W 3/4
of the NW $\frac{1}{4}$ SE $\frac{1}{4}$, lying North of said River, all in Sec. 24, T. 9 S., R. 6 W.,
W. M.

This certificate is issued to correct and supersede the water right certi-
ficate recorded in State Record of Water Right Certificates, Volume 15, page
21406, so as to correctly locate the lands irrigated.

The right to the use of the water for the purposes aforesaid is restricted to the lands or place of
use herein described.

WITNESS the signature of the State Engineer, affixed

this date. November 16, 1964

State Engineer


Recorded in State Record of Water Right Certificates, Volume 23 , page 31722

RECEIVED

APR 18 1997

WATER RESOURCES DEPT.
SALEM, OREGON

T.9S.R.6W.WM

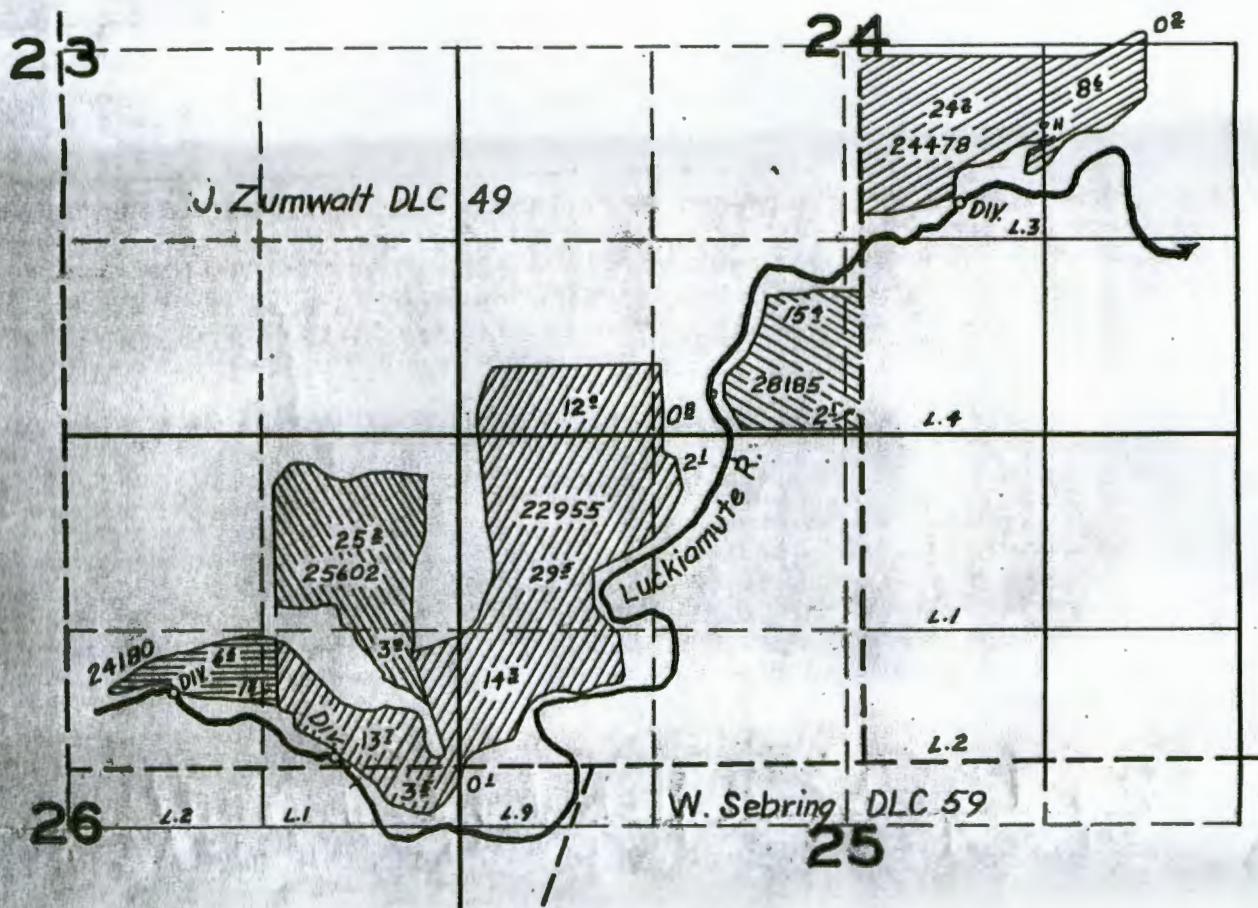

FINAL PROOF SURVEY

Application No. 24180 19015
25602 12349
22955 20039
28185 18189
Permit No. 22641

IN NAME OF

Herman Amos, Kenneth L. Richards, C. M. Gates
E. J. Gates, E. W. Gates

Surveyed July 13-14 1997, by T. Jones