


# T39S R5W Northwest Section 3

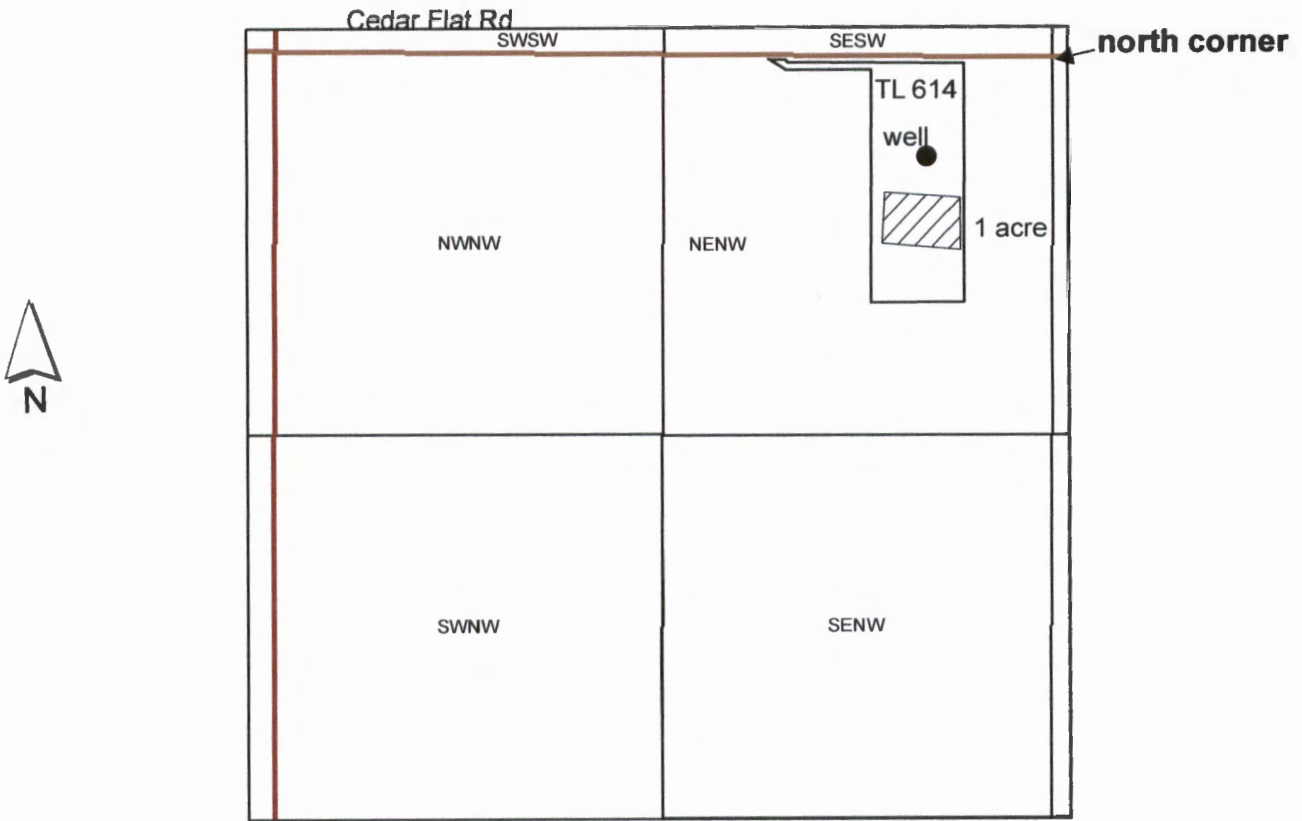

1 inch = 660 feet

The well is approximately 346 ft west and 420 ft south from the north corner Section 3, according to the landowner.

RECEIVED BY OWRD

MAY 31 2016

SALEM, OR

G-18304