


T.3S.R.1E.W.M.

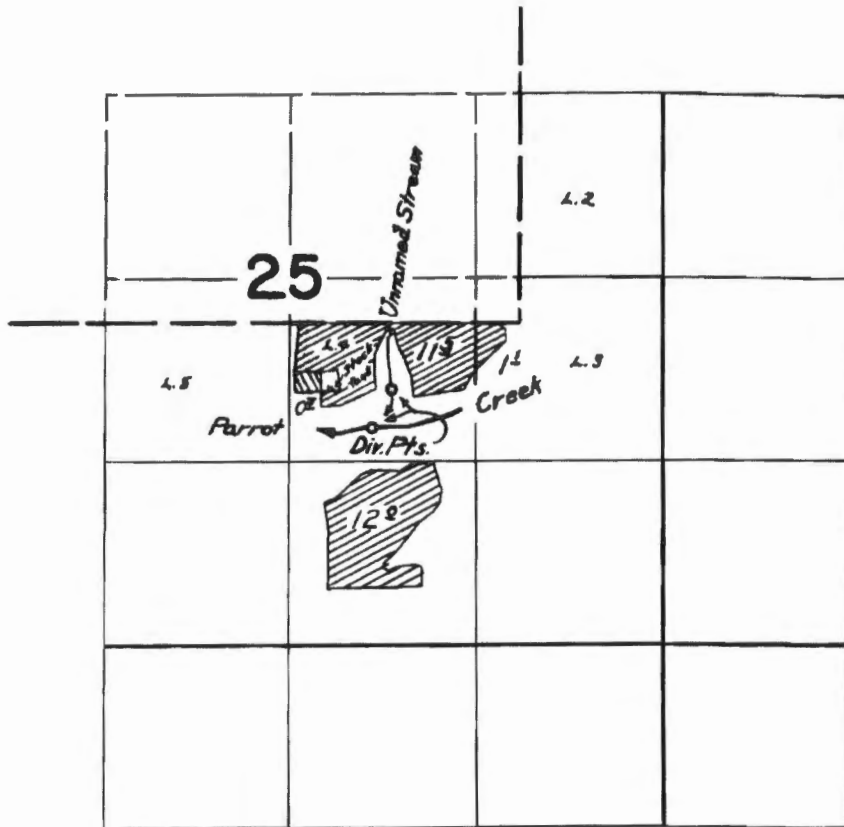

 *Unnamed Stream*

 *Parrot Creek*

FINAL PROOF SURVEY UNDER

Application No. *31928* Permit No. *25174*
IN NAME OF

Sidney J. Miles


Surveyed *June 21, 1962*, by *Thomas B. Lauer*

RECEIVED

JUN 06 2016

WATER RESOURCES DEPT
SALEM, OREGON

T.3S.R.1E.W.M.

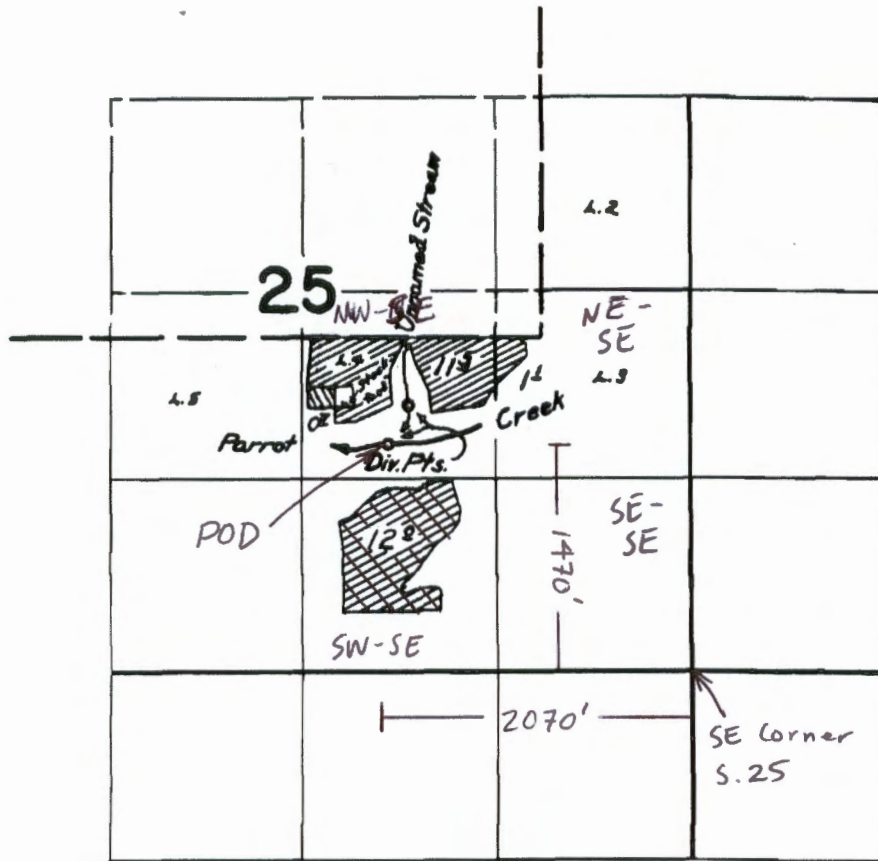

 Unnamed Stream

 Farrot Creek

Diversion point located 1470' N 2070' W from SE Cor. S. 25

1" = 1320'

 Area to be irrigated

RECEIVED

JUN 06 2016

WATER RESOURCES DEPT
SALEM, OREGON