OLY IDA RATM, LLC.

CLAIM OF BENEFICIAL USE MAP
APPLICATION R-70850, PERMIT R-11622, PERMIT AMENDMENT T-7619
JULY, 2010
LOCATED WITHIN TOWNSHIP 3 SOUTH, RANGE 7 EAST, W.M.

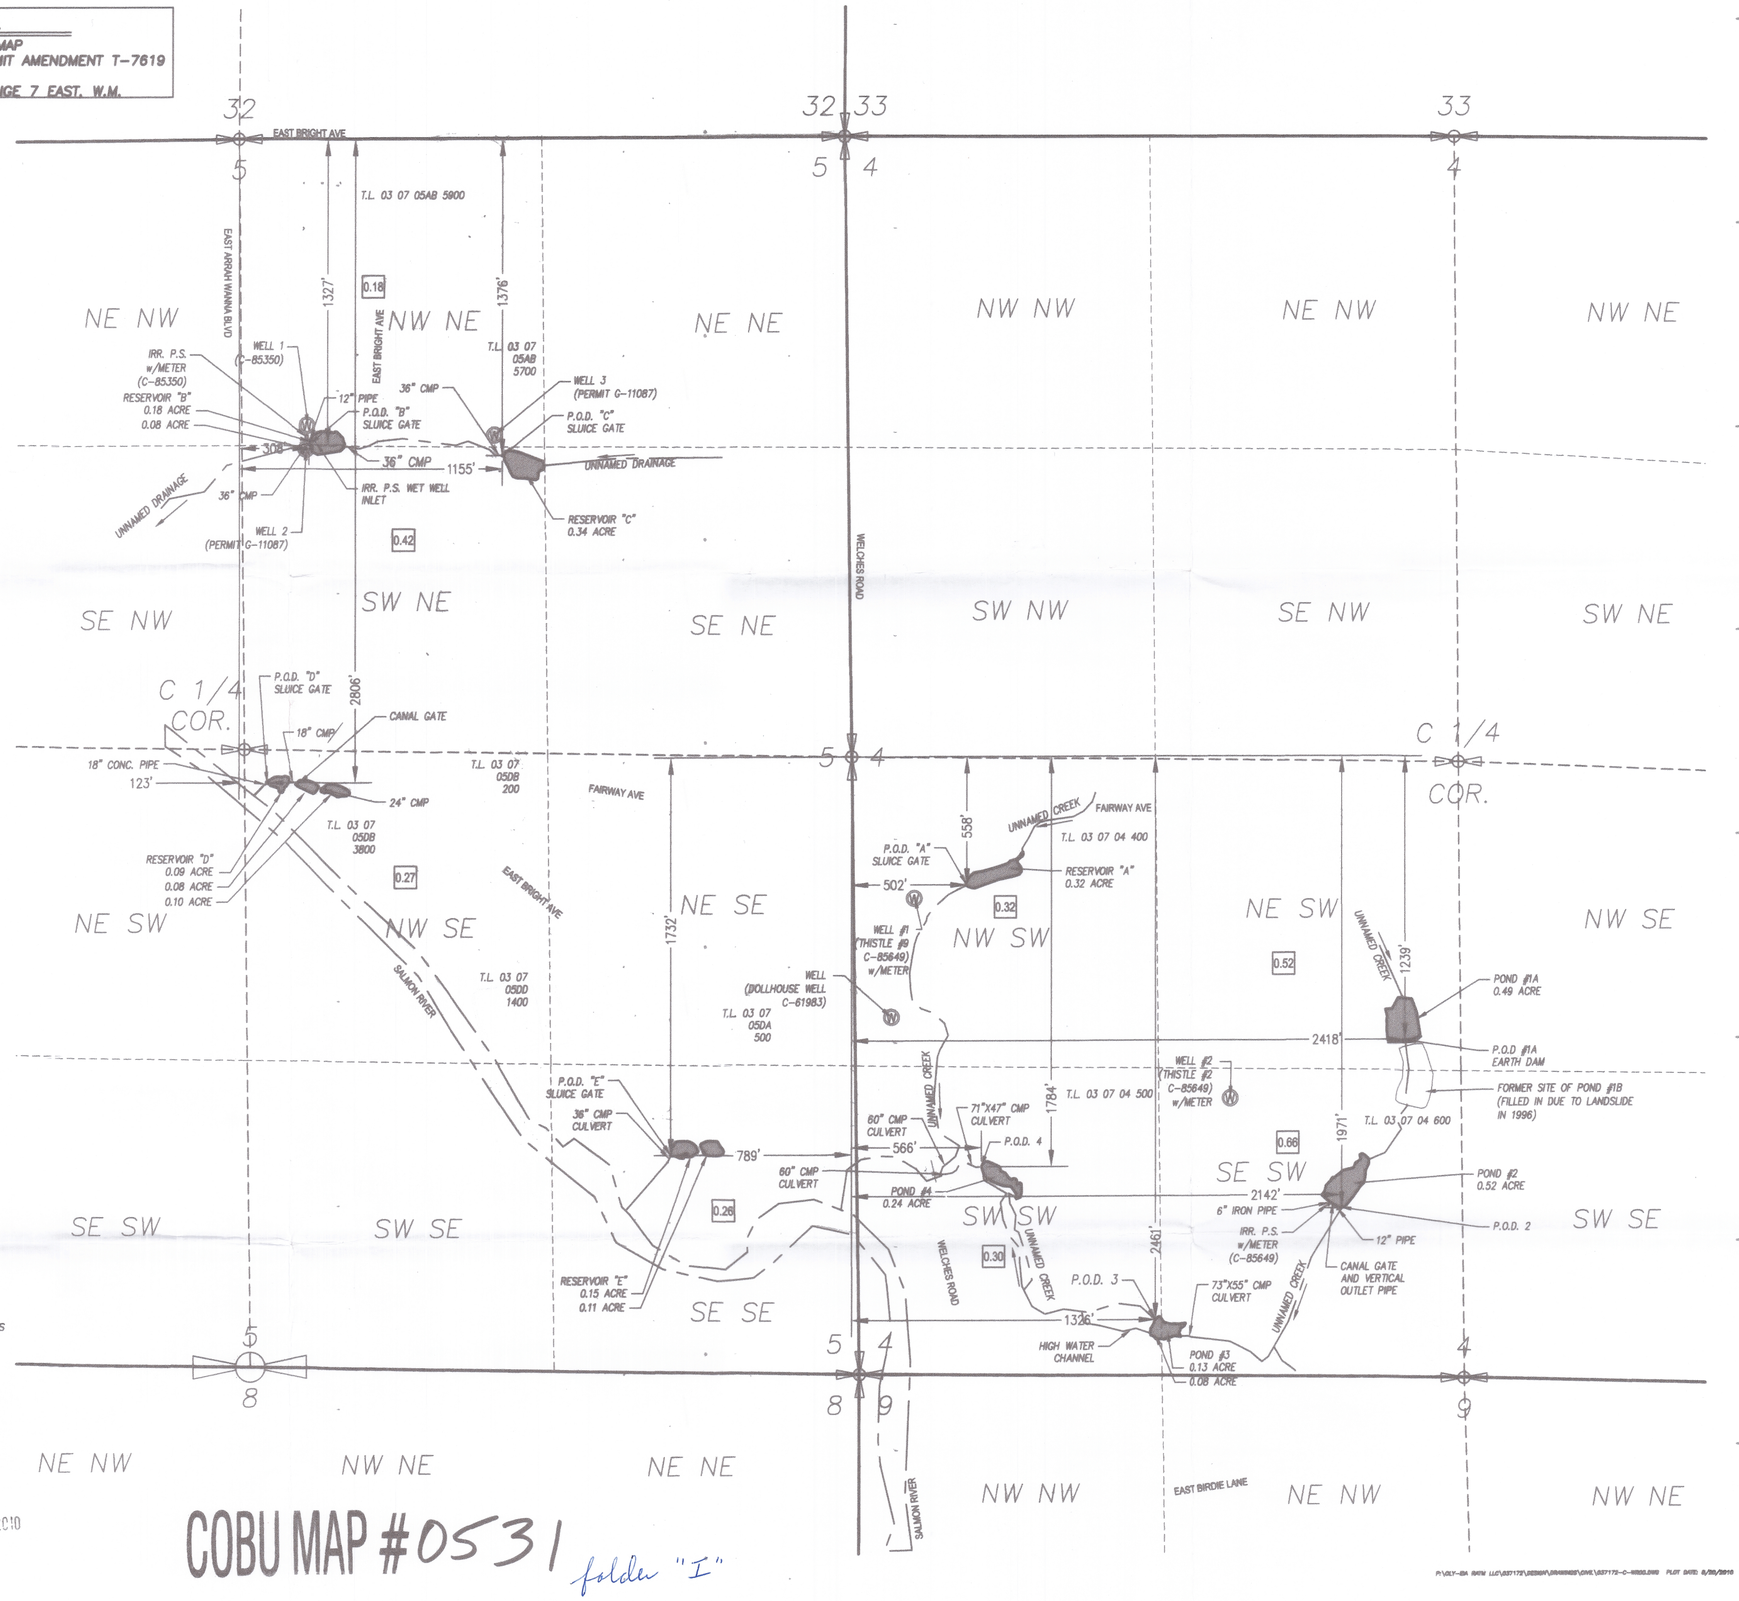

LEGEND

- EXISTING WELL LOCATION
- EXISTING RESERVOIR
- PROPERTY LINE (SEE NOTE BELOW)
- STREAM (APPROX. CENTERLINE)
- CULVERT
- 1.00 TOTAL LAKE AREA IN 1/4 1/4 SECTION (ACRES)
- SECTION LINE
- QUARTER SECTION LINE
- SIXTEENTH SECTION LINE

CERTIFIED WATER RIGHTS EXAMINER
80674 CWRE
NIALL W. BOGGS
JUNE 8, 2009
STATE OF OREGON
EXPIRES: 12-31-2011

N

SCALE
400 0 200 400 800
(FEET)
1 INCH = 400 FT.

NOTE: THIS MAP WAS PREPARED FOR THE PURPOSE OF IDENTIFYING THE LOCATION OF WATER RIGHTS. THIS MAP IN NOT INTENDED TO PROVIDE LEGAL DIMENSIONS OR THE LOCATION OF PROPERTY OWNERSHIP LINES.

WHPacific
123 SW Columbia Street
Bend, OR 97702
541-388-4255 Fax 541-388-4229
www.whpacific.com

AUG 3 - 2010

COBU MAP #0531 folder "I"

0531