


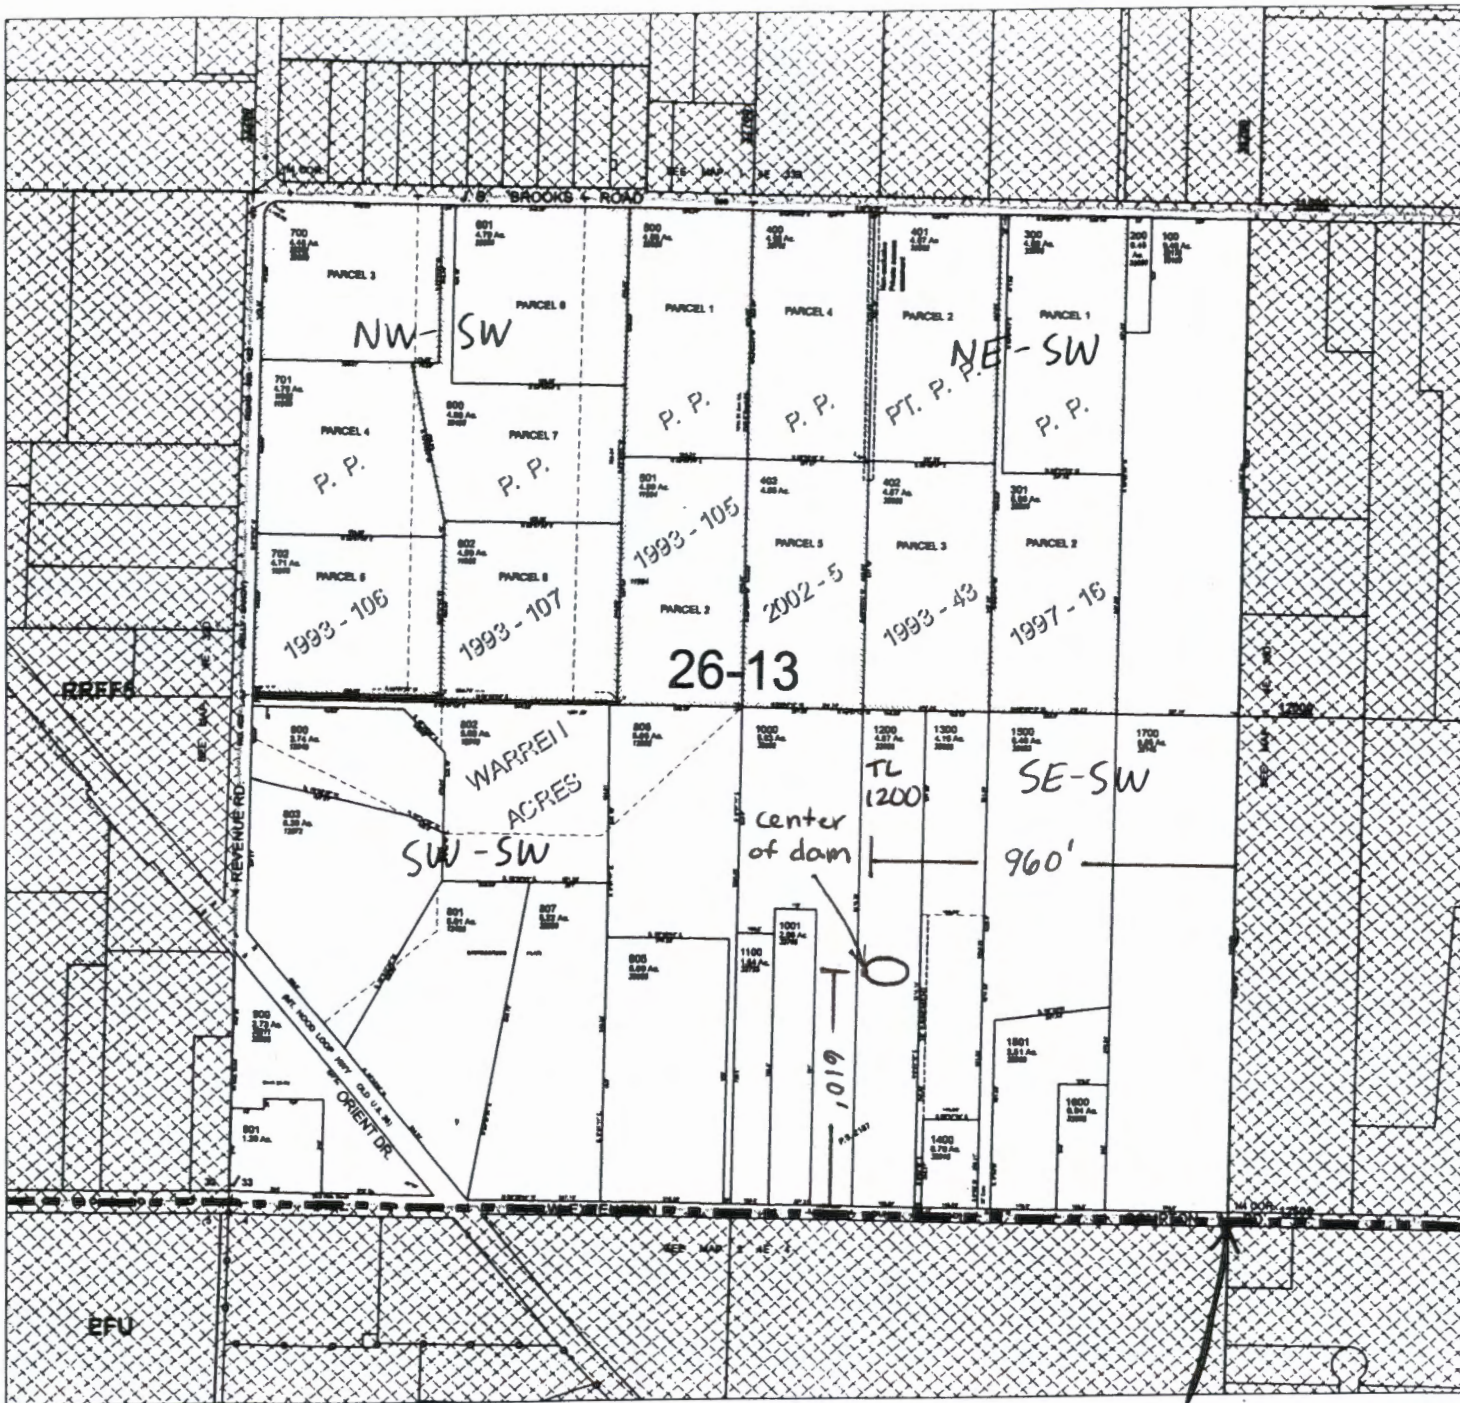

Reservoir Name _____

T 1 S, R 4 E Sec 33

SW 1/4

Scale 1" = 500'



Center of dam
located:

610' N 960' W
from S. Center
Section 33

RECEIVED BY OWRD

JUN 10 2016

SALEM, OR

R-88244

S. Center Section 33