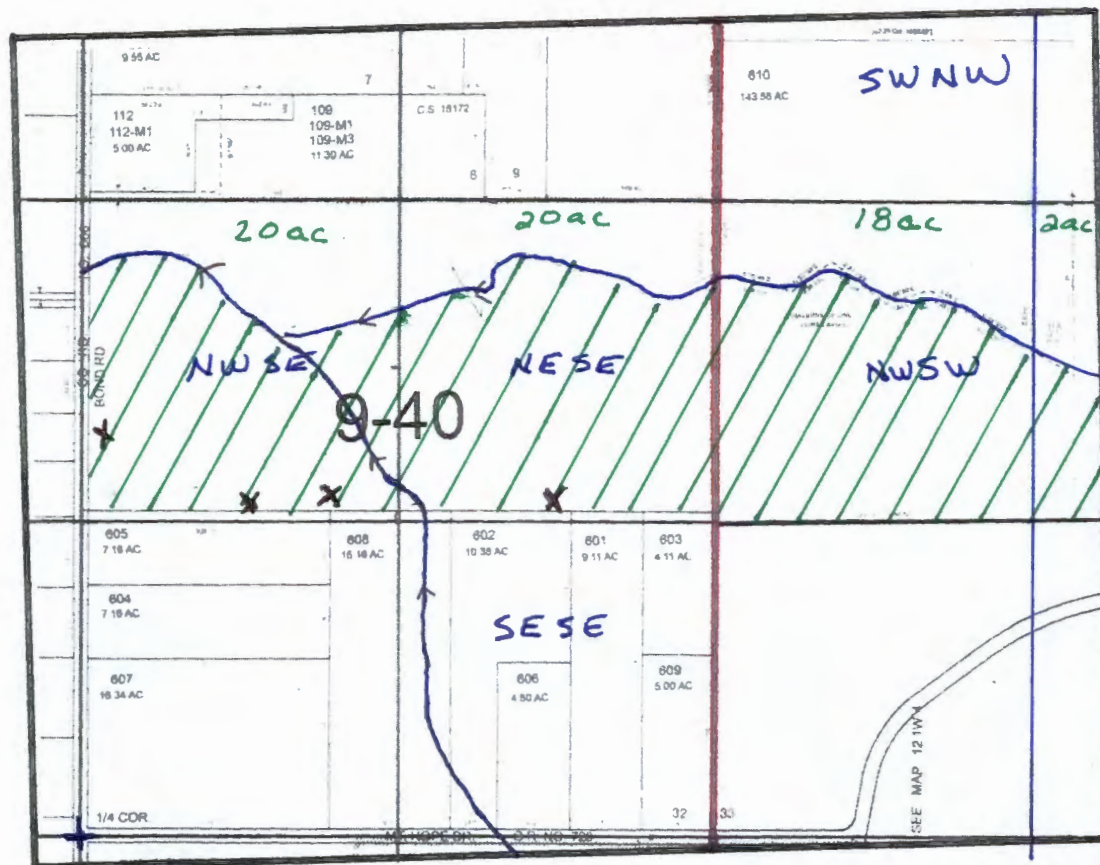


Sections 32 & 33


$$1'' = 800'$$

RECEIVED

JUN 17 2016

WATER RESOURCES DEPT
SALEM, OREGON

Well #1 located approximately 1600 feet North and 25 feet East;

Well #2 located approximately 200 feet North and 800 feet East;

Well #3 1200 feet North 1000 feet East
Well #4 1200 feet North 2000 feet East

Well #3

Well #4

From the South 1/4 corner of Section 32

1200 feet North

1200 feet North

1000 Feet East

2000 feet East

66-1654