


20288-5


8s 5w 3

Areas with Cross hatch are Irrigation Areas

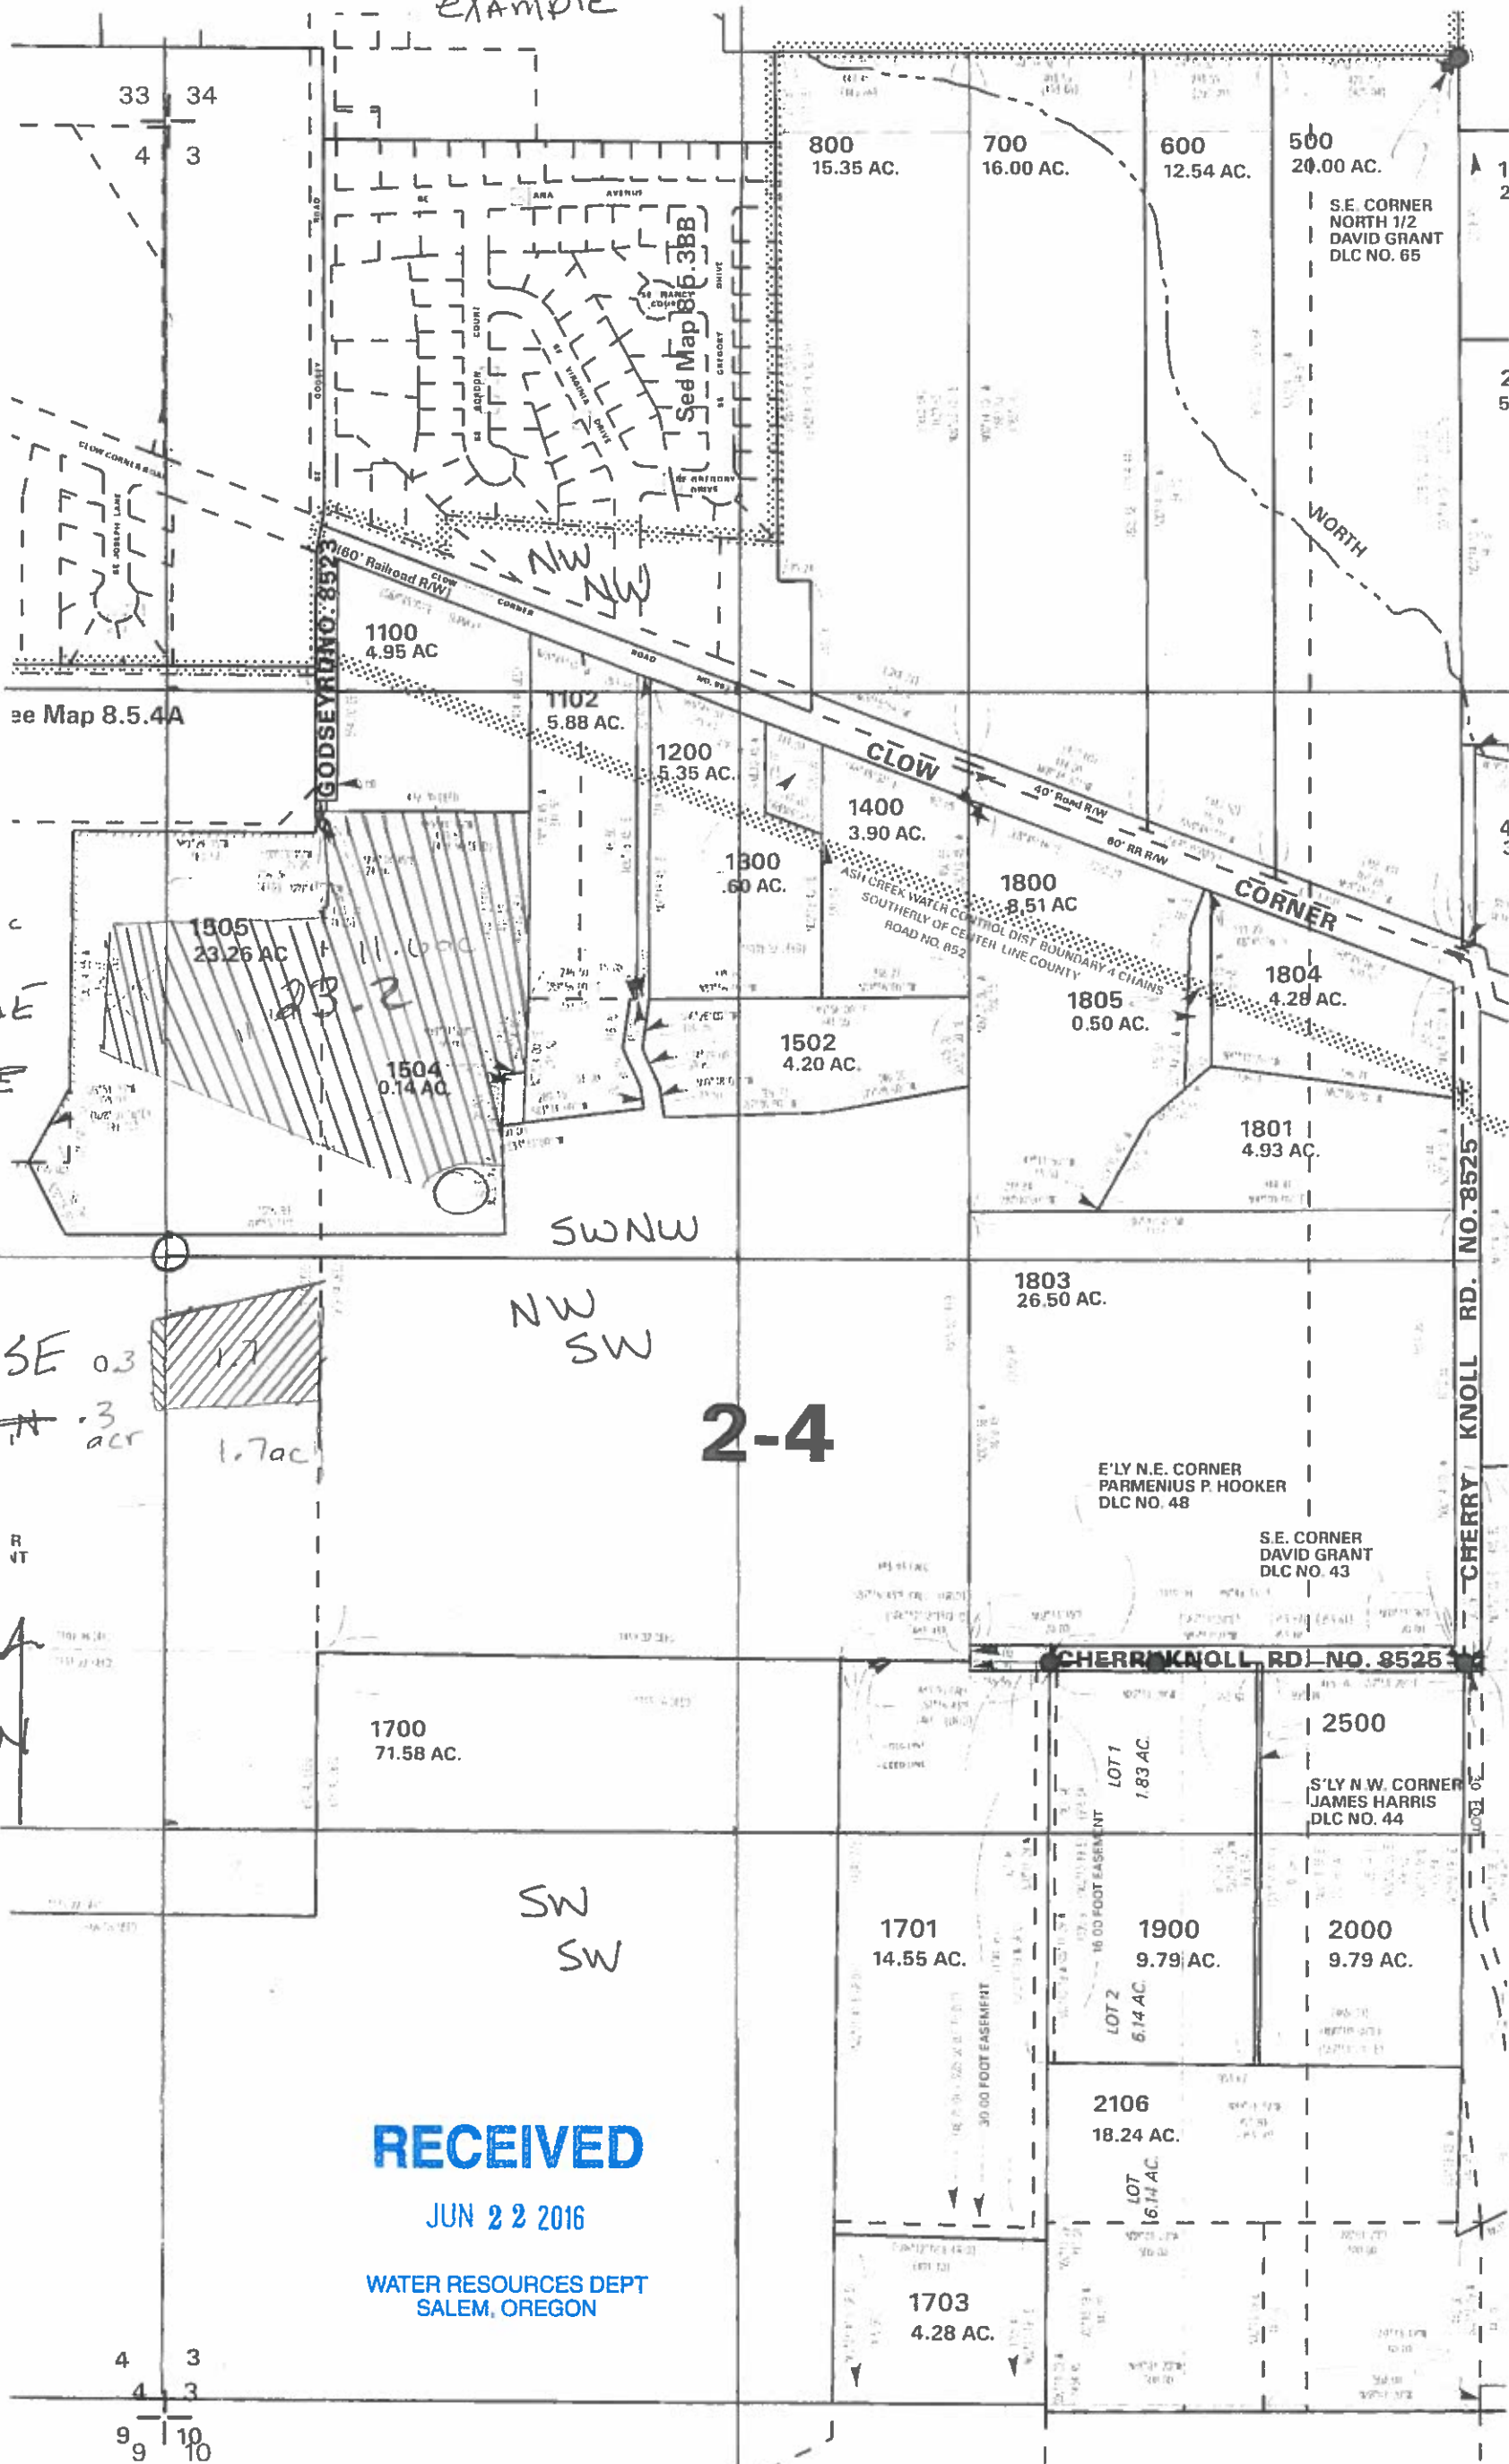

1.7ac  
SE NE  
SW NE

NE SE 0.3  
SE NE .3  
acr

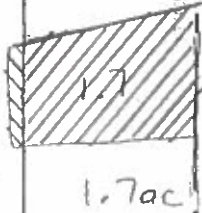

2-4

RECEIVED

JUN 22 2016

WATER RESOURCES DEPT  
SALEM, OREGON

680' east 160' north of the West 1/4 corner of section 3

1" = 400'