


T38S R5W West Half of Section 36

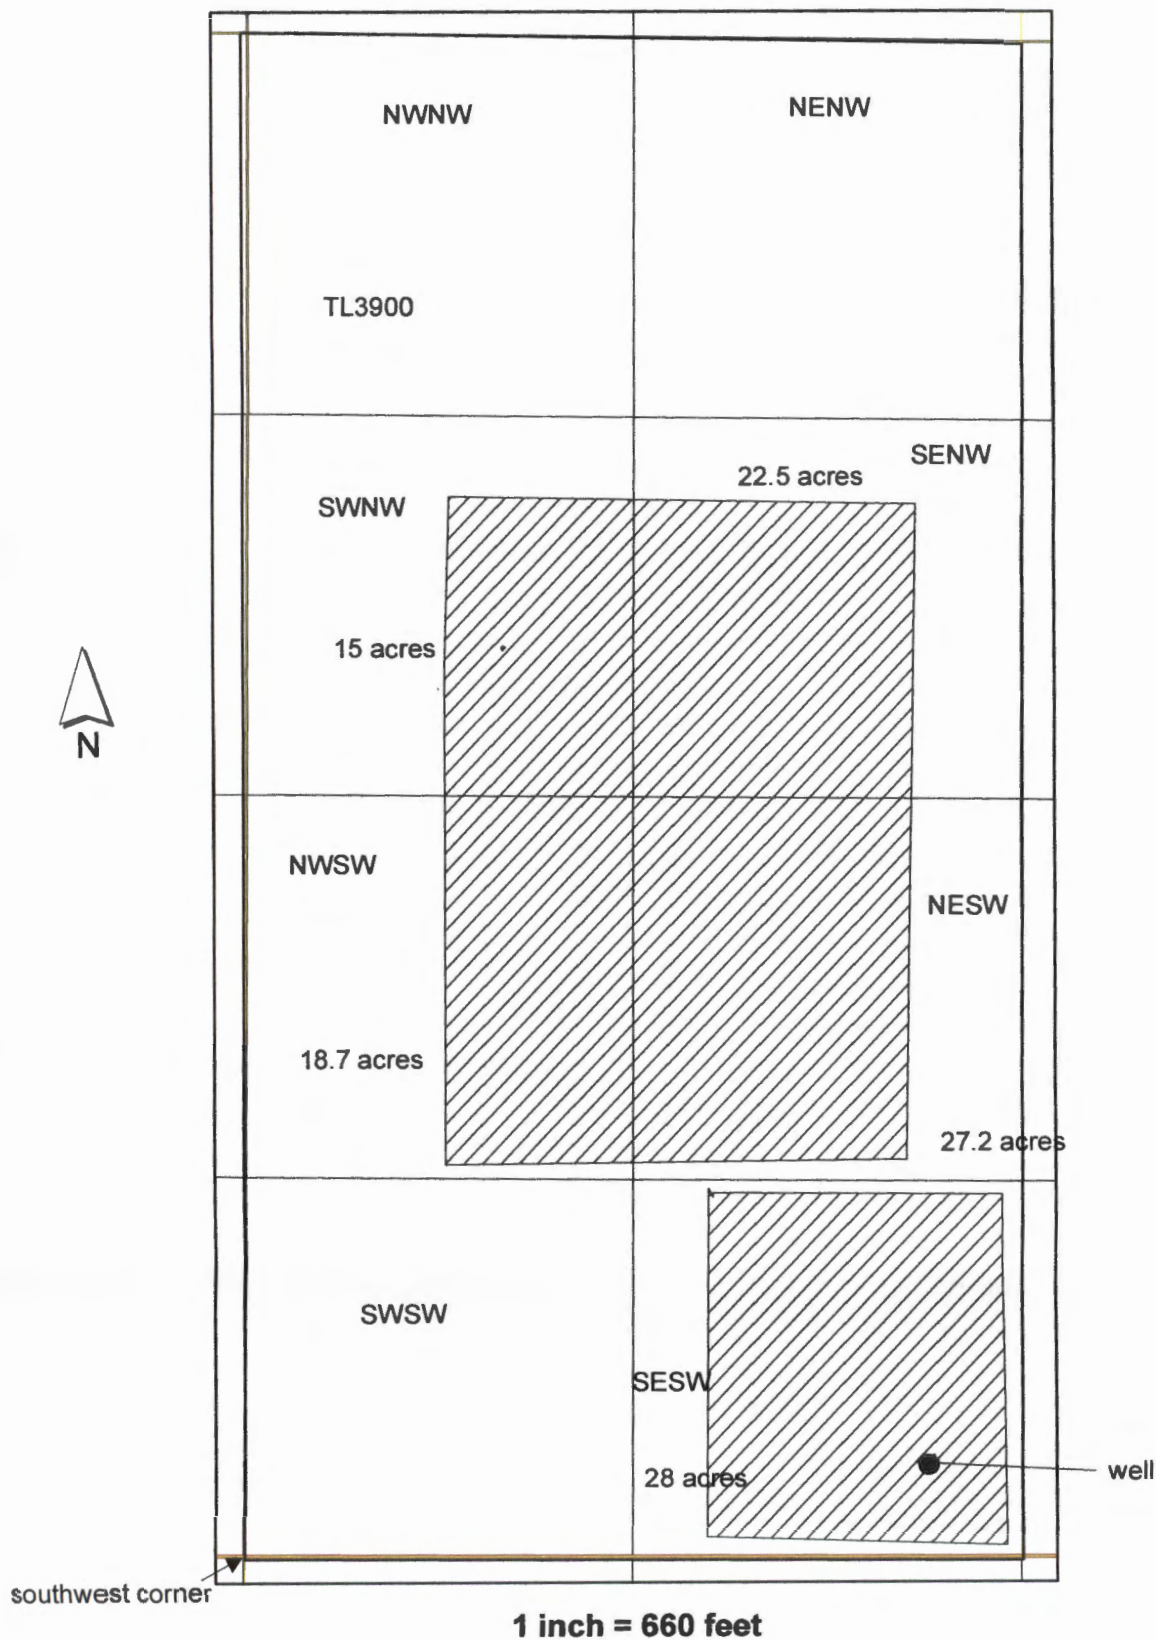

The well is located 323 feet north and 2344 ft east from the southwest corner Section 36, according to the owner.

RECEIVED BY OWRD

JUN 24 2016

SALEM, OR

G-19322