


6-18324

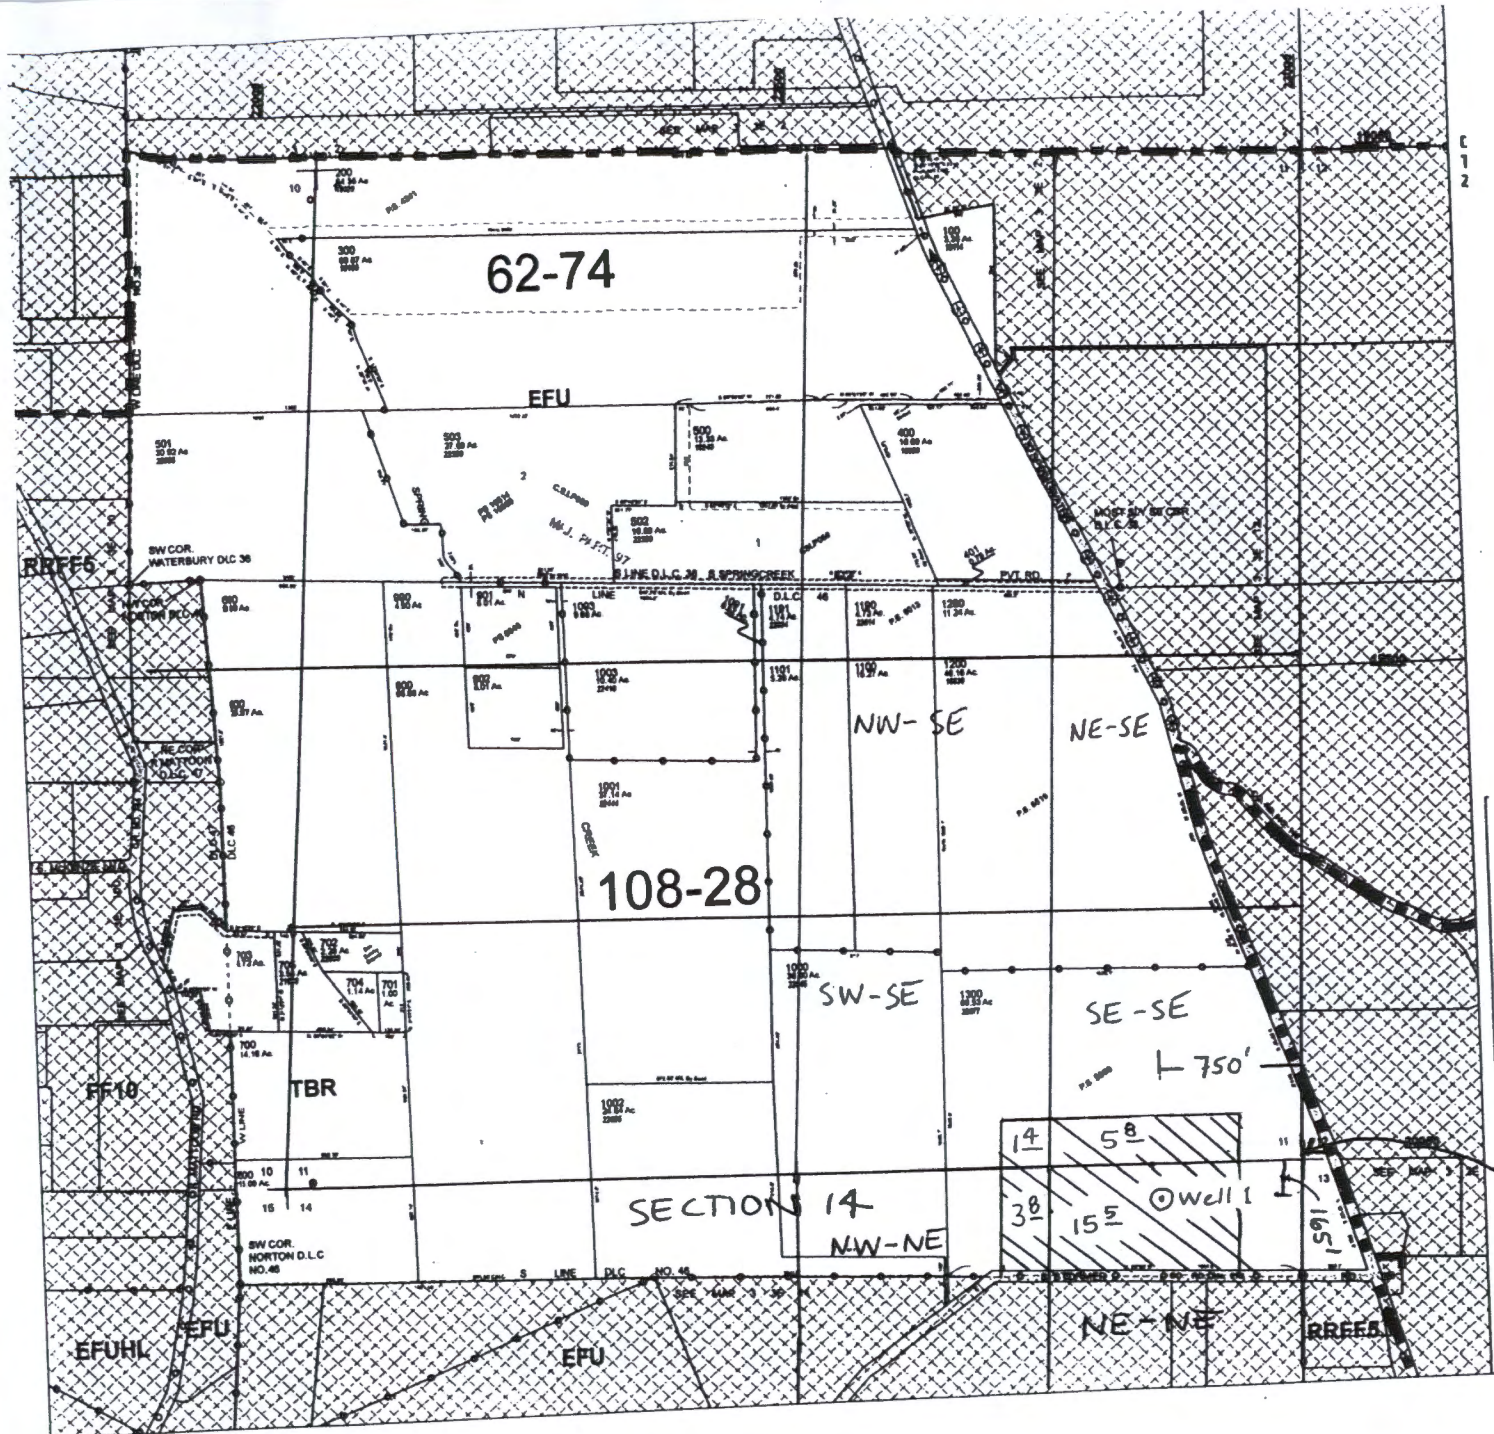

3S/3E - 11 + 14

Scale 1"=1000'



Proposed well is
located 165' S
750' W
from NE Cor. S 14
(well located in Section
14)

Area to be irrigated

NE Corner S. 14

NO. 10

JUN 27 2016

RECEIVED BY OWRD