


SECTION

TOWNSHIP 55, RANGE 3N, W. M.

North

West

East

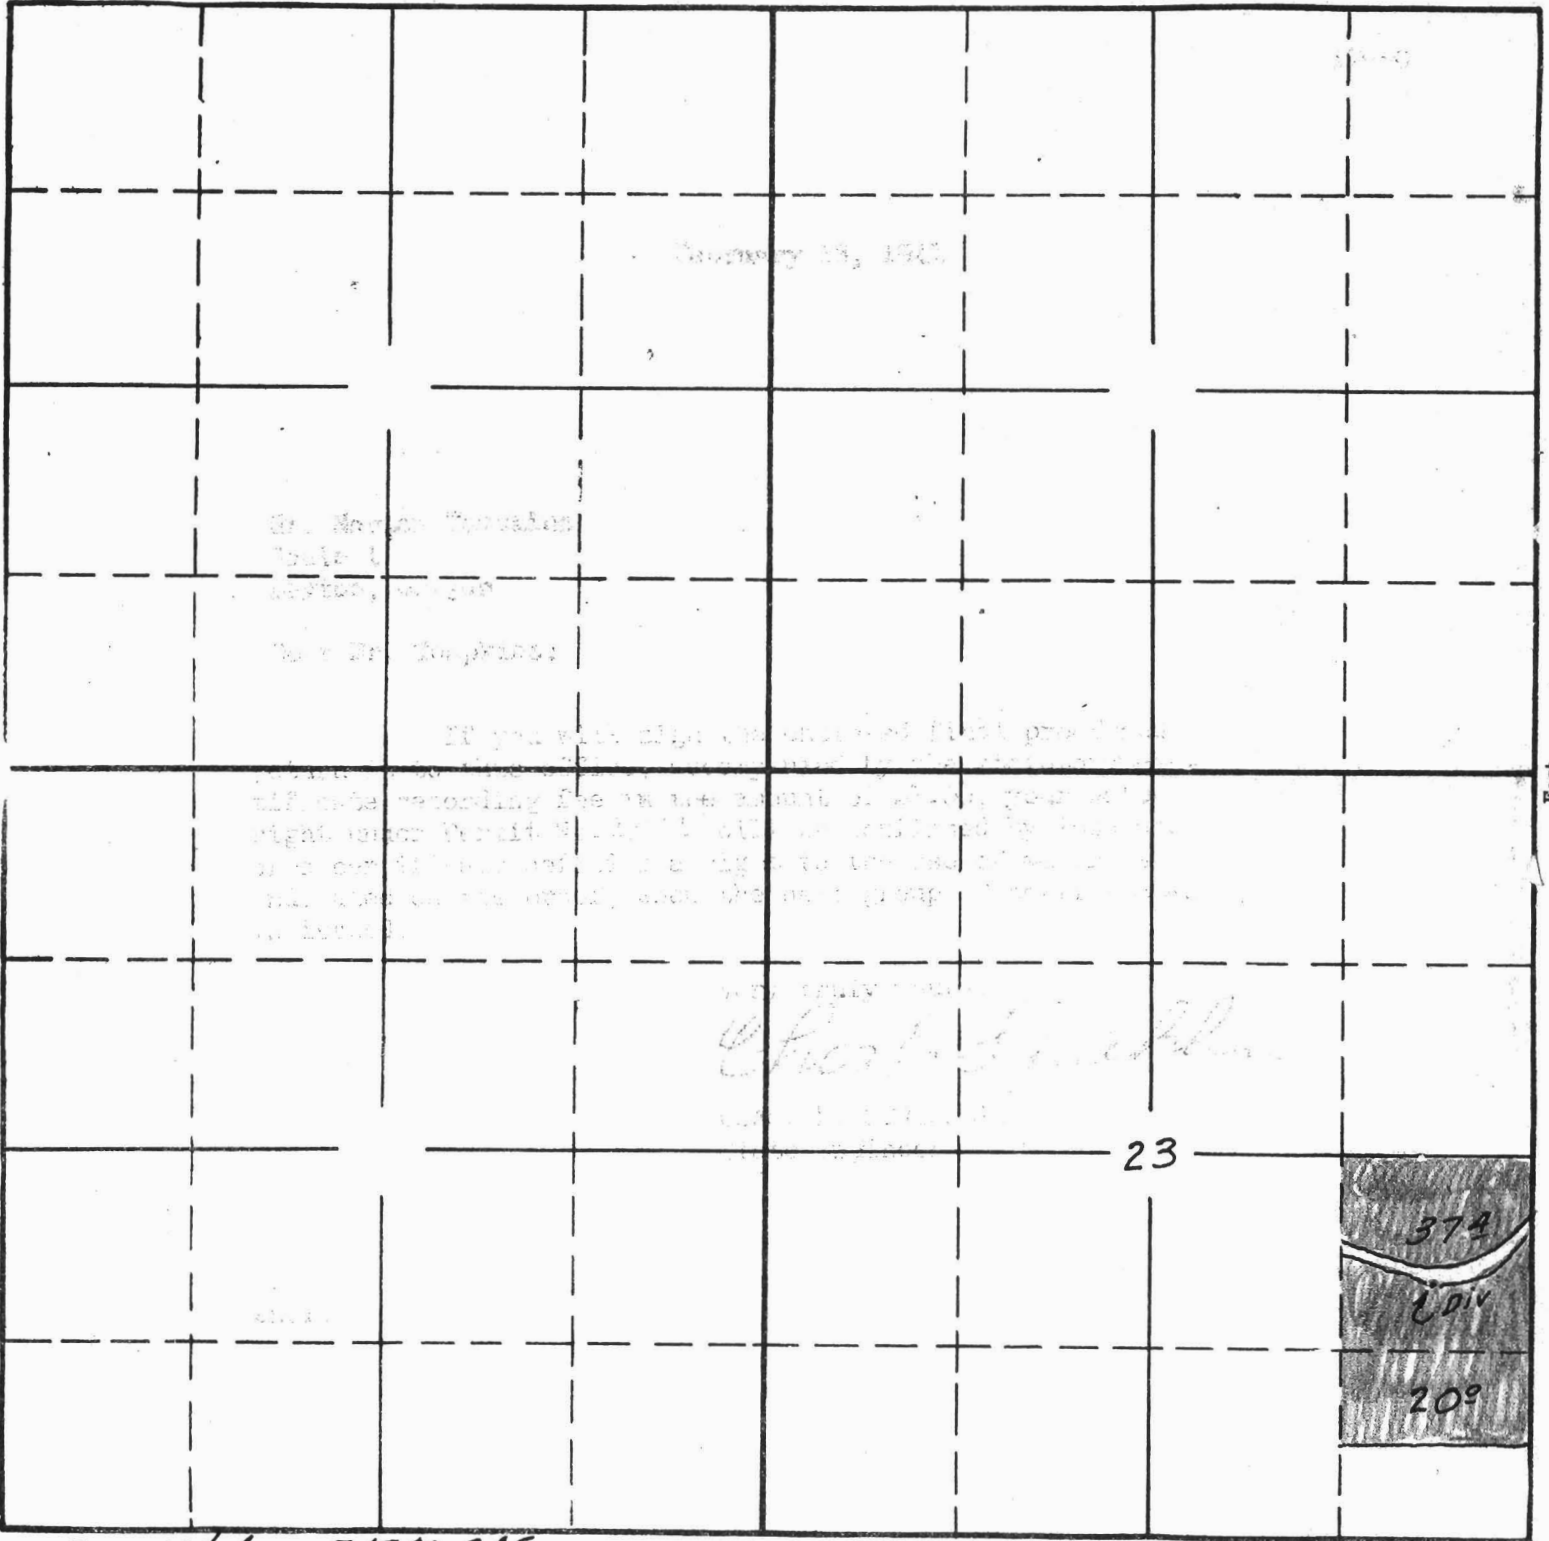

Surveyed June 5 1940 C.A.C.

South

APPLICATION No. 17950
PERMIT No. 13631