


JUN 10 2016

SALEM, OR

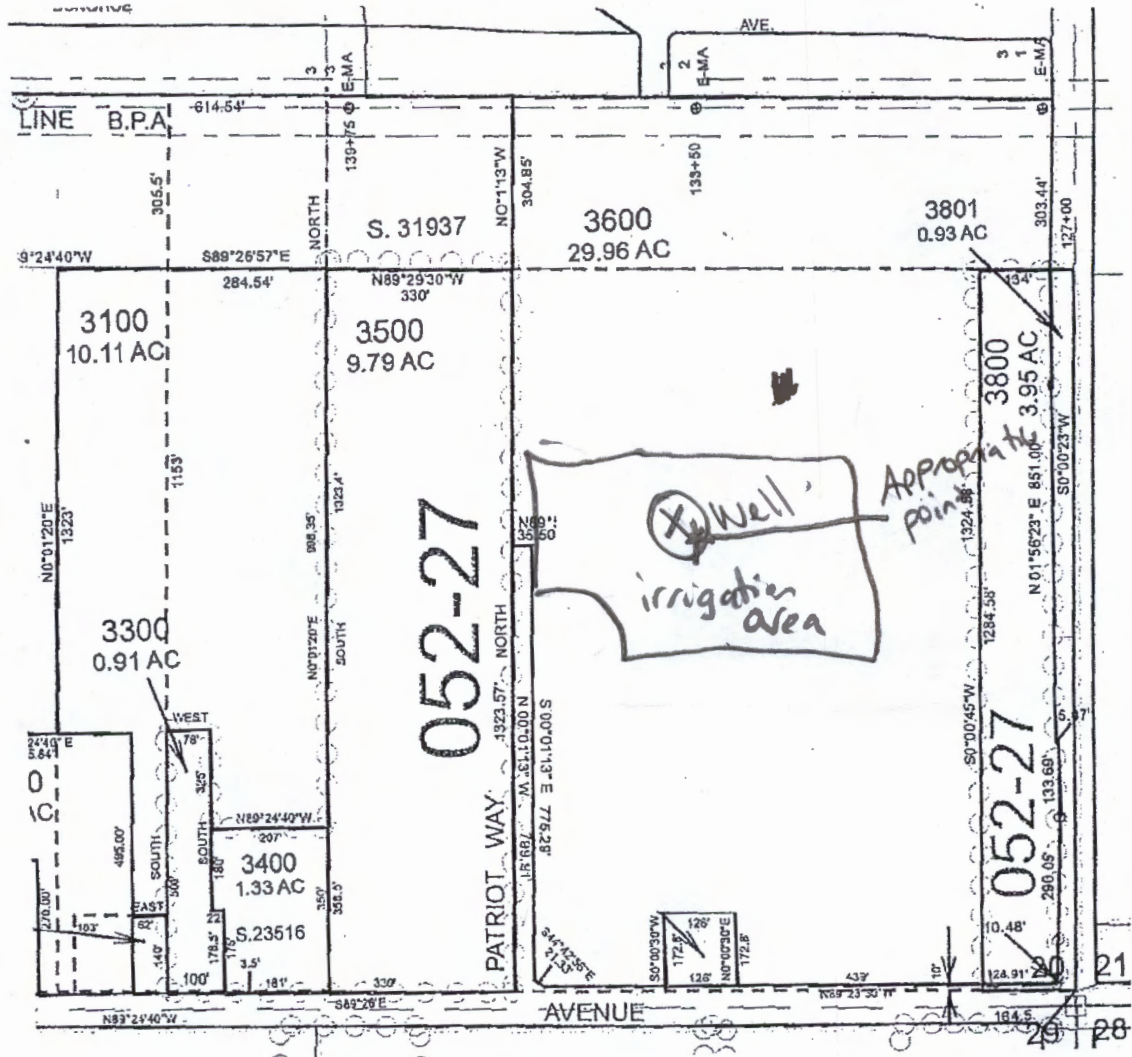

T 17 S, R 4 W Sec 20
 SE 1/4, SE 1/4

RECEIVED BY OWRD

JUL 05 2016

SALEM, OR

Well is 986 ft North and 455 ft West from
 SE Corner Section 20


Bethel FARM WELL

G-18174

RECEIVED BY OWRD

JUL 05 2016

SALEM, OR

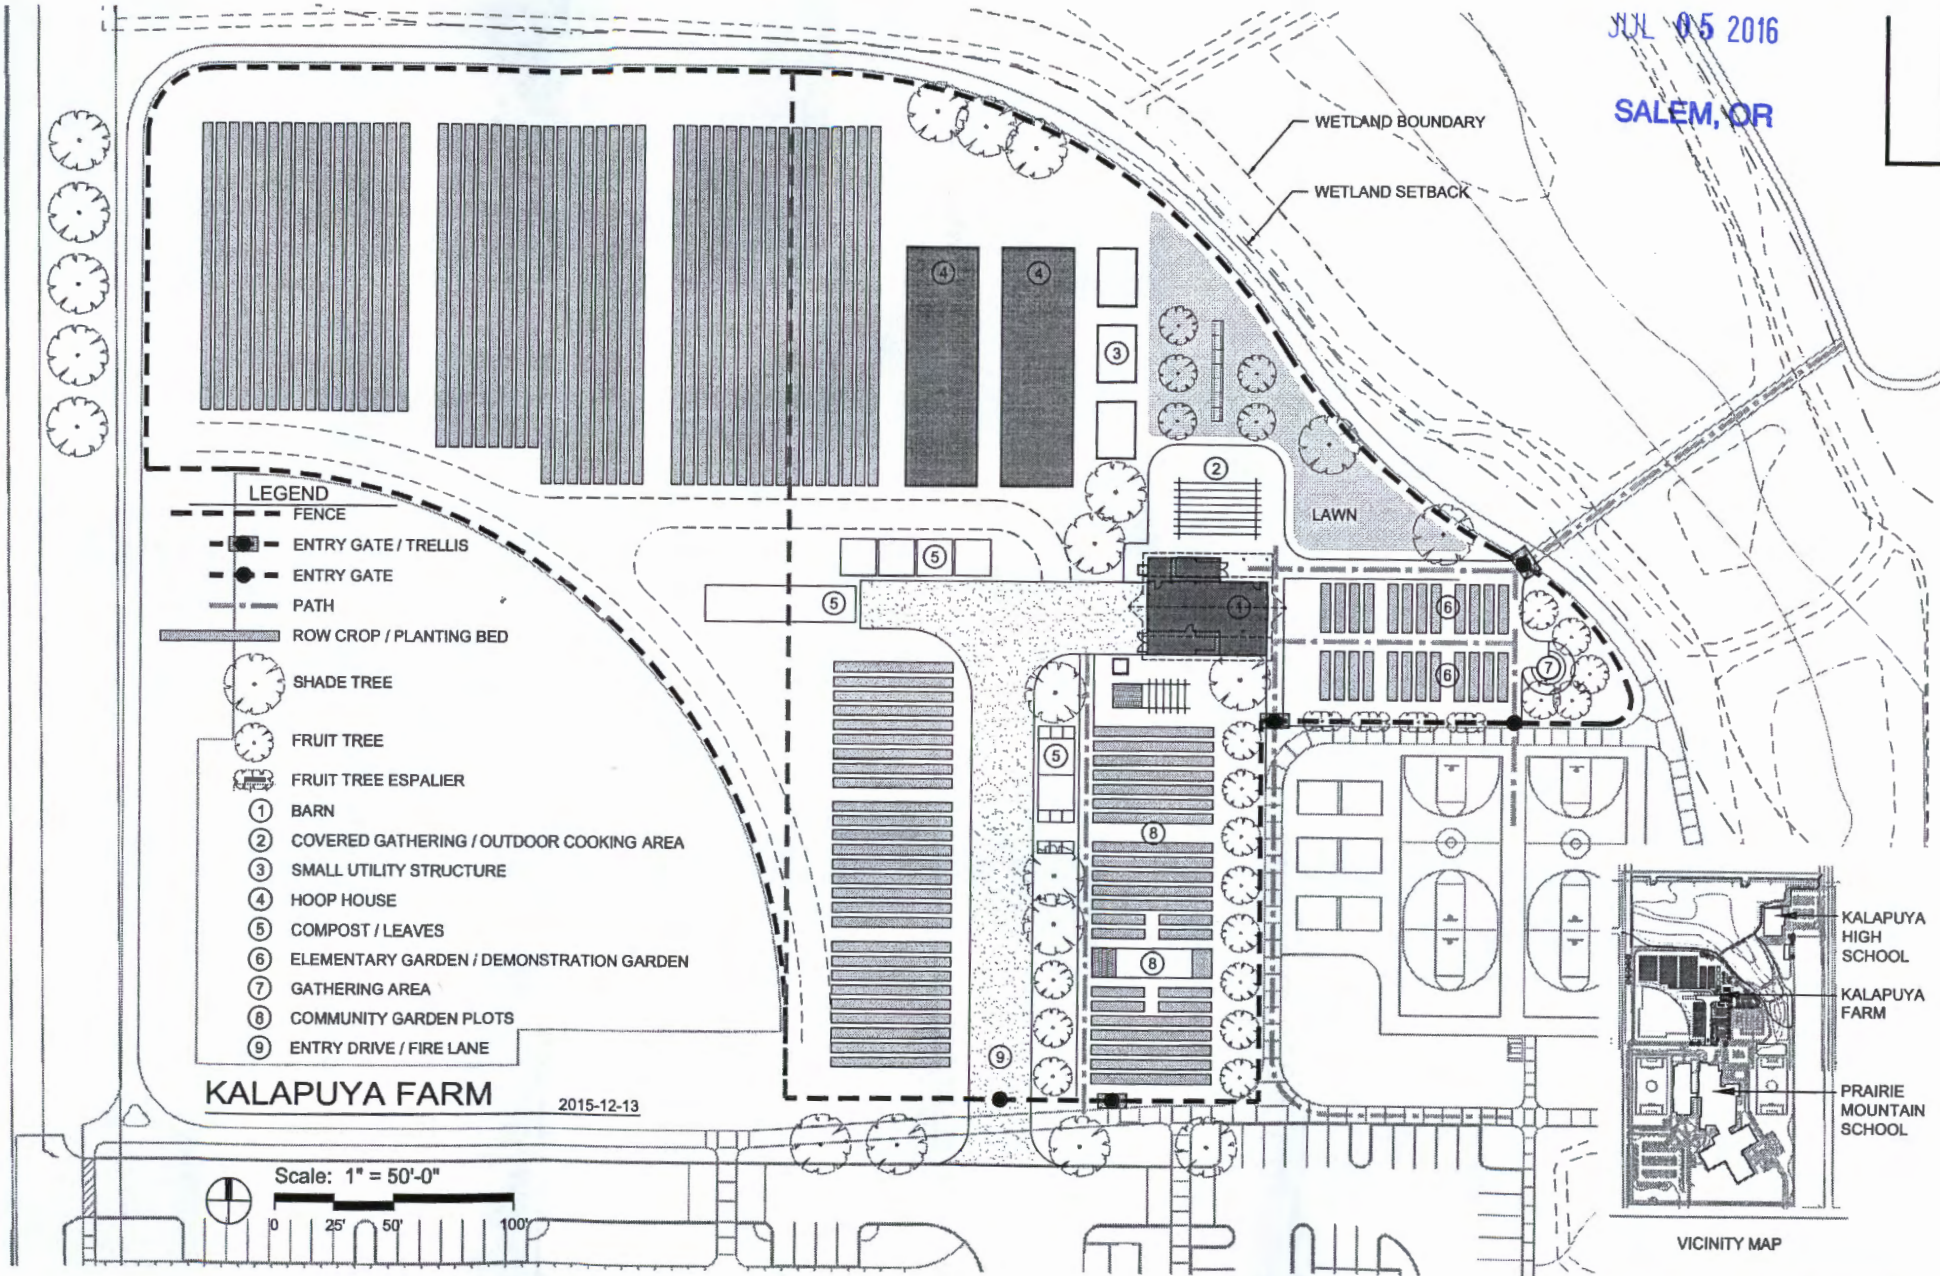

RECEIVED BY OWRD

JUN 10 2016

SALEM, OR