


T. 5 S., R. 3 W., WM

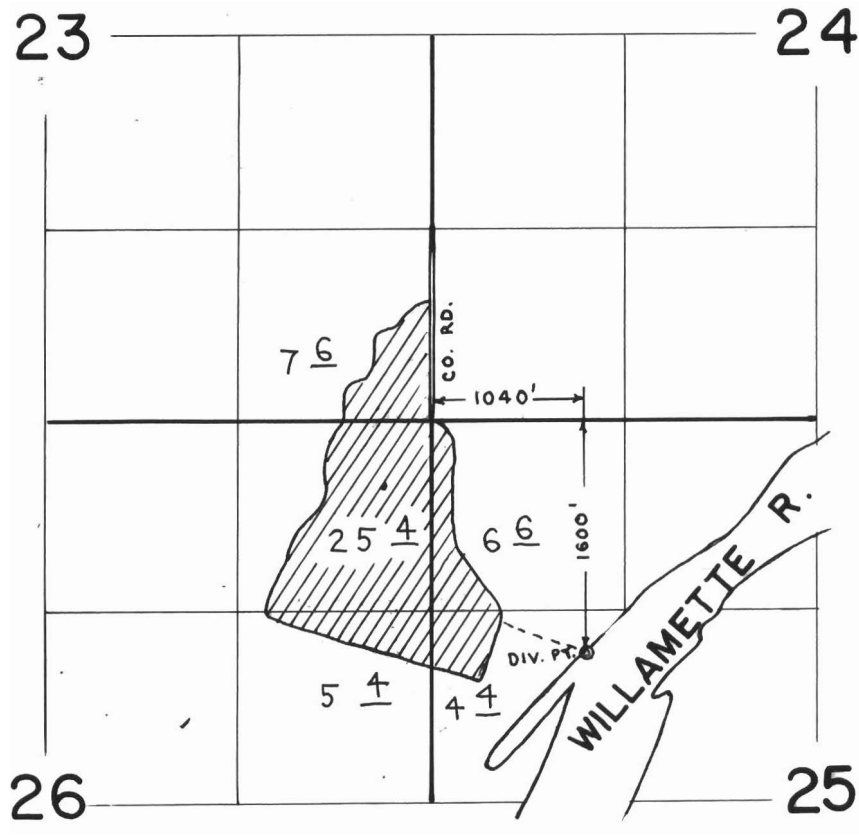

FINAL PROOF SURVEY
UNDER

Application No. 65276... Permit No. 47677... *Certificate 65865*
IN NAME OF

.....**JOHN NOBLE**.....

Surveyed **APR 27 1984**, by **P. PAGTER**.....