


T.26S. R. 5W W.M.
DOUGLAS COUNTY
Scale: 1" = 500'

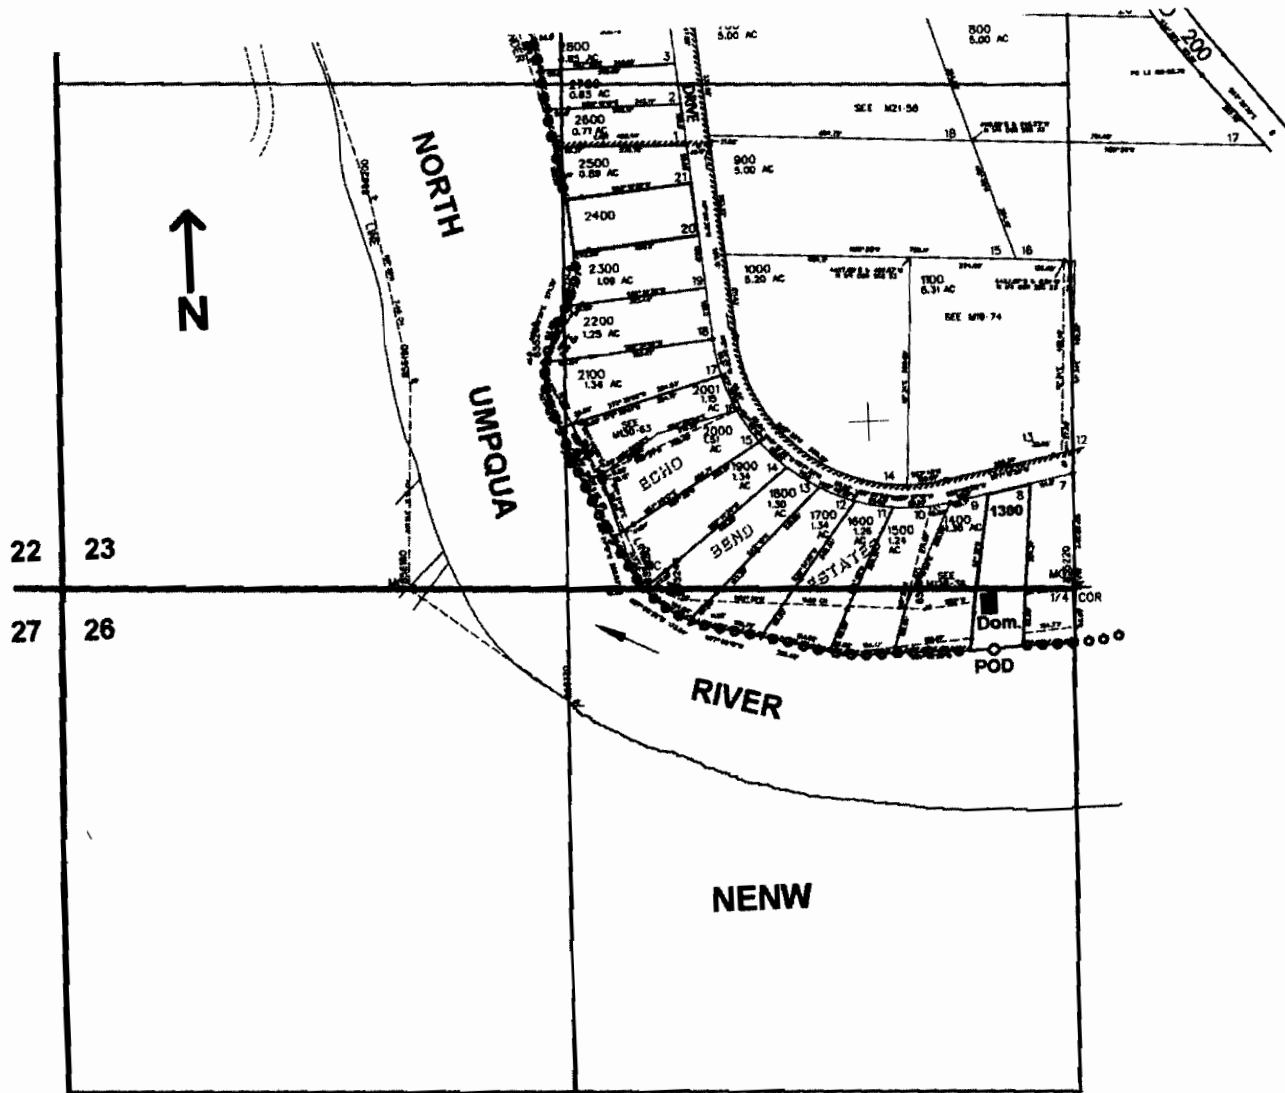

POD is located 160 ft. S. and 210 ft. W. from the N1/4 corner of Sec. 26

RECEIVED

JAN 25 2007

WATER RESOURCES DEPT
SALEM, OREGON