


# T35S R6W Southeast Quarter Section 18

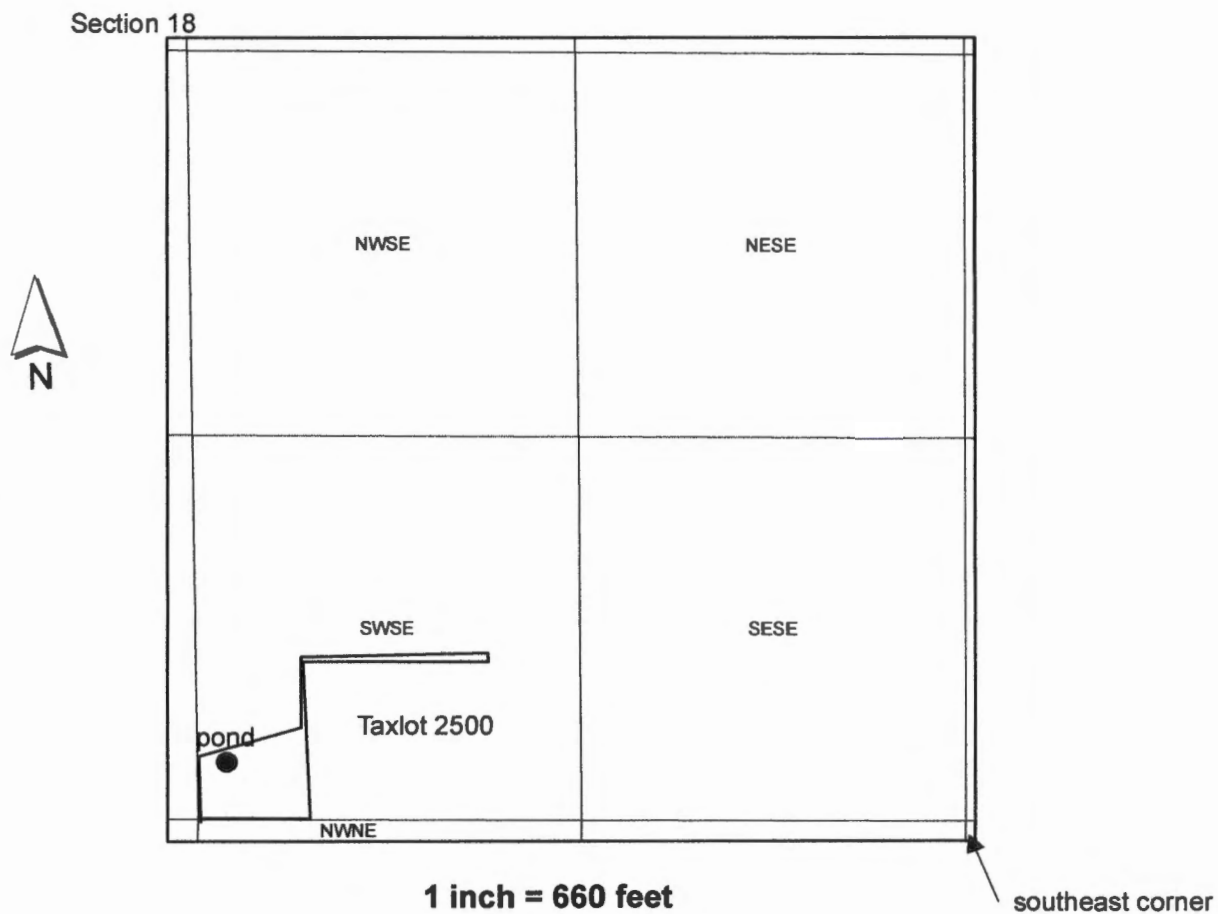

The pond is located 197 ft north and 2534 ft west of the southeast corner of Section 18.

RECEIVED BY OWRD RECEIVED BY OWRD

JUL 11 2016

JUN 23 2016

SALEM, OR

SALEM, OR

R-0805E



RECEIVED BY OWRD

RECEIVED BY OWRD

JUL 11 2016

JUN 23 2016

SALEM, OR

SALEM, OR

### Legend

#### Buildings

- PRIMARY
- SECONDARY
- Taxdots

#### Water (line)

- Class 1
- Class 2

200 0 200 400 Feet

The information on this map is furnished for general interest purposes only. This information is provided without warranties of any kind, express or implied, and it should not be used to support any purchase or other investment. Neither Josephine County, Cave Junction, nor Grants Pass will accept responsibility for any errors or inaccuracies in the depicted information.



Scale  
1:2400



### Locator Map

