


12-880264

This map was prepared for assessment purposes only.

SECTION 1 T5S R3E WM
CLACKAMAS COUNTY
1"=400'

57

1
N

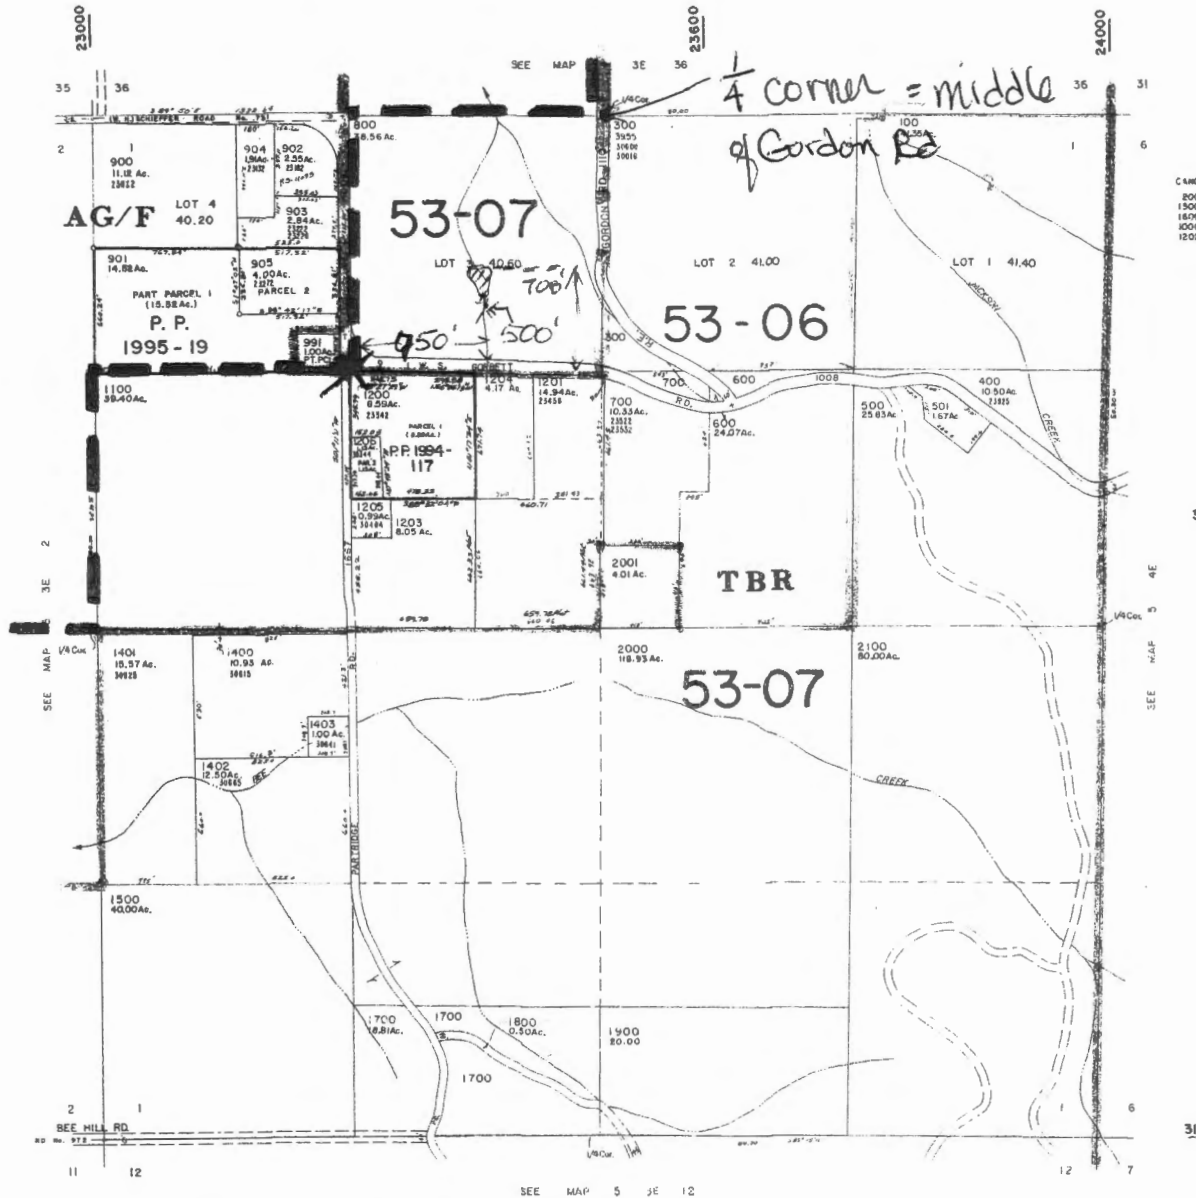

RECEIVED

JUL 20 2016

WATER RESOURCES DEPT
SALEM, OREGON

T5S R3E Sect 1 NENW tax lot 800

Government land survey corner shows at NW Corner of the property

LN 1/4


$$1'' = 200'$$

T5S R3E Sect. 1

NENW WM TAX LOT #800

see attached survey of N^{1/4} Corner (Clackamas Cnty Surveyors office says it's the Government Survey Corner) N^{1/4}
* Center of Pond (Good's Wood Pond) is 800' S of said N^{1/4} Corner
675' W of said N^{1/4} Corner
L N^{1/4}