


T. 1 S. R. 45 E. W.M.

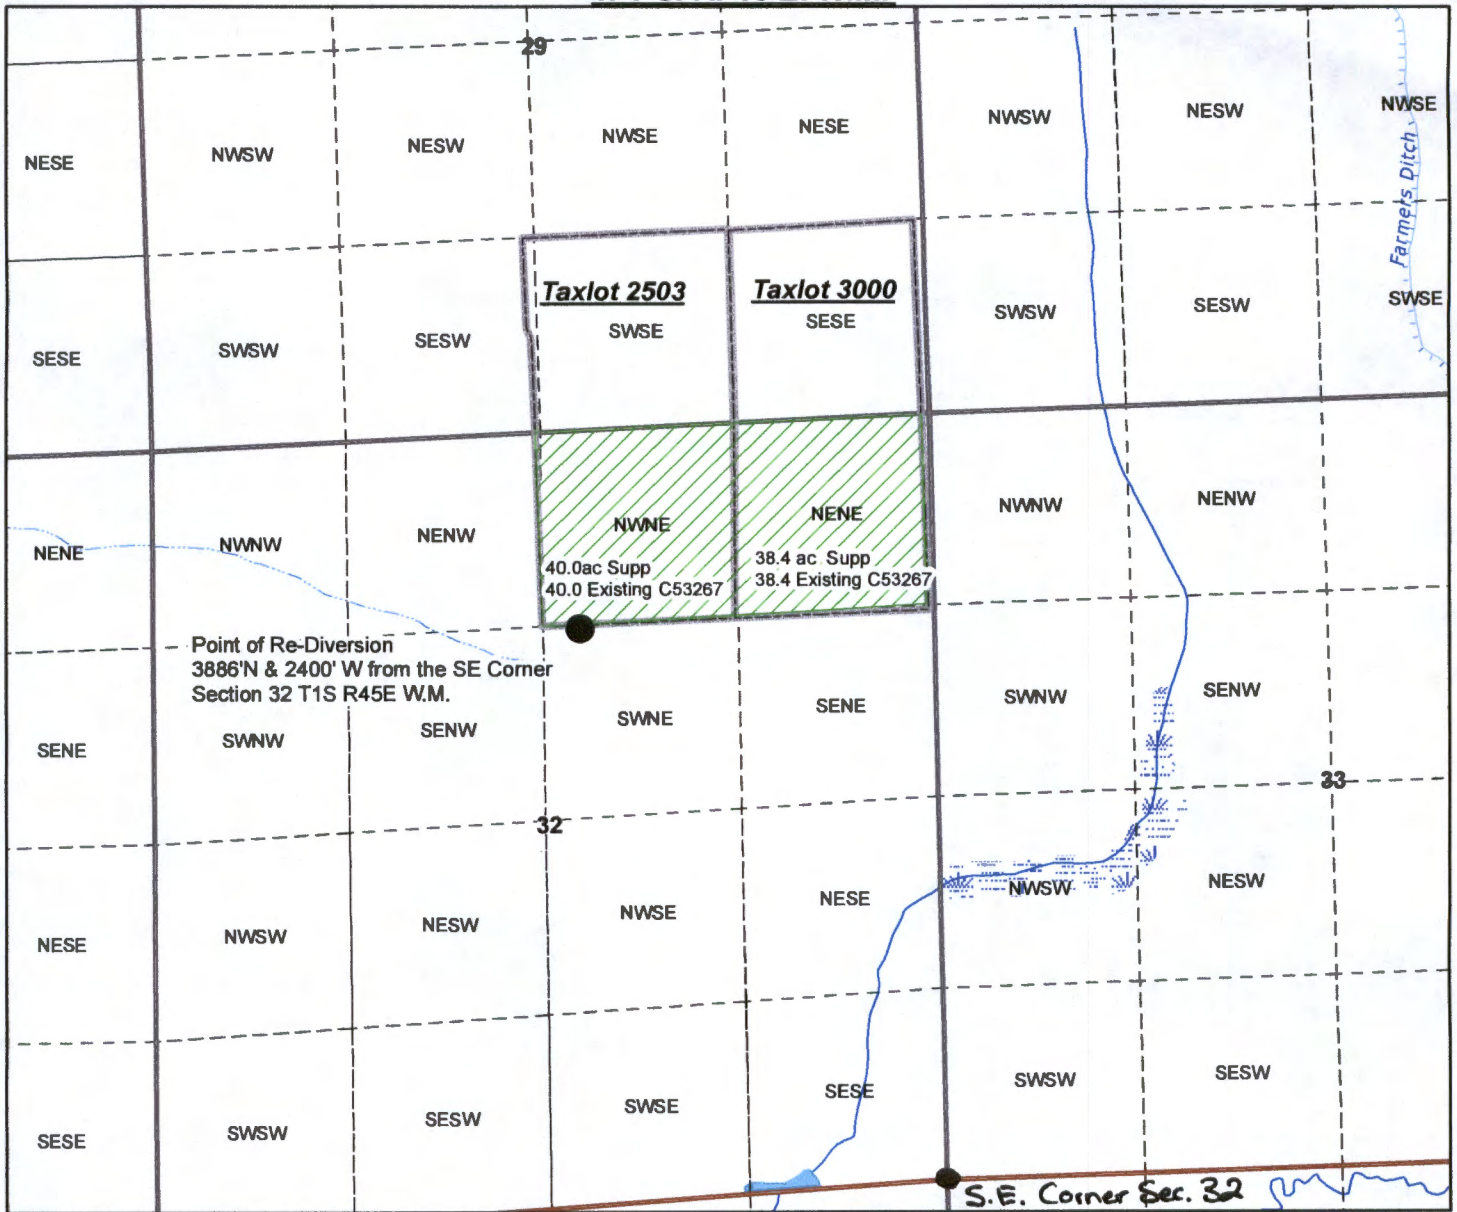

Dwain Beck Stored Water Application Map
Source Wallowa Lake - Point of Rediversion Farmers Ditch



Source of Water: Wallowa Lake

SCALE: 1"= 1/4mi



RECEIVED BY OWRD RECEIVED BY OWRD

JUL 22 2016

JUL 11 2016

SALEM, OR

SALEM, OR

Legend

- Proposed Supp Irrigation 78.4 ac
- TL 2503 & TL 3000 - Beck
- Townships
- Sections
- Quarter quarters

Map Disclaimer:
 This product is for informational purposes and may not have been prepared for, or be suitable for legal, engineering, or surveying purposes. Users of this information should review or consult the primary data and information sources to ascertain the usability of the information. This map is not intended to display property lines

C:\Data\GIS_Data\Applications\Stored Water\2016_Beck.mxd

5-00265

SALEM, OR

JUL 11 2016

RECEIVED BY OWRD

T. 1S., R. 45E., W.M.


FINAL PROOF SURVEY
UNDER

APPL. 52559 PER. 37507

IN NAME OF

LEONARD MELVILLE

SURVEYED 8-16-78, BY R.F. Barwin

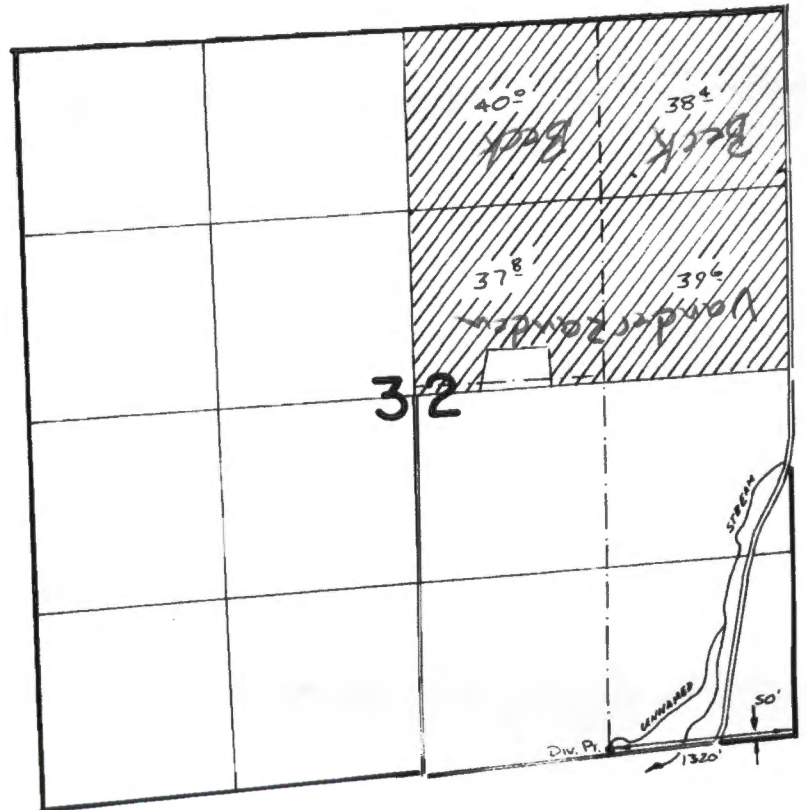

RECEIVED BY OWRD

JUL 22 2016

SALEM, OR