

588260

T 20 S, R 2 W Sec 6 SW 1/4, SW 1/4

TL 2400

scale 1" = 400'

POD

700' N

1050' E

SW Corner
section 6




N 2° 50' E

41.65

~~2300~~

Oak
Pond

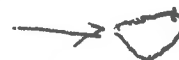

4.48 Ac

1.14 Ac

20.78 CH

2500

41.58 AC

LOT 1

RECEIVED

JUL 11 2016

WATER RESOURCES DEPT
SALEM, OREGON

RECEIVED BY OWRD

JUL 25 2016

SALEM, OR



Oregon Water Resources Department Water Rights Mapping Tool

Main Help
725 Summer St NE, Sal
Return Contact Us

Search

Identify
Non-Water
Right
Features


Tools

Layers

Water
Water
Water
Water
Water
Admir
Rules
Surfac
Hydro
River
Trans
Stream
PODs
PLSS

< >

Print

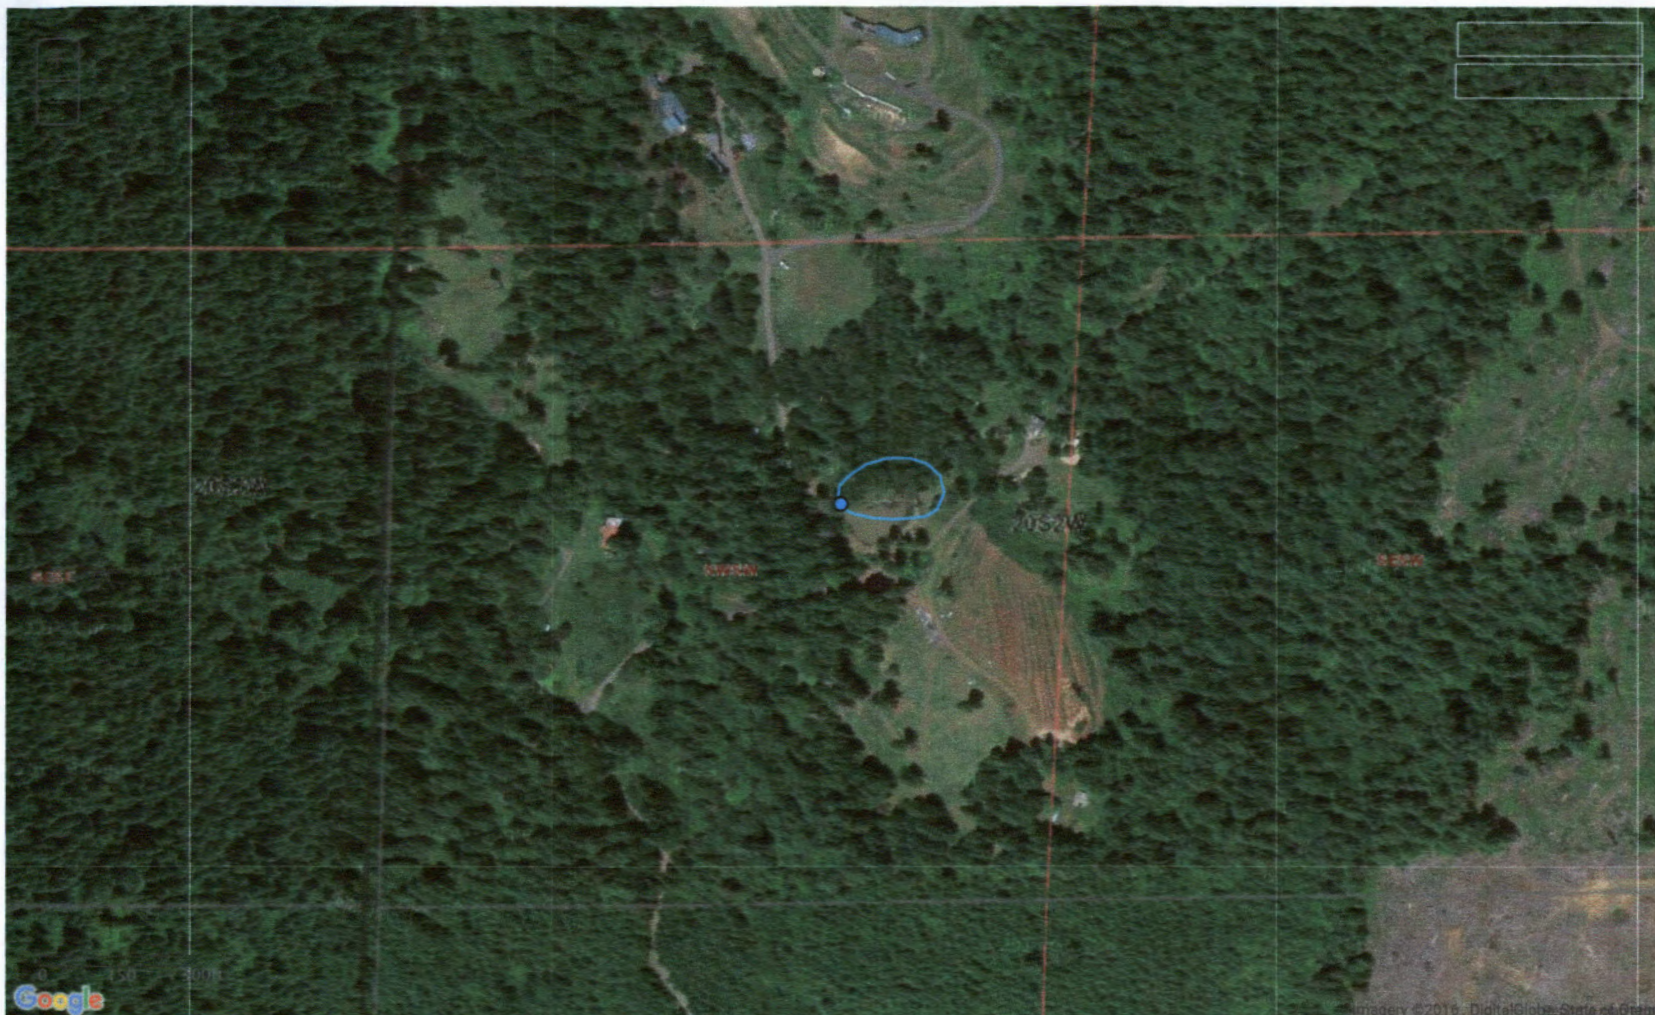

POD POU

All Fields Search...

ID (select)	WDRS	Zoom	Water Right	Water Type	First Name	Last Name	Company	Priority	Date	Supp	Duty	Date off	Date
-------------	------	------	-------------	------------	------------	-----------	---------	----------	------	------	------	----------	------

RECEIVED BY OWRD

JUL 25 2016

http://apps.wrd.state.or.us/apps/gis/wr/Default.aspx?snp_id=163927
SALEM, OR

RECEIVED

JUL 11 2016

WATER RESOURCES DEPT
SALEM, OREGON

3/24/2016

97285