


S. 20, T. 11 S., R. 1 W.

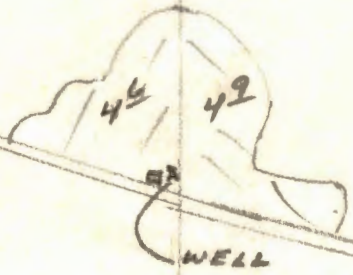

20 21

29 28

RECEIVED  
JUL 23 1958  
STATE ENGINEER  
SALEM, OREGON