

300 Ellsworth Street S.W.
Albany, OR 97321
928-3368

THIS MAP IS PROVIDED SOLELY
FOR THE PURPOSE OF ASSIST-
ING IN THE LOCATION OF THE
PROPERTY. THE COMPANY ASS-
UMES NO LIABILITY FOR VARIA-
TIONS, IF ANY, IN DIMENSIONS
OR LOCATIONS REPRESENTED BY
AN AERIAL PHOTOGRAPH.

ORDER NO. 68334L
95-03E-35-2400

B.P.A. Easement

2400
80.00A

129-5



POND

SALEM, OR

JUL 28 2016

RECEIVED BY OWRD

2300
80 00A


1" = 400'

App No R-85855 permit no R-13886

RECEIVED

APR 28 2003

WATER RESOURCES DEPT.
SALEM, OREGON

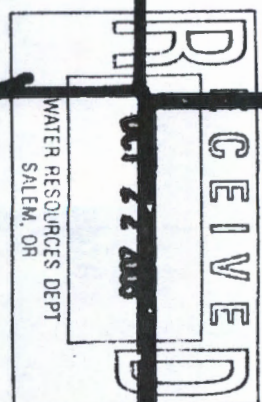

See Map 9 3E 36

39830 Mad Creek Rd. Gates, OR 97346 pond map



Pond length (East to West) = 430 ft.
 Pond length (North to South) = 280 ft.
 Pond Average Depth = 6 ft.

Distance from West Property Line= 120 ft.
 Distance from South Property Line= 320 ft.
 Pond

Property Lines

Earth Dam

RECEIVED BY OWRD

N

S

RECEIVED BY OWRD

APR 04 2016

MAR 03 2016

RECEIVED BY OWI

SALEM, OR

SALEM, OR

R-88270

JUL 28 2016

SALEM, OR