


AND

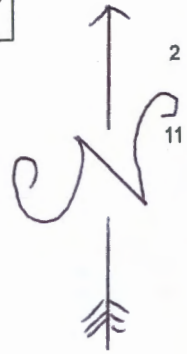

Well is -  
will be:

580' S and  
3025' E of  
NW cor Sec 12

SEE MAP 12 4W 11

SLY S.E. COR.  
JAMES COCHRAN  
D.L.C. NO.89

N.W. COR.  
THOMAS BOGGS  
D.L.C. NO.73

LOT 3  
8.09 A

S.W. COR.  
DAVID SETTLEMIRE  
D.L.C. NO.63

1100  
100.08 AC.

1102  
16.28 AC.

LOT 4  
11.40 A

1801  
48.93 AC.

1000  
5.84 AC.

900  
1.99 AC.

1400  
94.93 AC.

LOT 5  
11.40 A

1802  
19.24 AC.

PARCEL 1

P.P.  
2010

80  
21.17 AC.

C.S. 25309

TAX LOT 800

SECTION 12 T.12S. R.4W. W.M  
Linn County

1"=600'

SEE MAP

12 4W 12AB

SEE MAP 12S 41

SEE M.

12 4

LOT 6  
22.62 A

N.E. COR.  
THOMAS BOGGS  
D.L.C. NO.73

RECEIVED BY OWRD

JUL 18 2016

SALEM, OR

RECEIVED BY OWRD

AUG 01 2016

SALEM, OR

G-1015