


APPLICATION MAP FOR SUPPLEMENTAL WATER

BERT + GLENDA BOULER

T.39S., R.3W., W.M.

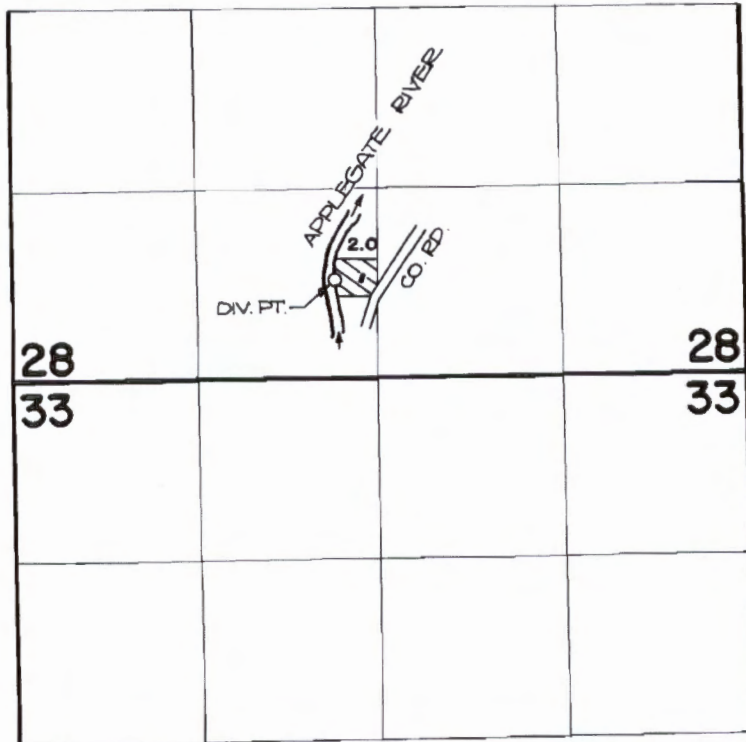

RECEIVED BY OWRD

JUL 13 2016

SALEM, OR

THE DIVERSION POINT IS LOCATED 600' N. AND 510' W FROM THE S. 1/4 CORNER OF SECTION 28.

1 INCH = 1/320 FT

FINAL PROOF SURVEY UNDER

Application No. 57489.. Permit No. 43265.....
IN NAME OF

JOHN AND/OR JOANNE T. RETZLAFF

Surveyed JULY...14.. 1983., by ..B.. JAMES.....

RECEIVED BY OWRD

AUG 04 2016

SALEM, OR

39 3W 28

TOWN SHIP RANGE SECTION
THIS SKETCH IS FOR LOCATION PURPOSES ONLY. NUMBERS ON SKETCH ARE COMPANY NUMBERS AND NO LIABILITY IS ASSUMED FOR VARIATIONS DISCLOSED BY SURVEY OR COUNTY RECORDS.

49-46

