


Water Right Application
James Rose and Thomas Rose
NW 1/4 Section 14 T.26S. R.4W. W.M.
Douglas County
Scale 1" = 500'

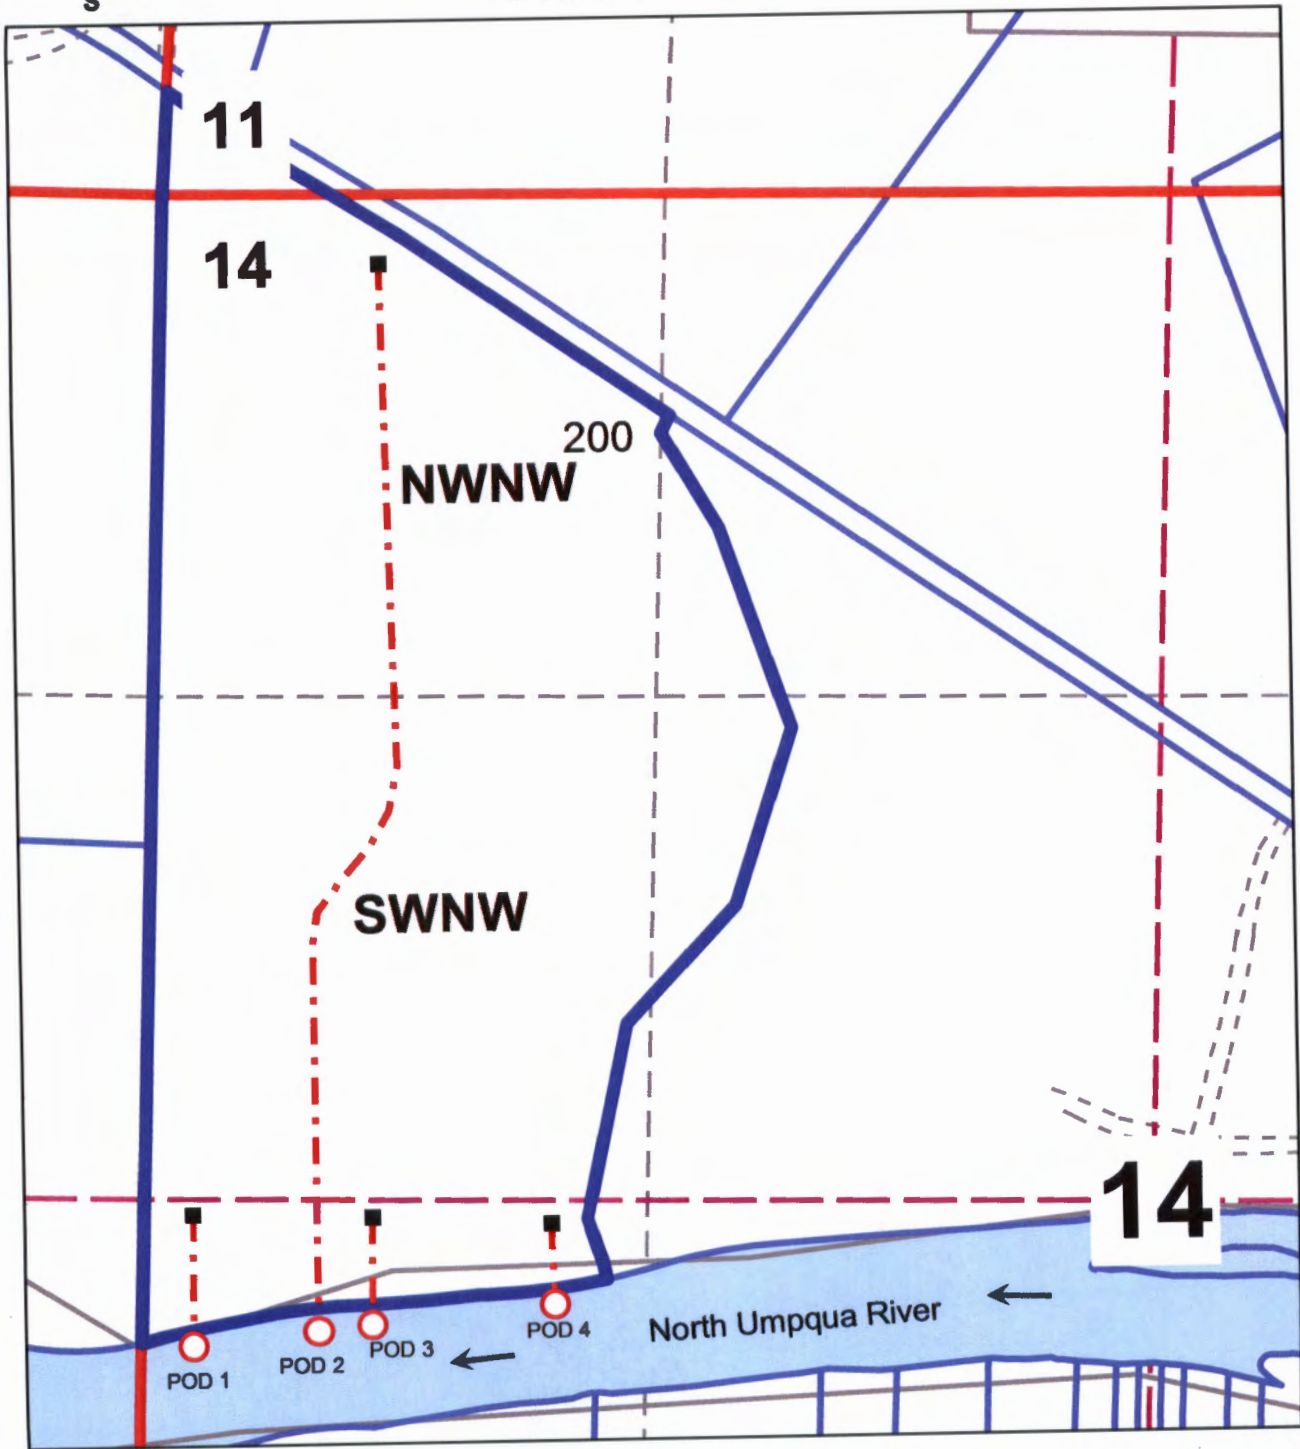

Point of Diversion 1 is 380' South and 140' East
Point of Diversion 2 is 375' South and 460' East
Point of Diversion 3 is 370' South and 600' East
Point of Diversion 4 is 325' South and 1070' East
all from the West 1/4 Section Corner.

RECEIVED BY OWRD

AUG 05 2016

SALEM, OR

S-88273