


T37S R5W Southeast Quarter Section 28

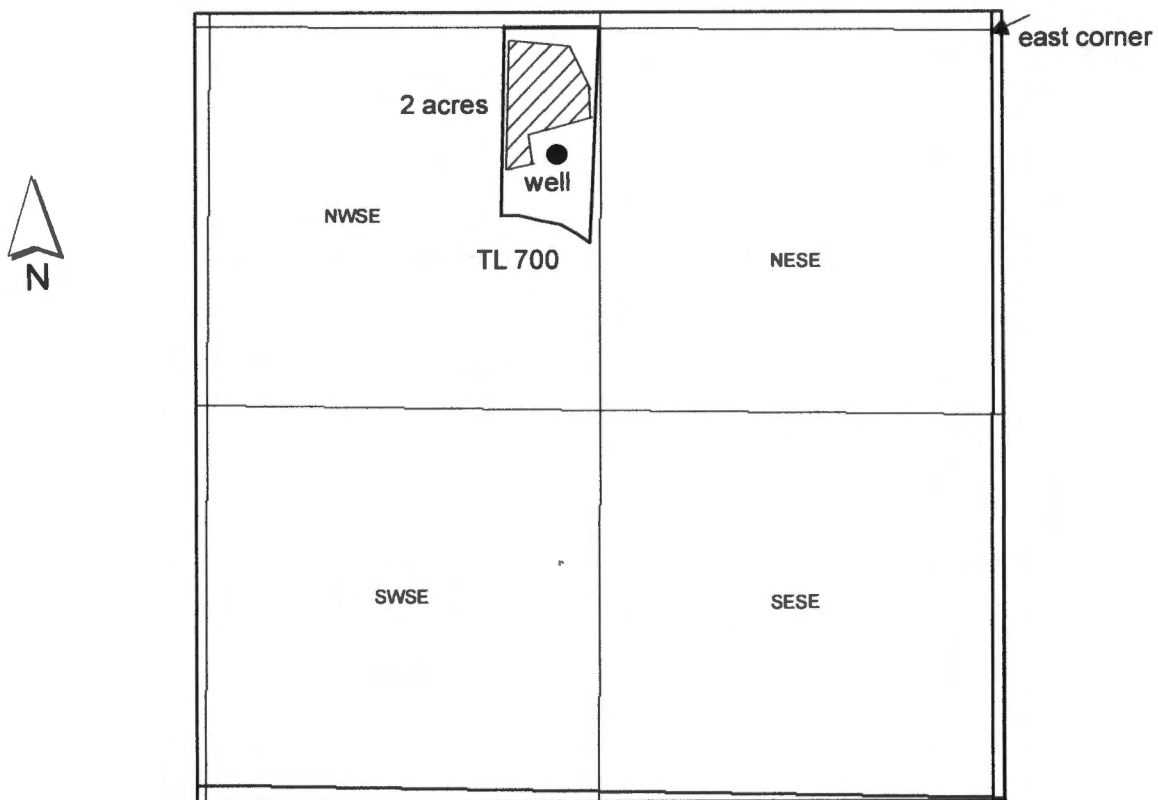

1 inch = 660 feet

The well is located approximately 442 ft south and 1486 ft west of the east corner, according to the landowner.

RECEIVED BY OWRD

AUG 17 2016

SALEM, OR

G-18570