


T39S R8W Southwest Quarter Section 29

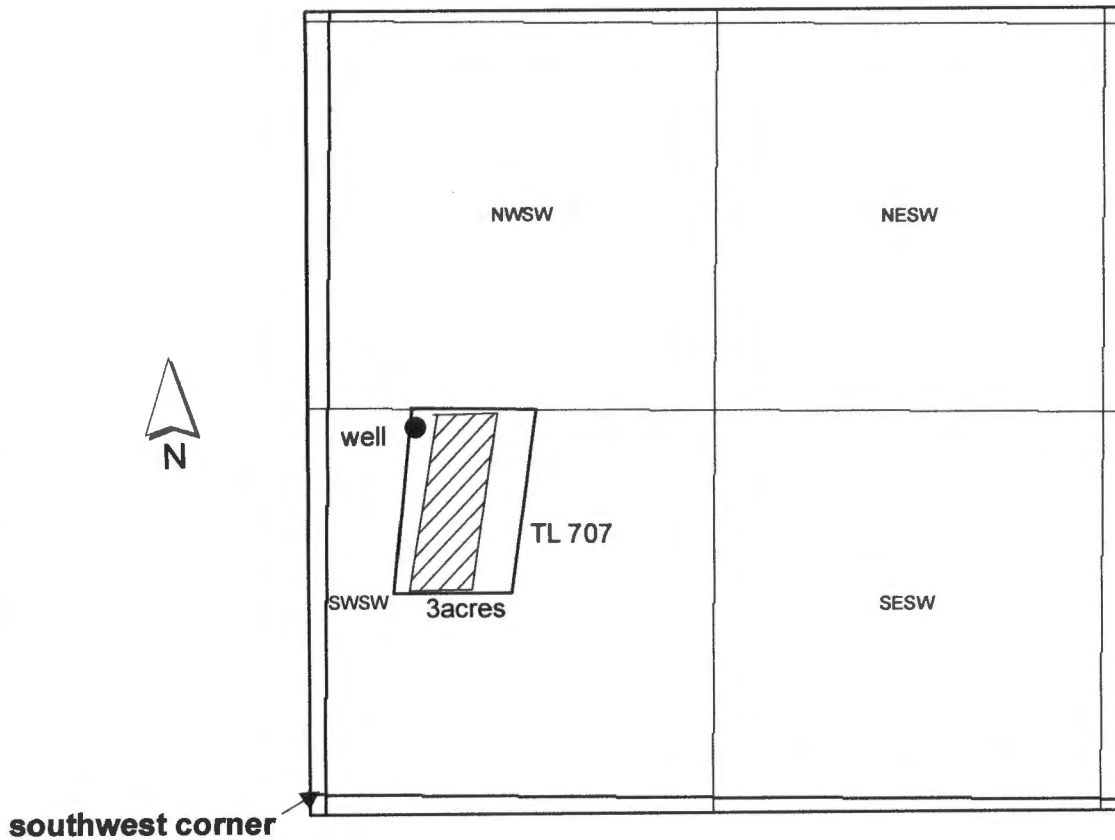

1 inch = 660 feet

The well is located approximately 303 ft east and 1272 ft north from the southwest corner of Section 29, according to the landowner.

RECEIVED BY OWRD

AUG 23 2016

SALEM, OR

G-18373