


RECEIVED BY OWRD

AUG 24 2016

SALEM, OR

Taylor Westside Ranches Inc. 36 S. 24 E.

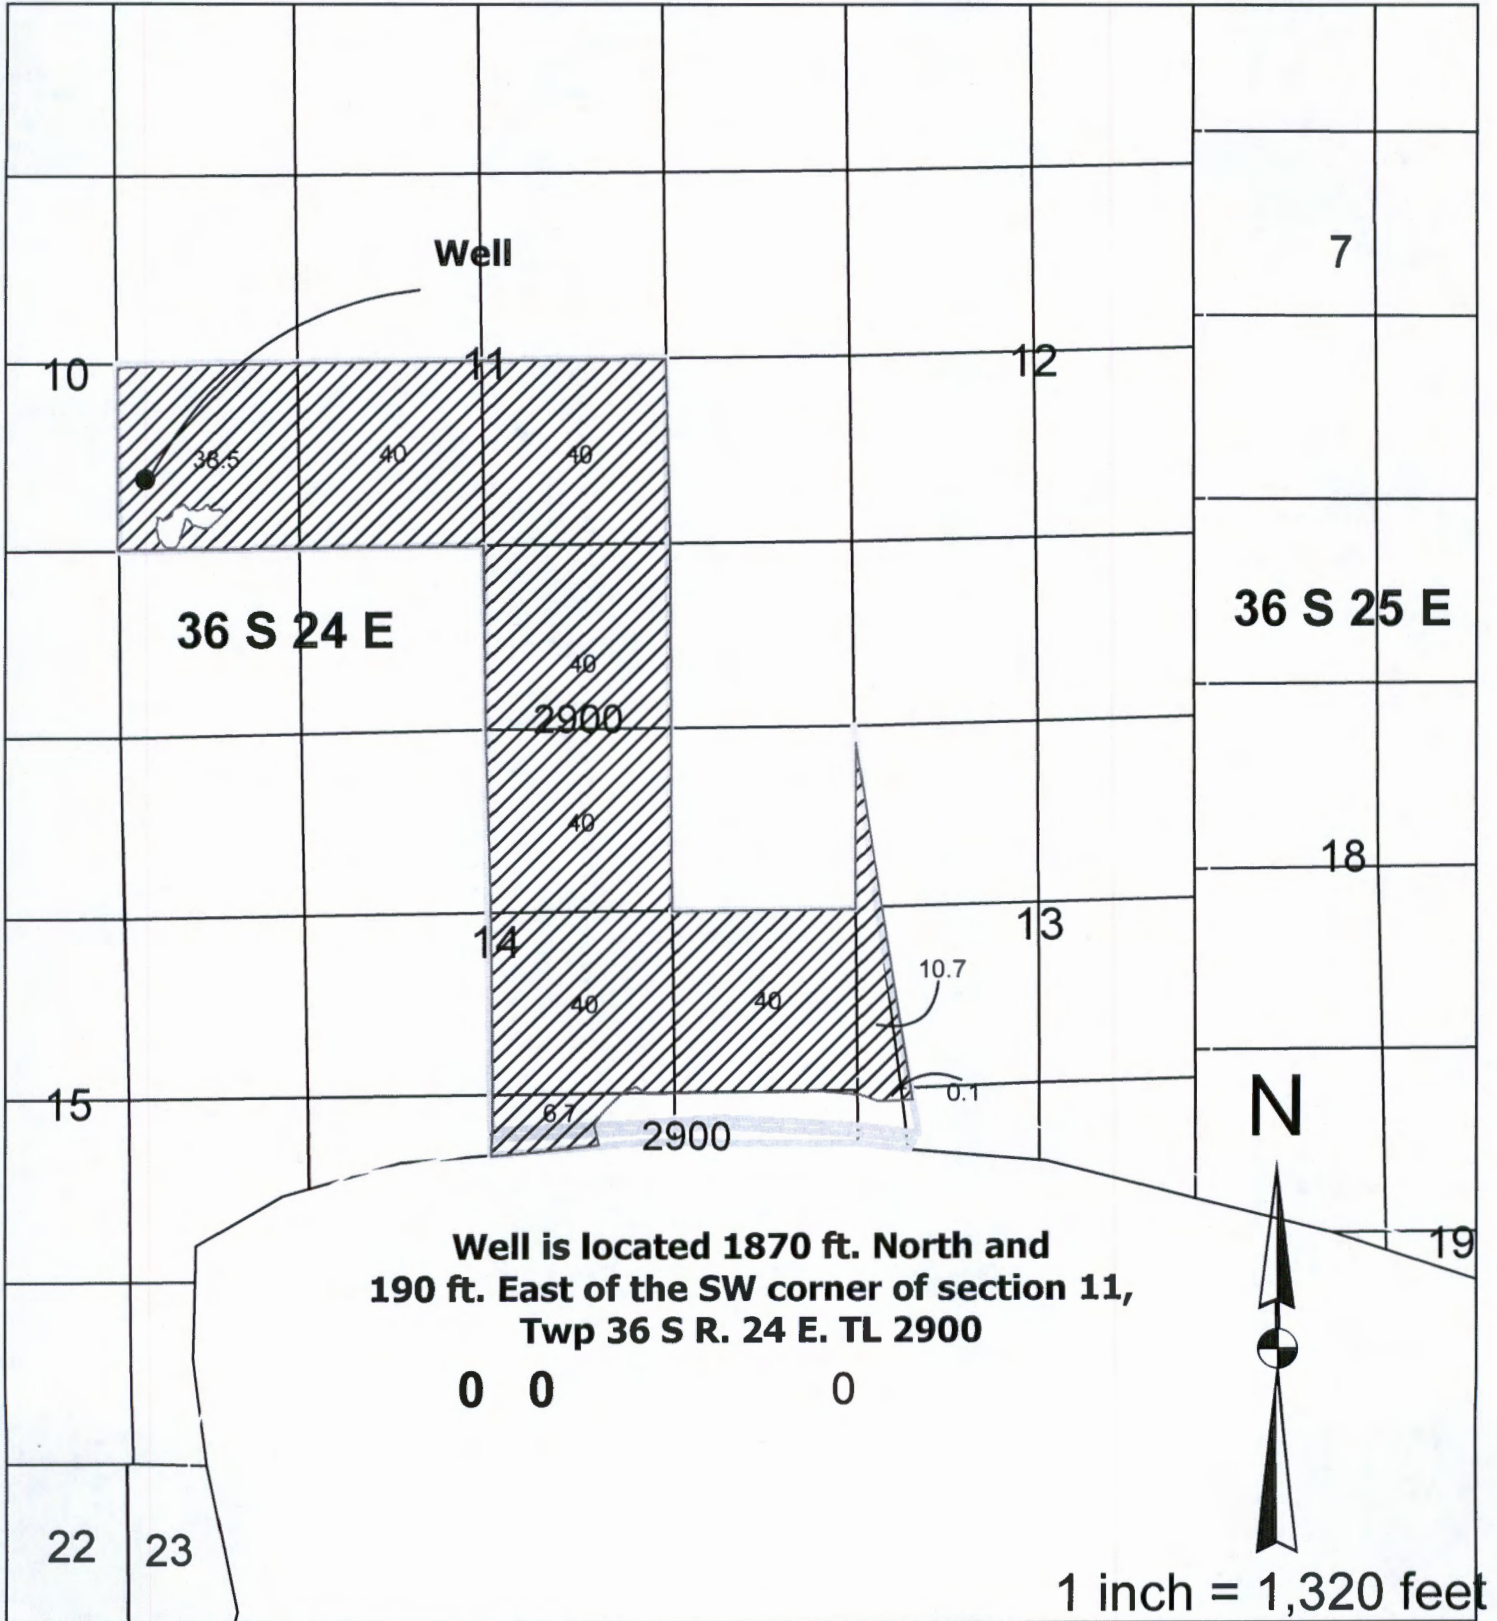

G-18374