


T36S R7W Northeast Quarter and North Half Southeast Quarter Section 2

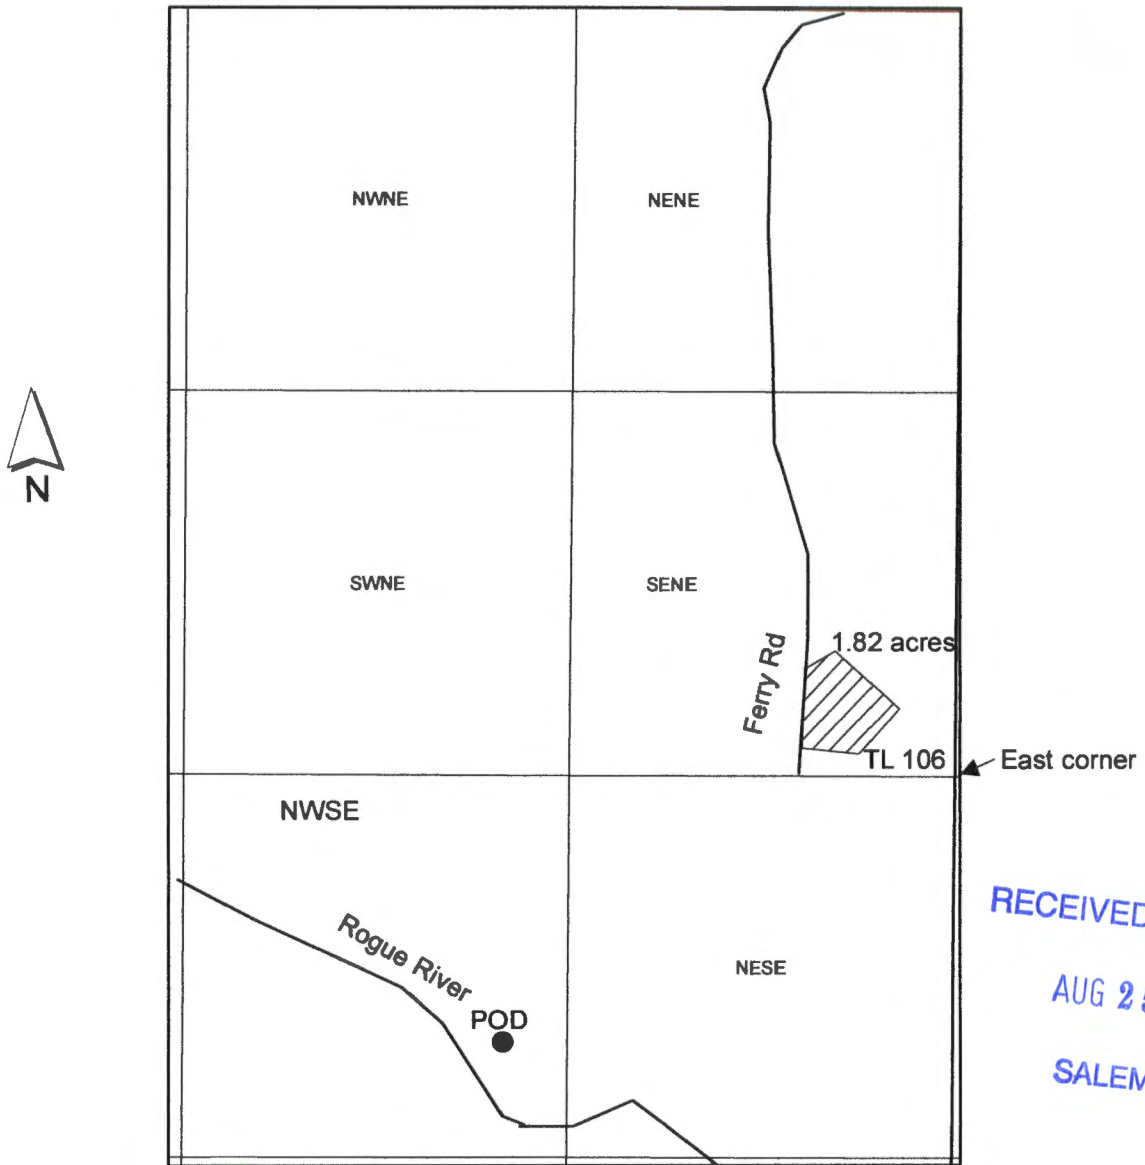

RECEIVED BY OWRD
AUG 25 2016
SALEM, OR


1 inch = 660 feet

The Point of diversion is located 945 ft south and 1530 ft west from the east corner of Section 2. (See Application S-69539).

S-88277

EXHIBIT A

T. 36 S. R. 7 W. SECTION 2 W.M.

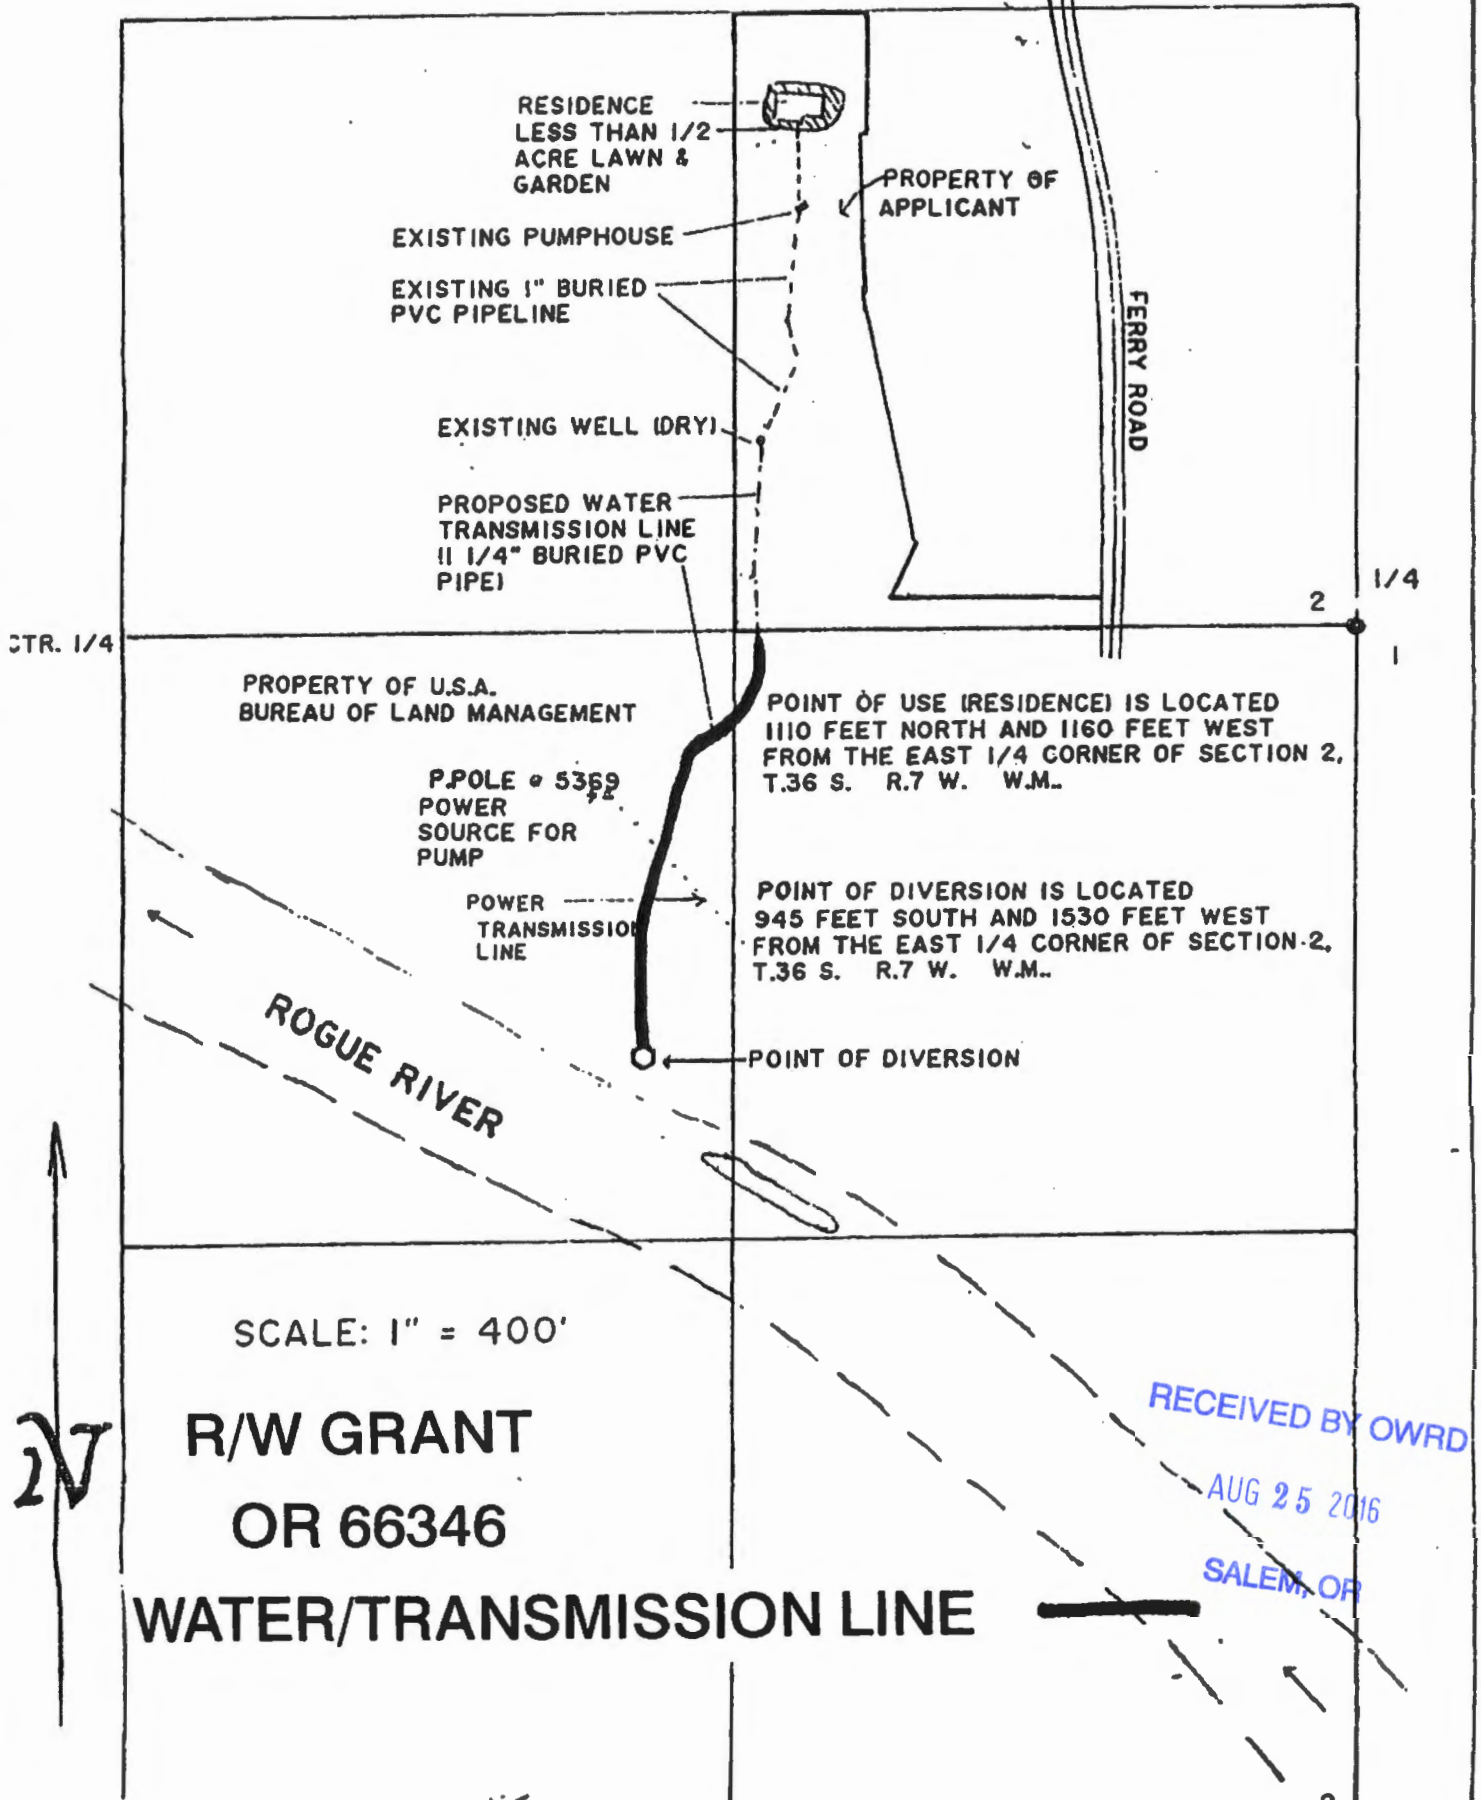

boreed water pipeline along the property line border of Lou Scogaro's property
burrowed under Ferry Rd, across the bottom of "1011" driveway and then up the
right side of the thin driveway granite dirt driveway, crossing under the driveway up at
the water holding tank stand to connect to the steel tank.



Imagery ©2016 Google, Map data ©2016 Google 100 ft

DAVID SWIECICKI
1010 E. BOBIER DR., SP #107
VISTA, CA 92084-3917

RECEIVED BY OWRD

AUG 25 2016

SALEM, OR

5-88277



RECEIVED BY OWNER
AUG 25 20
SALEM

LOW S.

Ferry Rd Ferry Rd Ferry Rd Ferry Rd

1011 Ferry Road

Google

5-88277



Grants Pass, Oregon
Street View - Jun 2012

Image capture: Jun 2012 © 2016 Google

RECEIVED BY OWRD

AUG 25 2016

SALEM, OR

5-88277



Grants Pass, Oregon
Street View - Jun 2012

Image capture: Jun 2012 © 2016 Google

RECEIVED BY OWRD

AUG 25 2016

SALEM, OR

5-08277



Grants Pass, Oregon
Street View - Jun 2012

Image capture: Jun 2012 © 2016 Google

772005