
T36S R7W Northeast Quarter and North Half Southeast Quarter Section 2

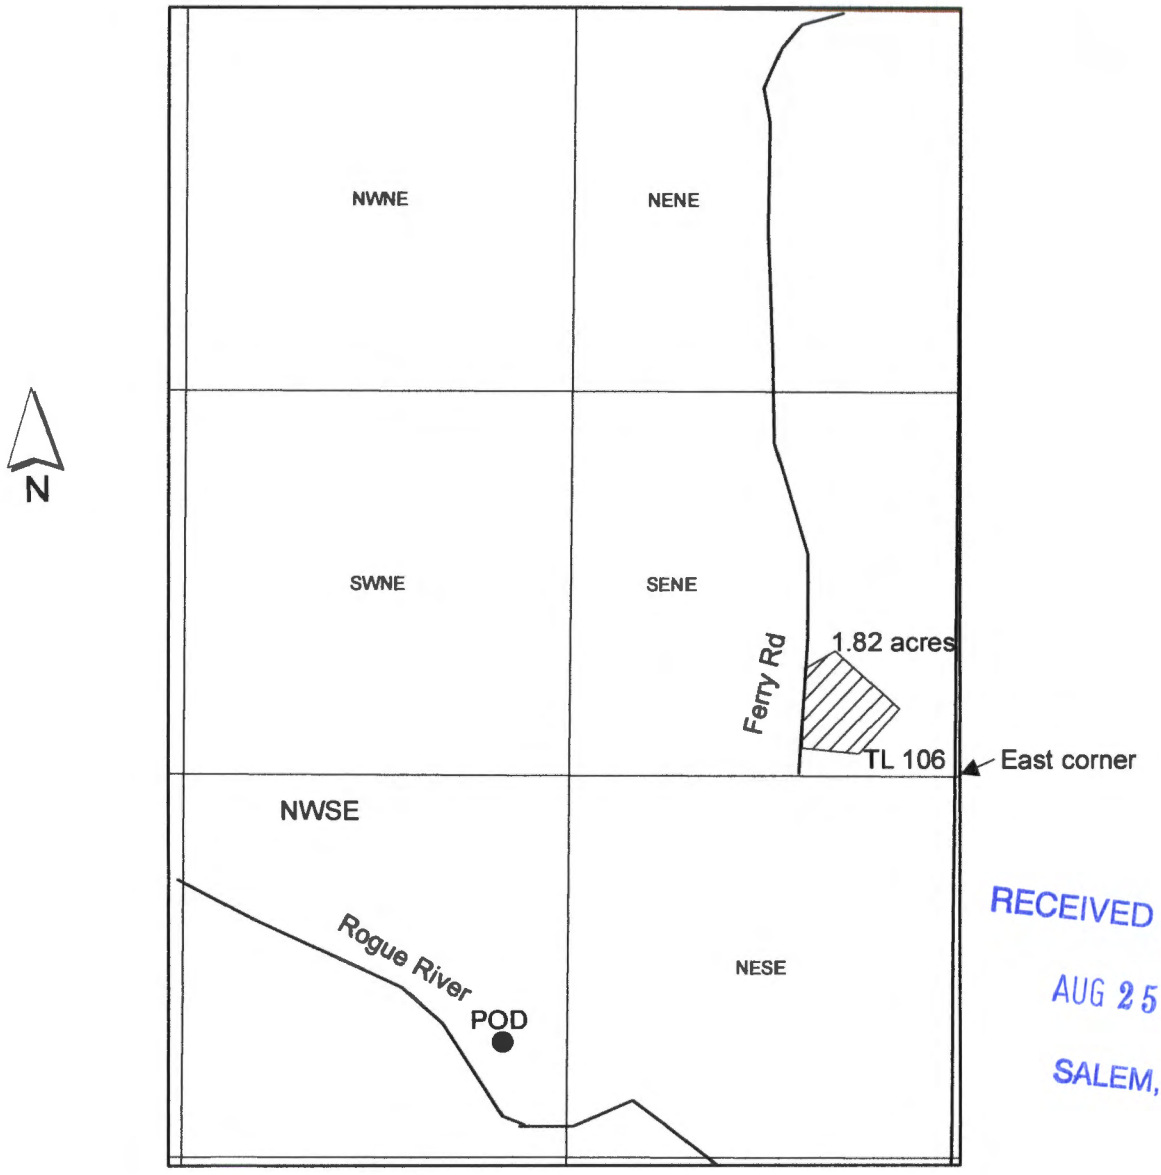


1 inch = 660 feet

The Point of diversion is located 945 ft south and 1530 ft west from the east corner of Section 2. (See Application S-69539).

S-88277

RECEIVED BY OWRD
AUG 25 2016
SALEM, OR

EXHIBIT A

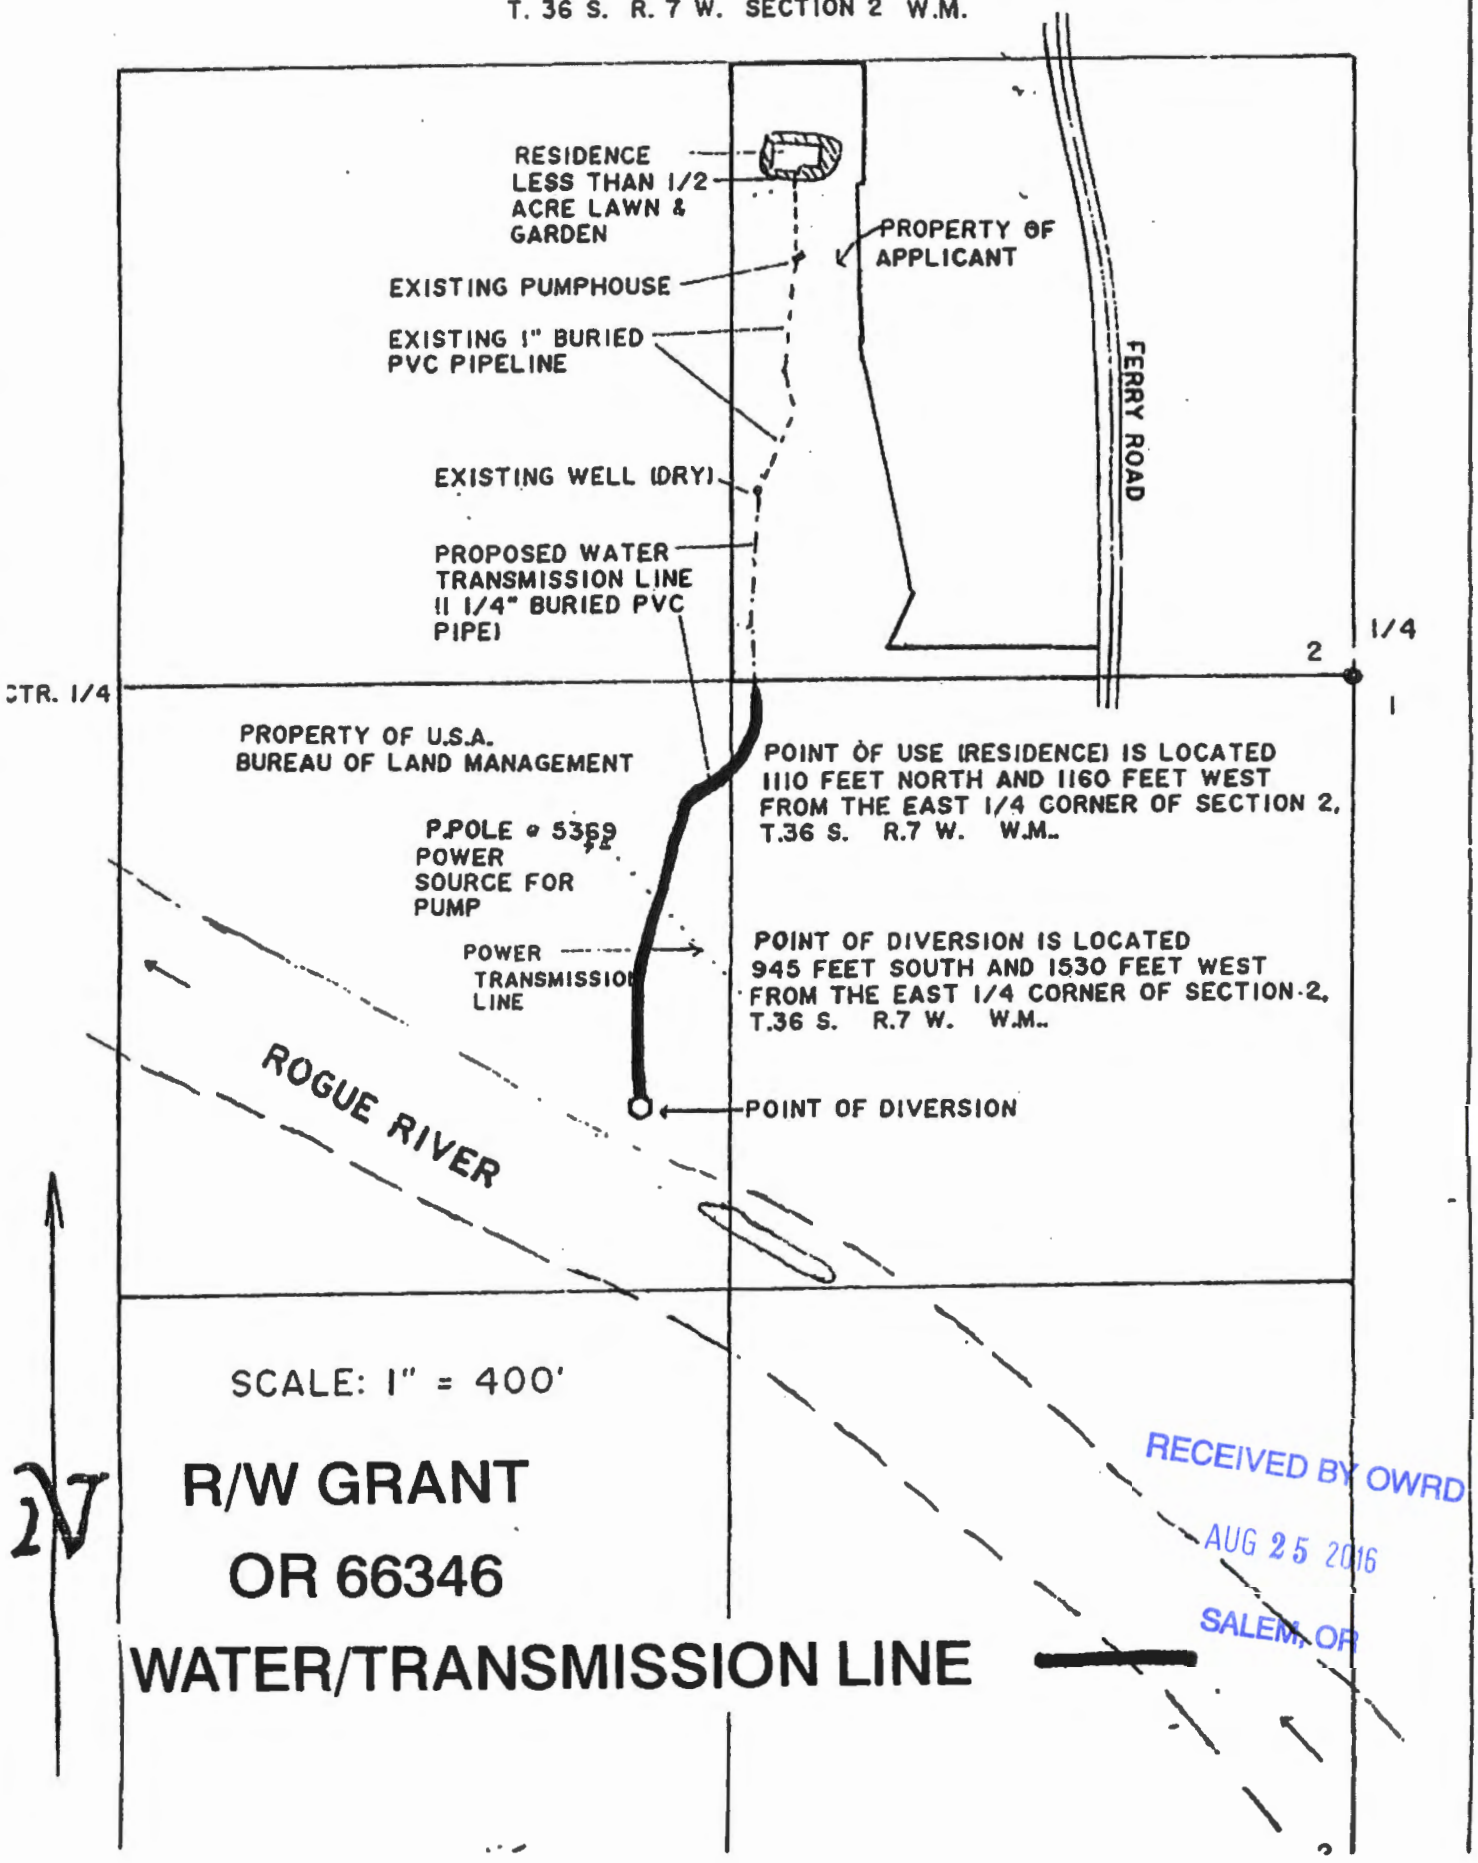

RECEIVED BY OWRD
AUG 25 2016
SALEM, OR

buried water pipeline along the property line border of Lou Scapuro's property
burrowed under Ferry Rd, across the bottom of "1011" driveway and then up the right side of the then decomposed granite dirt driveway, crossing under the driveway up at the water holding tank shed to connect to the shed tank.


Google Maps 1011 Ferry Rd



Imagery ©2016 Google, Map data ©2016 Google 100 ft

DAVID SWIECICKI
1010 E. BOBIER DR., SP #107
VISTA, CA 92084-3917

RECEIVED BY OWRD
AUG 25 2016
SALEM, OR
S-88277

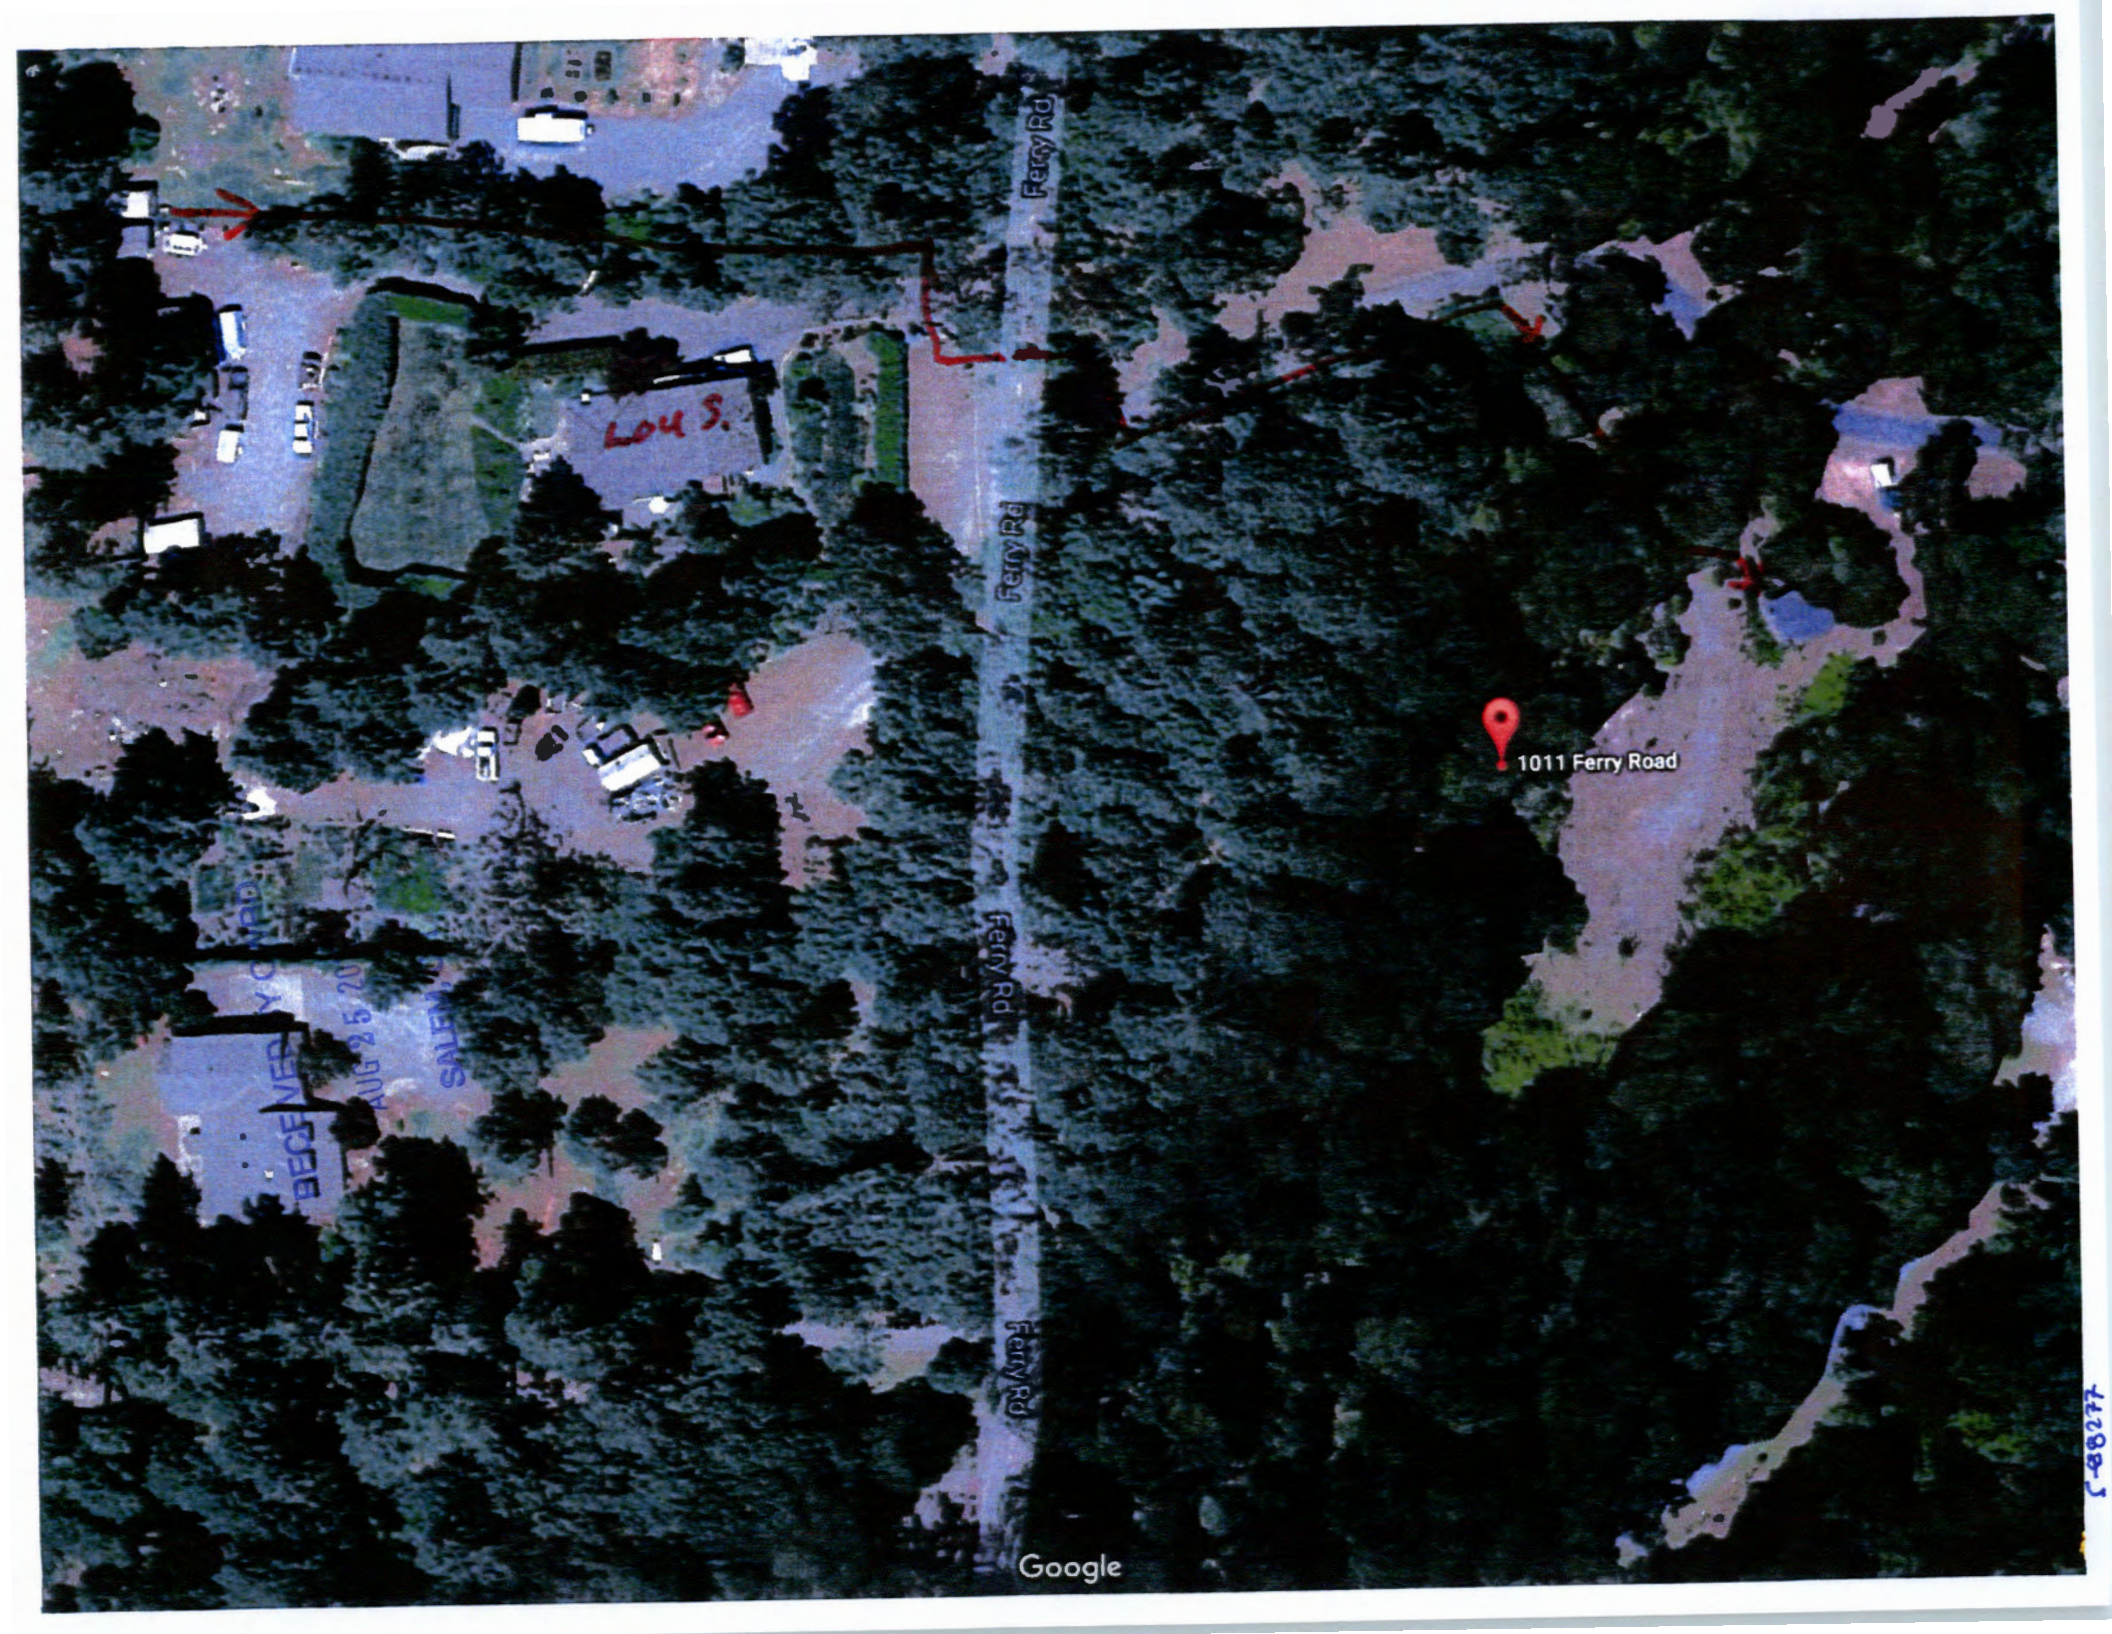
Ferry Rd
Ferry Rd
Ferry Rd
Ferry Rd
1011 Ferry Road
Google

Google Maps Ferry Rd



Image capture: Jun 2012 © 2016 Google

Grants Pass, Oregon

Street View - Jun 2012

RECEIVED BY OWRD
AUG 25 2016
SALEM, OR

S-88277

Google Maps Ferry Rd



Image capture: Jun 2012 © 2016 Google

Grants Pass, Oregon

Street View - Jun 2012

RECEIVED BY OWRD
AUG 25 2016
SALEM, OR
S-88174

Google Maps Ferry Rd



Image capture: Jun 2012 © 2016 Google

Grants Pass, Oregon

Street View - Jun 2012

S-00277