

SECTION 18 T15S R.11E.W.M.
DESCHUTES COUNTY
1"=400'



drop numbers 2/1

Application No. P-77104
Permit No.

RECEIVED

DEC 30 1994

WATER RES. SALEM, OREGON

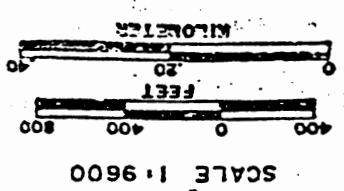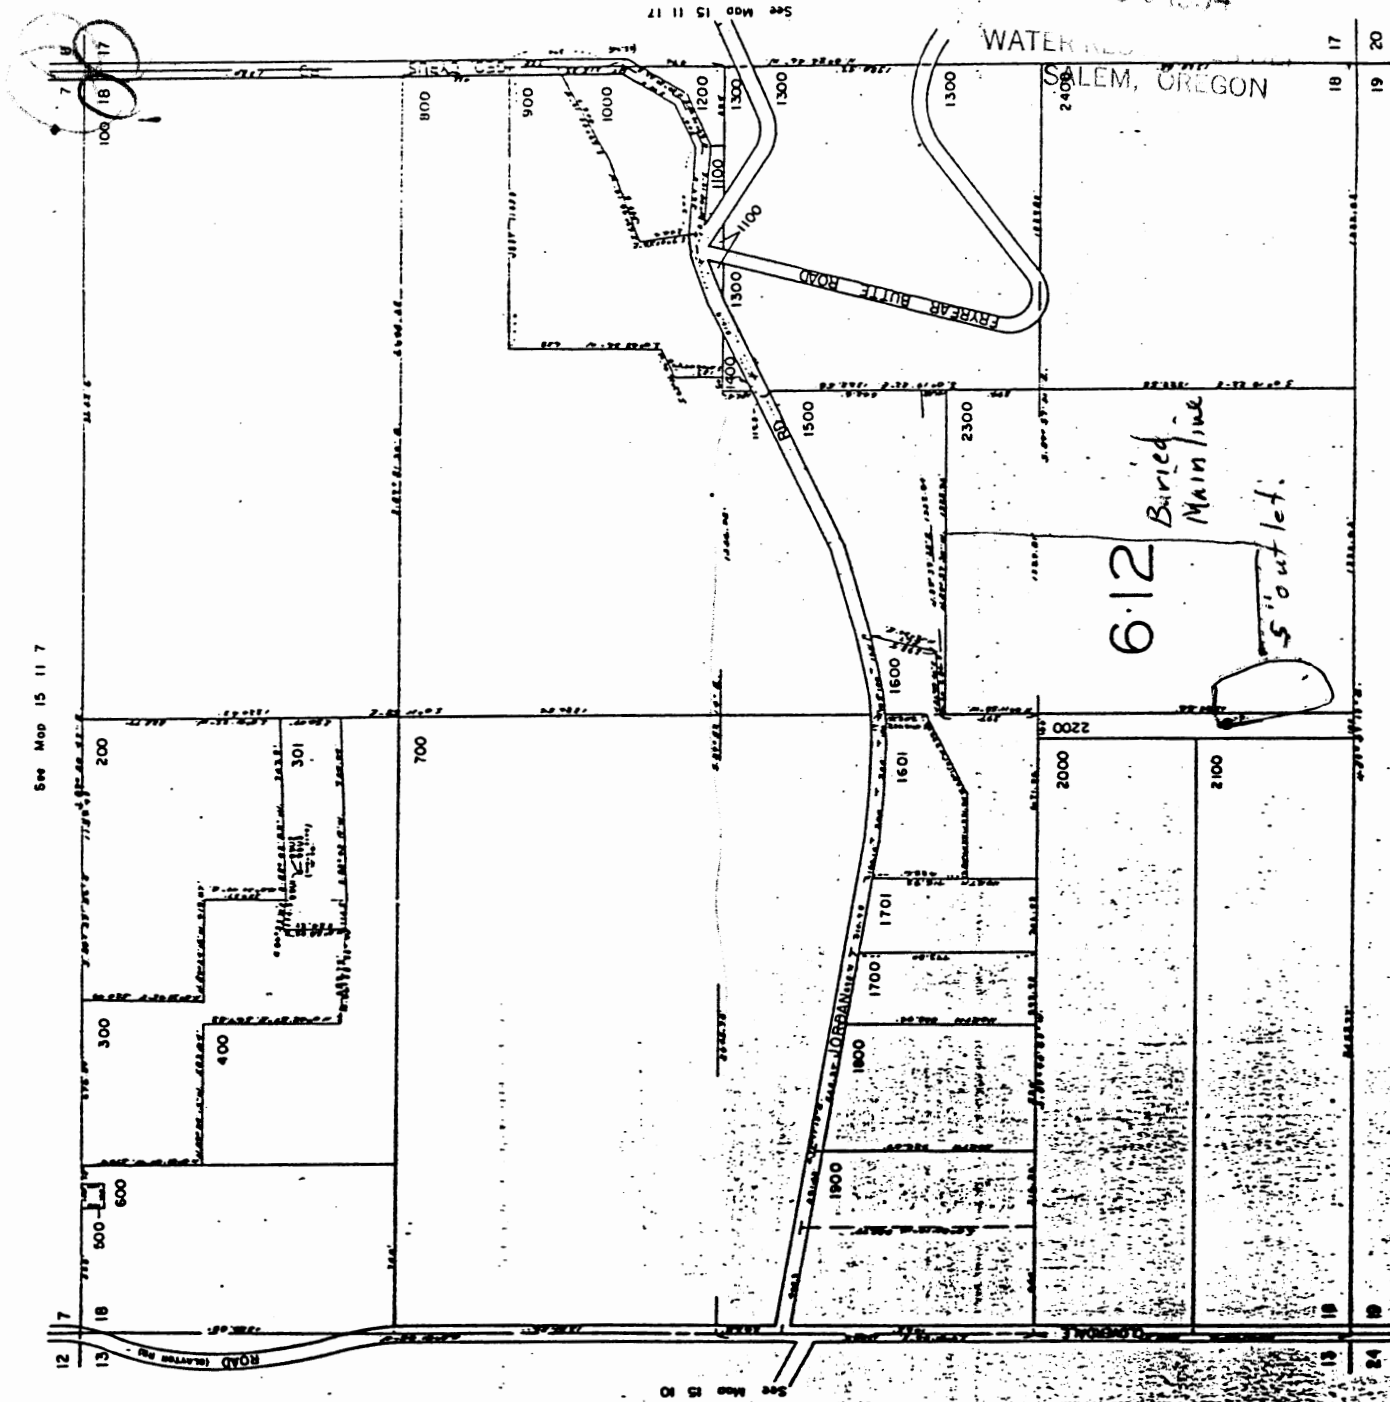

RECEIVED
DEC 09 1994
DEPT. OF WATER RESOURCES & UTILITIES