


T38S R5W Southeast Quarter Section 15

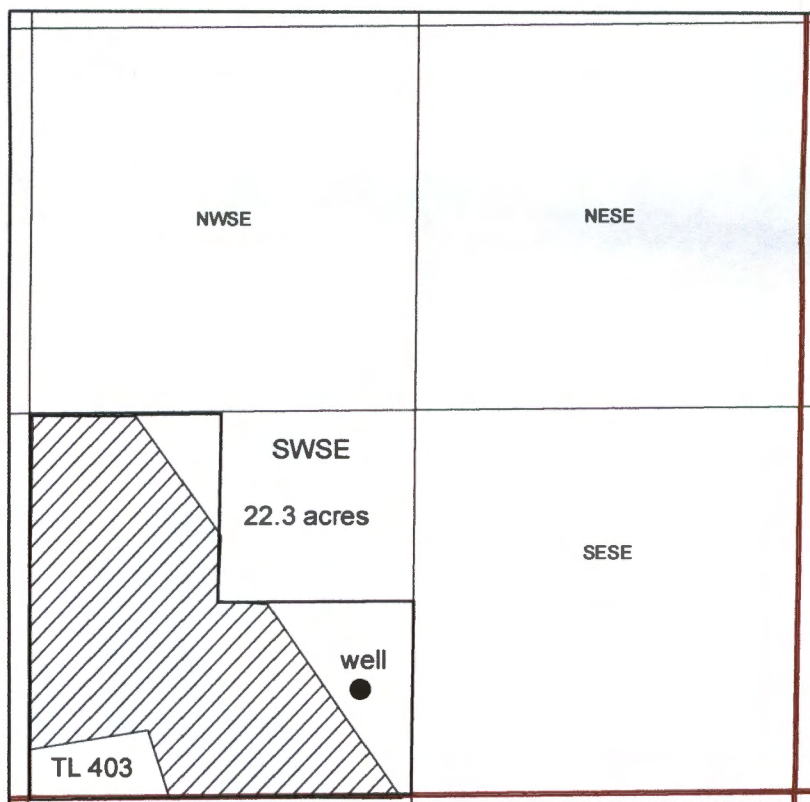

Southeast corner

1 inch = 660 feet

The well is located approximately 1491 ft north and 369 ft west from the southeast corner of Section 15, according to the landowner.

RECEIVED

SEP 08 2016

WATER RESOURCES DEPT
SALEM, OREGON

G-10370