


T16S, R5W Sec 18
TL 500

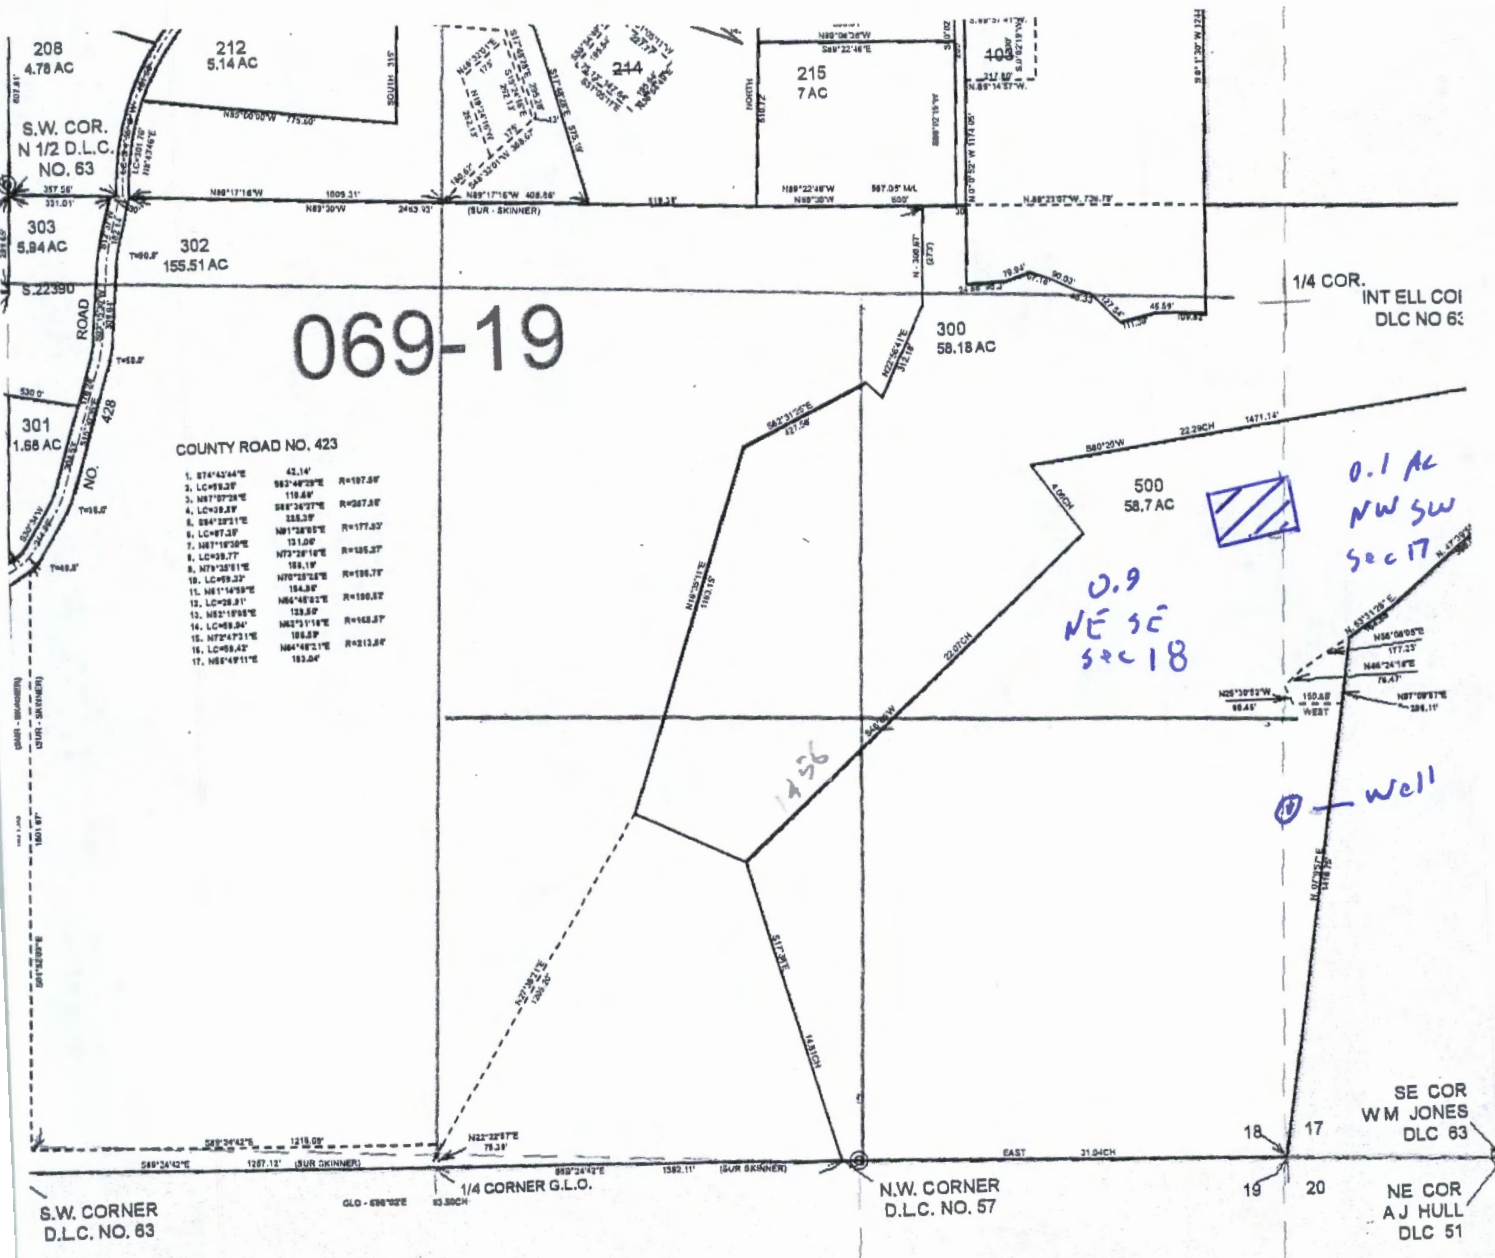

Scale 1" = 600'



Well in SW SW Sec 17

1080' N and
25' W of SW cor sec 17

RECEIVED BY OWRD

SEP 01 2016

SALEM, OR

G-10180

G-18785

1" = 400'

Kina Wiersma
25461 Hwy 36
Cheshire, OR 97419
541-554-4921
township 16 range 05
section 18
tax lot 00500

neighbors
house
800' to fence

Proposed 8' chainlink fence
Office 6' x 10' x 8'
proposed 20' x 48' x 9'
greenhouse
pond
parking
fence to pond 50'

Private Road

existing road private
and culvert

500
Septic
leachline
500' to fence
barns
Shops Shed
house
pump
Houses
Septic
tank
Well

SALEM, OR

SEP 01 2016

RECEIVED BY OWRD

Private Road

804

801

808

806

214

211

210

106

108

109

Chardonmay Way

Chardonmay Way

102 113

Sources: Esri, HERE, DeLorme, Intermap, increment P Corp., GEBCO, USGS, FAO, NPS, N
Japan, METI, Esri China (Hong Kong), swisstopo, MapmyIndia, © OpenStreetMap contributors

was derived from digital databases on the Lane
mation system. Care was taken in the creation
is". Lane County cannot accept any responsibility

N