



Township: 6S
Range: 6W
Section: 31



Applicant: Chris Rentzel / Agent: Ollie Collins

Application #: _____ Permit #: _____

RECEIVED
SEP 07 2016
OWRD

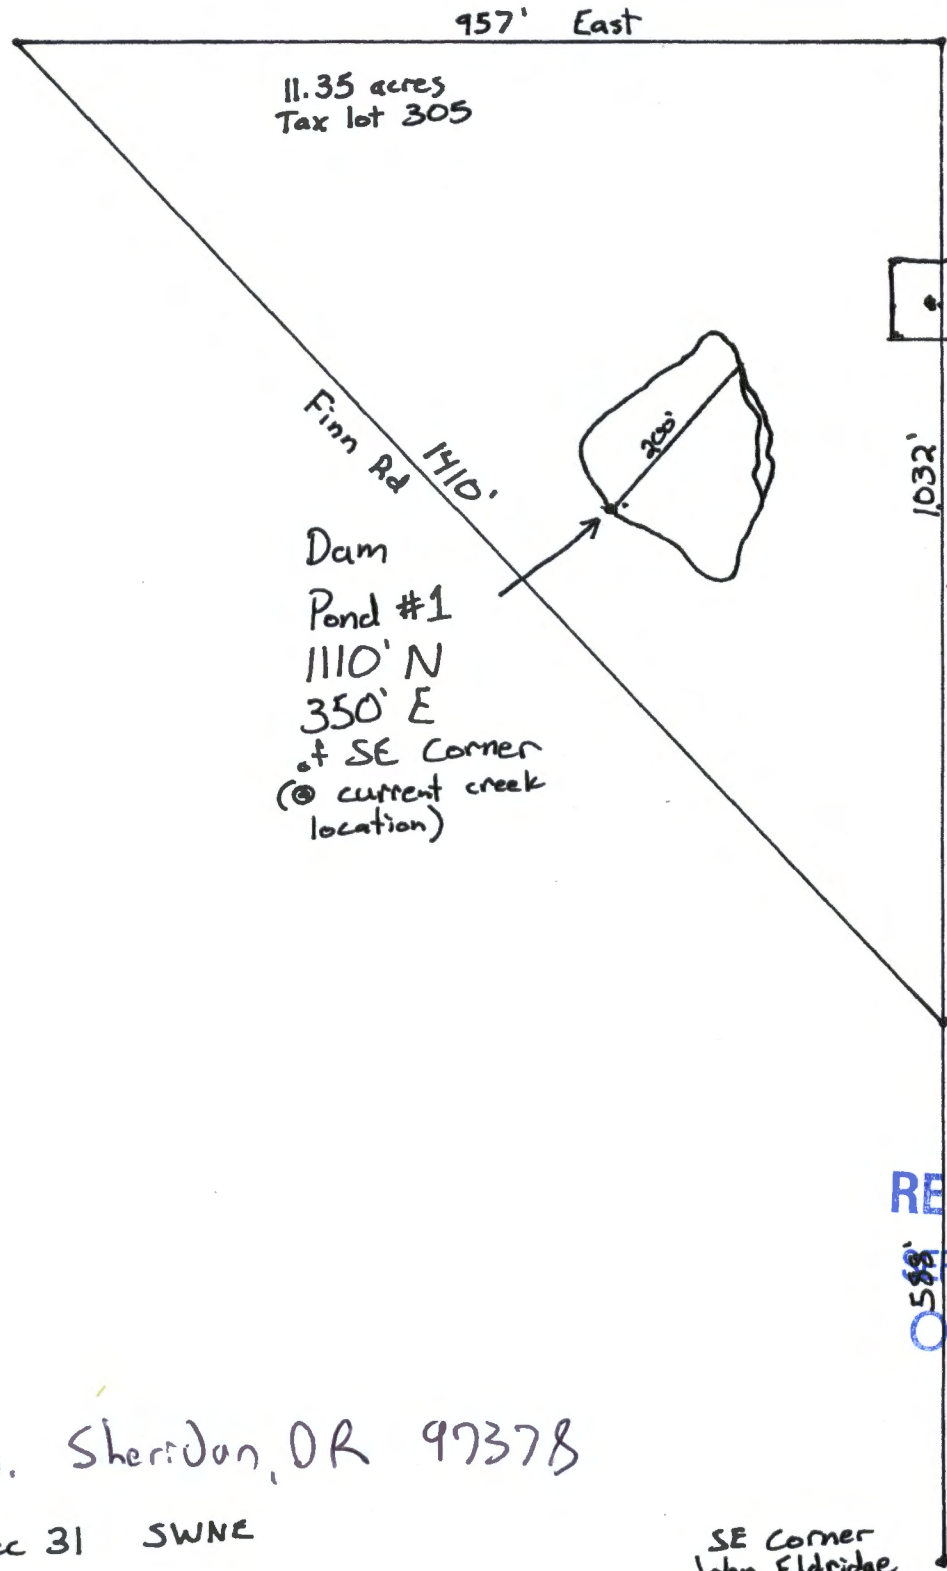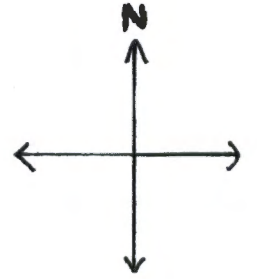

11.35 acres
Tax lot 305

Finn Rd 1410'

Dam
Pond #1
1110' N
350' E
of SE corner
(X current creek location)



Center
Pond #2
(existing)
1320' N
14' E
of SE
corner

RECEIVED
588
P. 07 2016
OWRD

21225 Finn Rd. Sheridan, OR 97378
Location: T65R6W Sec 31 SWNE

SE Corner
John Eldridge
DLC Na 47

Scale 1" = 200'
R-88200