


T 9 S. R 1 E. Section 19

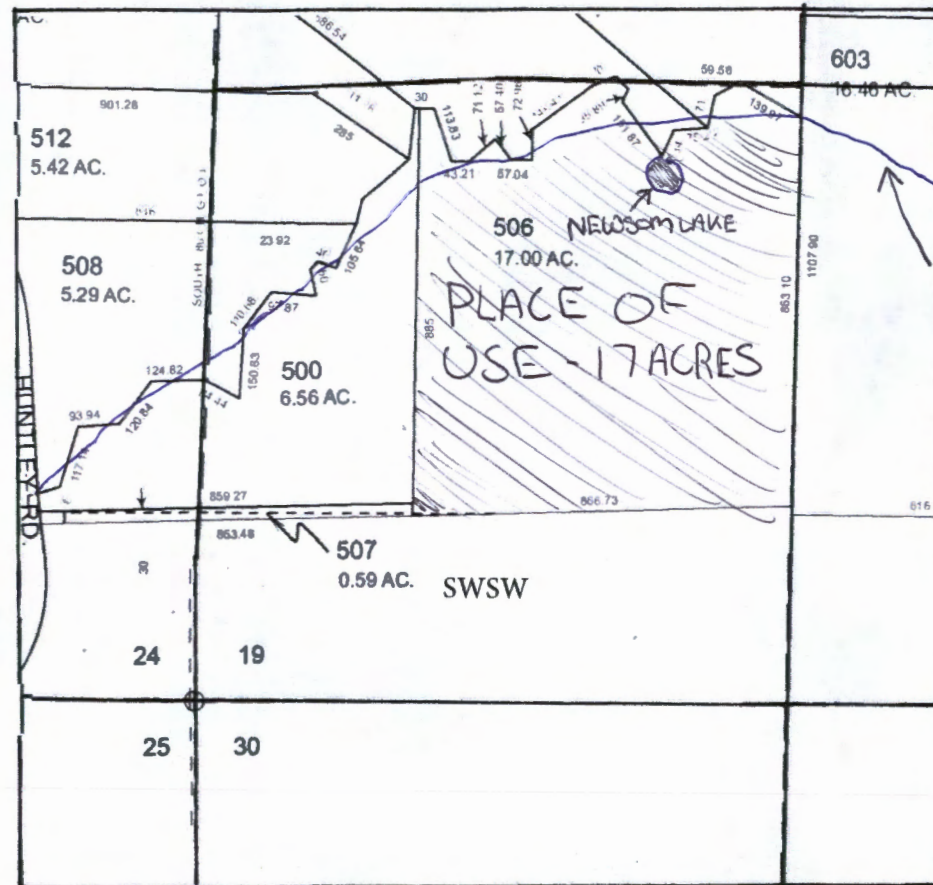

Scale 1" = 400'



- Pond is located 1160 feet North and 1040 feet East from the SW corner of section 19.
- △ P.O.D. is located 1280 feet North and 1160 feet East from the SW corner of Section 19

This map was prepared with the assistance of C.S.G. and is based on information provided by the applicant and by records of the county. This is to represent the location of a water right requested in this application and does not intend to illustrate property boundaries or ownership.

RECEIVED BY OWRD

MAY 10 2016

SALEM, OR

RECEIVED BY OWRD

SEP 08 2016

SALEM, OR

5-80283