


R-0025

08 1E 20

08 1E 20

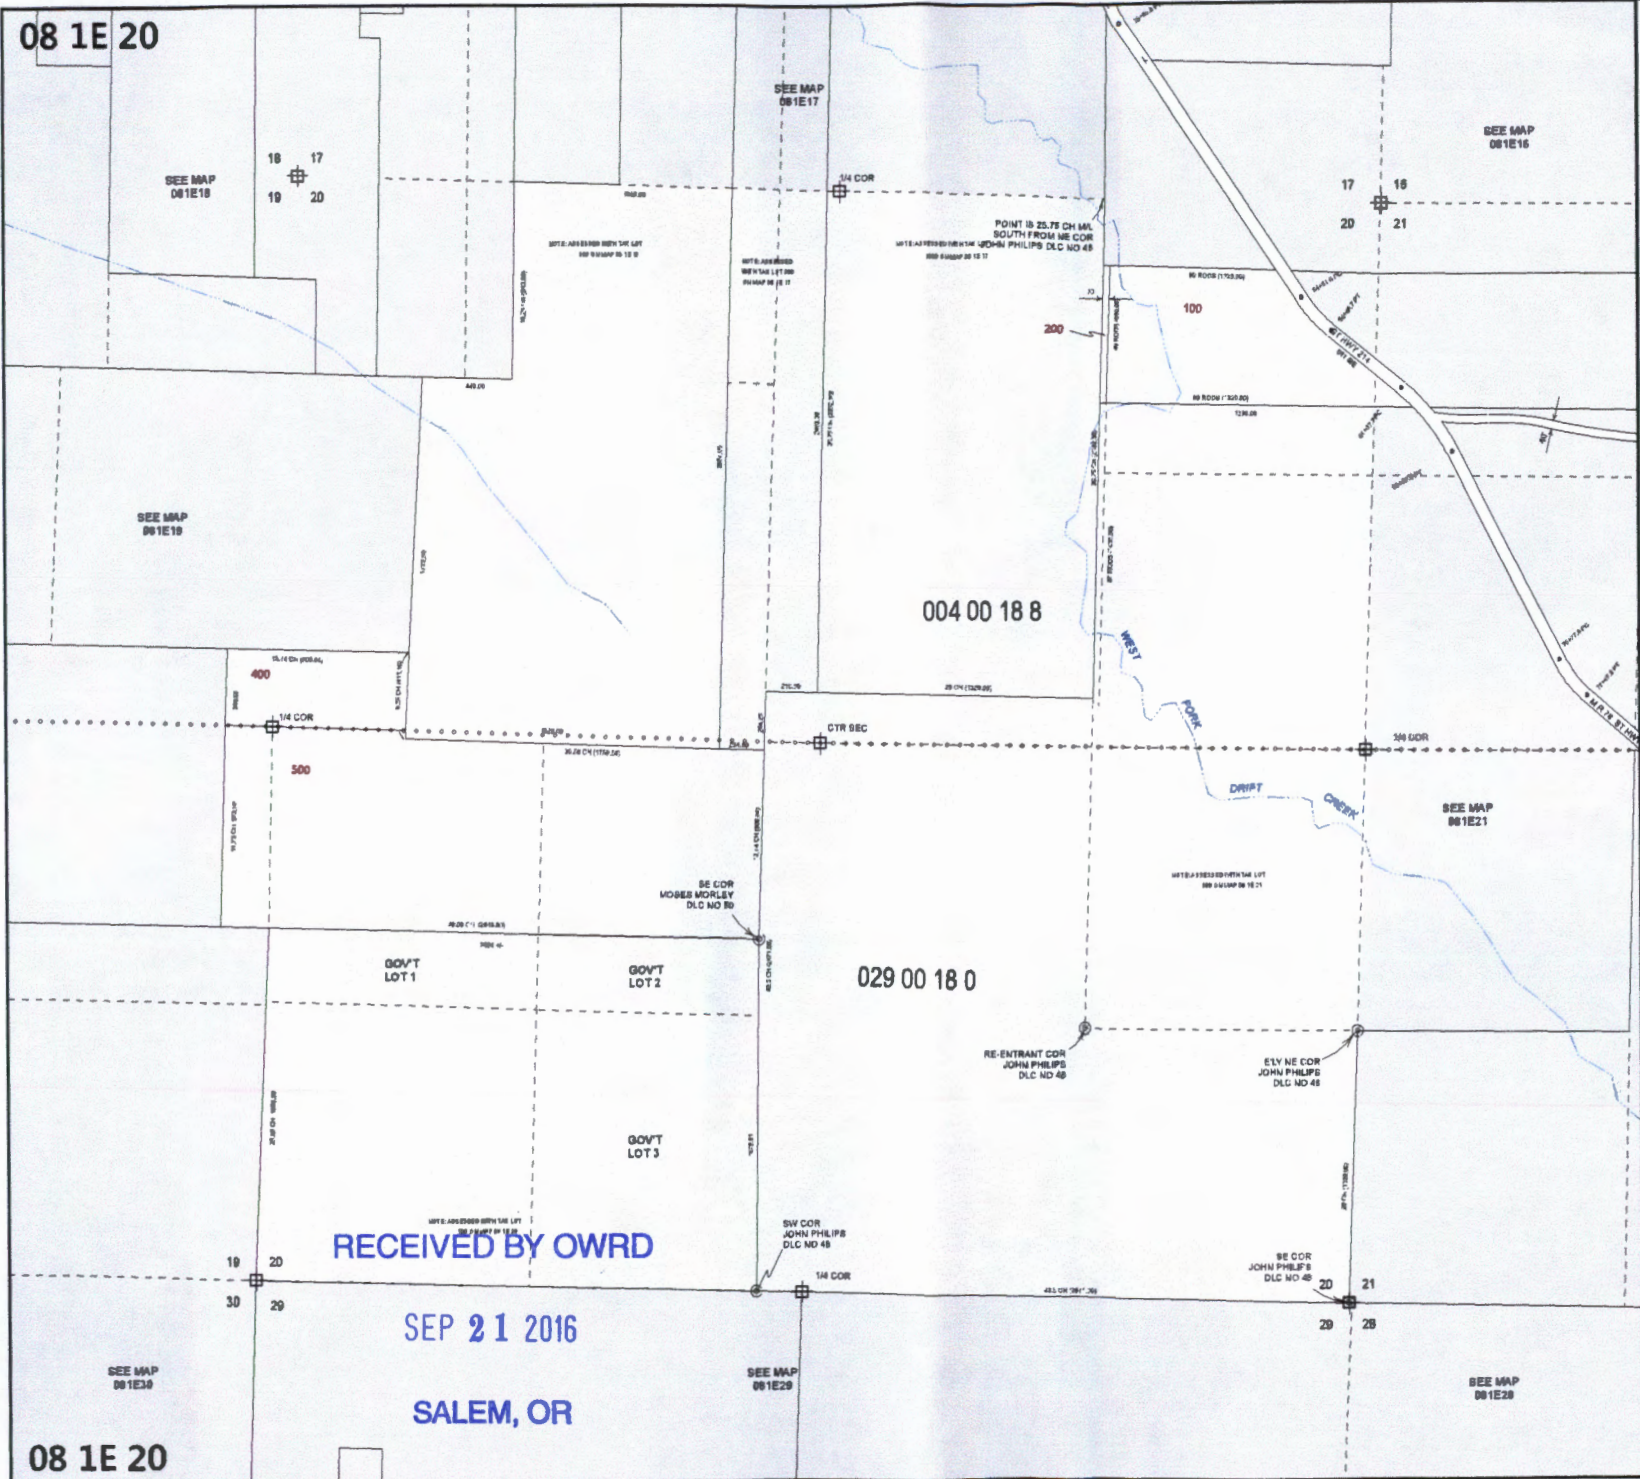

**MARION COUNTY, OREGON**  
 SEC 20 T8S R1E W.M.  
 SCALE 1" = 400'

**LEGEND**

- LINE TYPES**
- Taxlot Boundary
  - Road Right-of-Way
  - Railroad Right-of-Way
  - Private Road Right-of-Way
  - Subdivision/Plot Boundary
  - Waterline - Taxlot Boundary
  - Waterline - Non Boundary
  - Historical Boundary
  - East-West
  - Railroad Centerline
  - Taxcode Line
  - Map Boundary
  - Waterline - Non Boundary

- SYMBOL TYPES**
- Survey Monument
  - Road Station
  - DLC Corner
  - 1/16TH Section Cor
  - 1/4 Section Cor
  - 16 15
  - Section Corner
  - 21 22

**NUMBERS**

Tax Code Number  
 000 00 00 0

Assessors Office  
 All areas shown are NHT Areas, indicating any portion of the lands within public ROWs.

**NOTES**

Tick Marks: If a tick mark is indicated on the end of a line, then the dimension is to the tick mark. This is used when dimensions measure into public right-of-ways.

CANCELLED NUMBERS	

DISCLAIMER: THIS MAP WAS PREPARED FOR ASSESSMENT PURPOSES ONLY



FOR ADDITIONAL MAPS VISIT OUR WEBSITE AT [www.co.marion.or.us](http://www.co.marion.or.us)

PLOT DATE: 10/8/2015

RECEIVED BY OWRD

SEP 21 2016

SALEM, OR

08 1E 20


08 1E 20


Terry Behrens

1" = 1320'

Tax Lot:

Township 8 South, Range 1 East, Section 17 & 20, Tax Lot 800

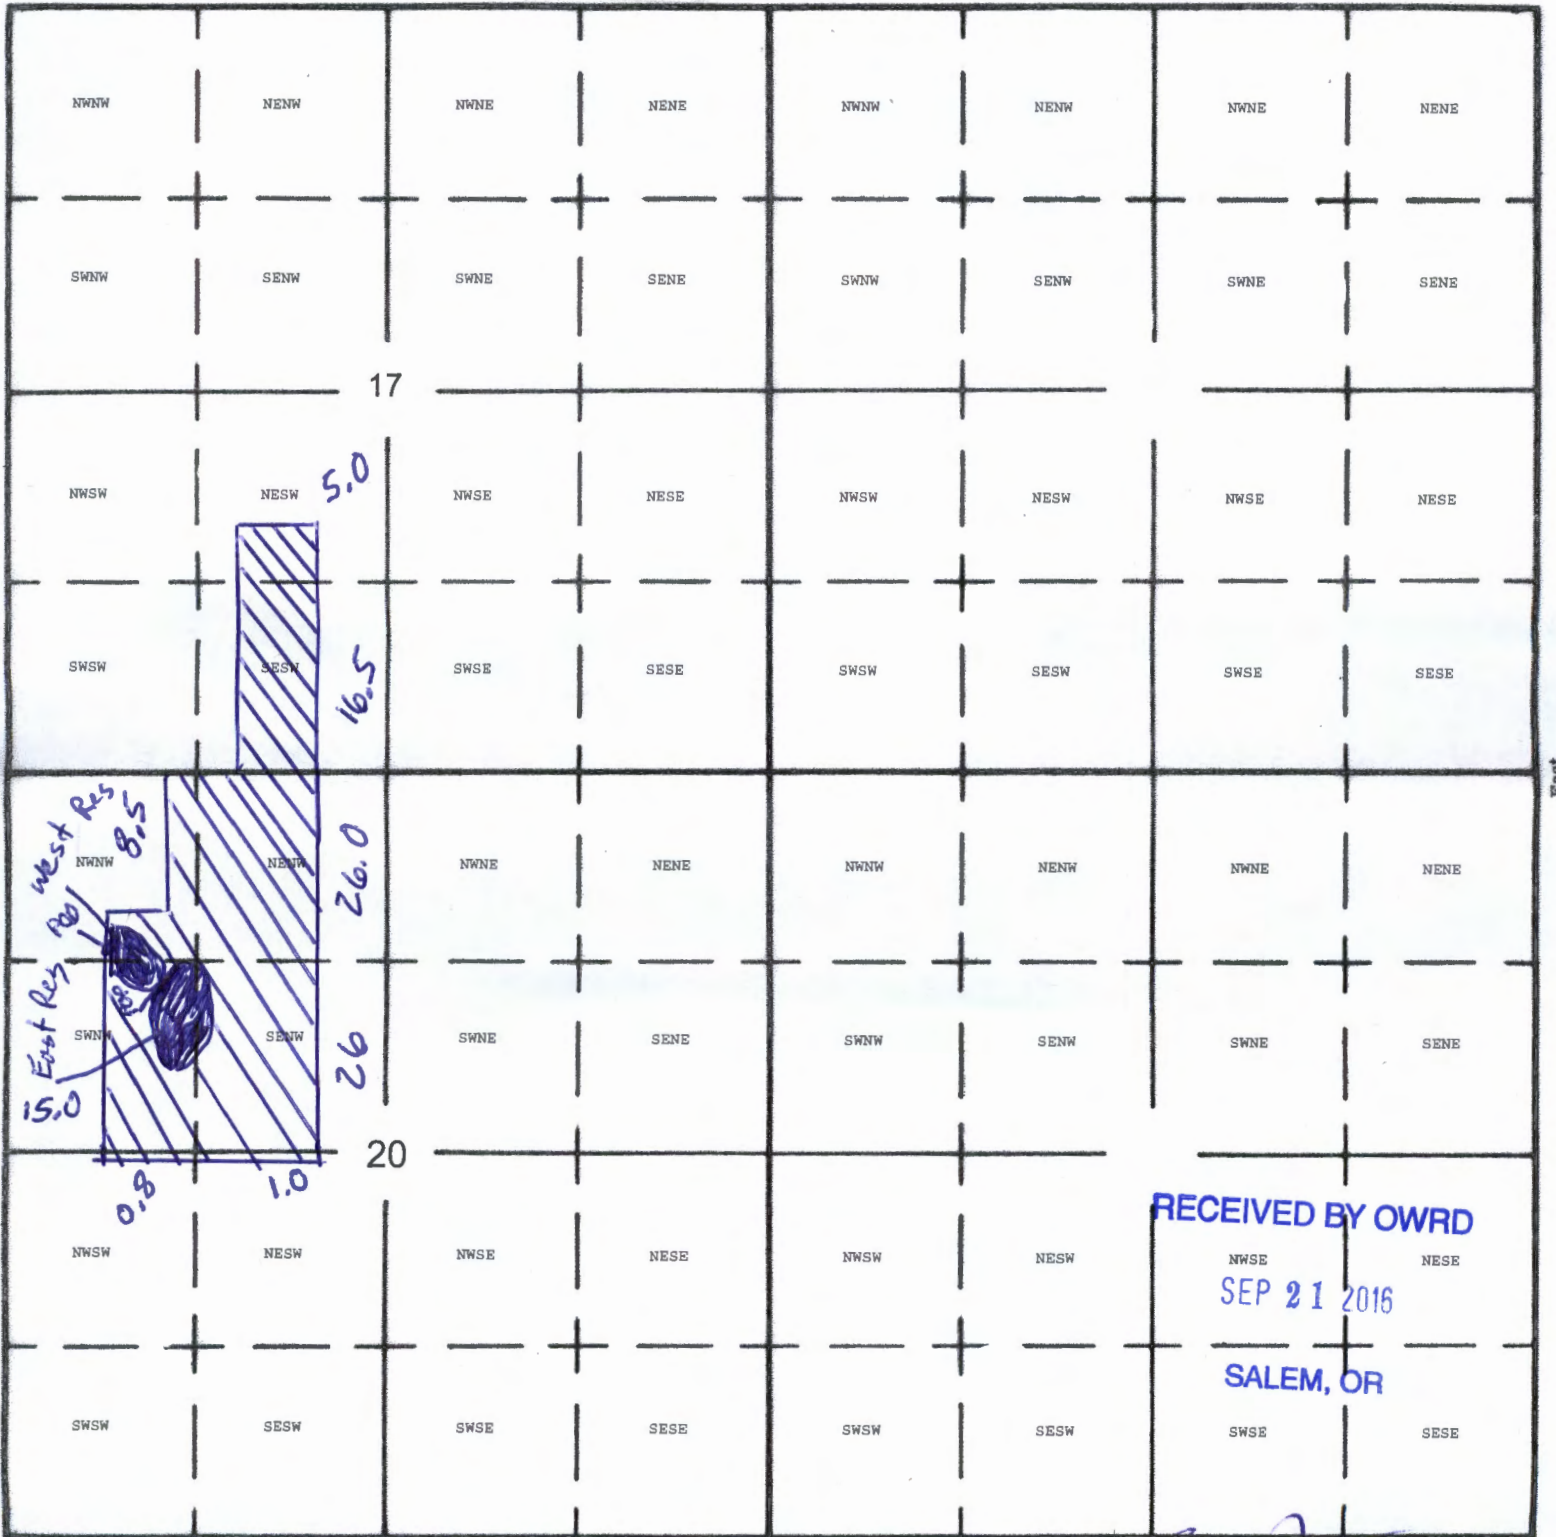

98.8 acres 

South

Dam Location East: 1350 South and 1500 West from NE Corner Section 20  
 Dam Location West: 1200 South and 1950 West from NE Corner Section 20  
 POD: 1350 South and 1500 West from NE Corner Section 20  
 POD: 1200 South and 1950 West from NE Corner Section 20

R-88223

*TR 12/6*  
*7/7/16*

08 1E 20



MARION COUNTY, OREGON  
SEC 20 T8S R1E W.M.  
SCALE 1" = 400'

LEGEND

- LINE TYPES
- Taxlot Boundary
  - Road Right-of-Way
  - Railroad Right-of-Way
  - Private Road ROW
  - Subdivision/Plat Bndry
  - Waterline - Taxlot Bndry
  - Historical Boundary
  - Easement
  - Railroad Centerline
  - Taxcode Line
  - Map Boundary
  - Waterline - Non Bndry

- SYMBOL TYPES
- Survey Monument
  - Road Station
  - DLC Corner
  - 1/16TH Section Cor.
  - 1/4 Section Cor.
  - Section Corner

NUMBERS  
Tax Code Number  
**000 00 00 0**

Acreage 0.25 AC All acres listed are Net Acres, excluding any portions of the taxlot within public ROWs

NOTES  
Tick Marks: If a tick mark is indicated on the end of a line, then the dimension goes to the tick mark. This is used when dimensions extend into public right-of-ways.



CANCELLED NUMBERS


DISCLAIMER: THIS MAP WAS PREPARED FOR ASSESSMENT PURPOSES ONLY




FOR ADDITIONAL MAPS VISIT OUR WEBSITE AT [www.co.marion.or.us](http://www.co.marion.or.us)

PLOT DATE: 10/8/2015

08 1E 20

08 1E 20

08 1E 20

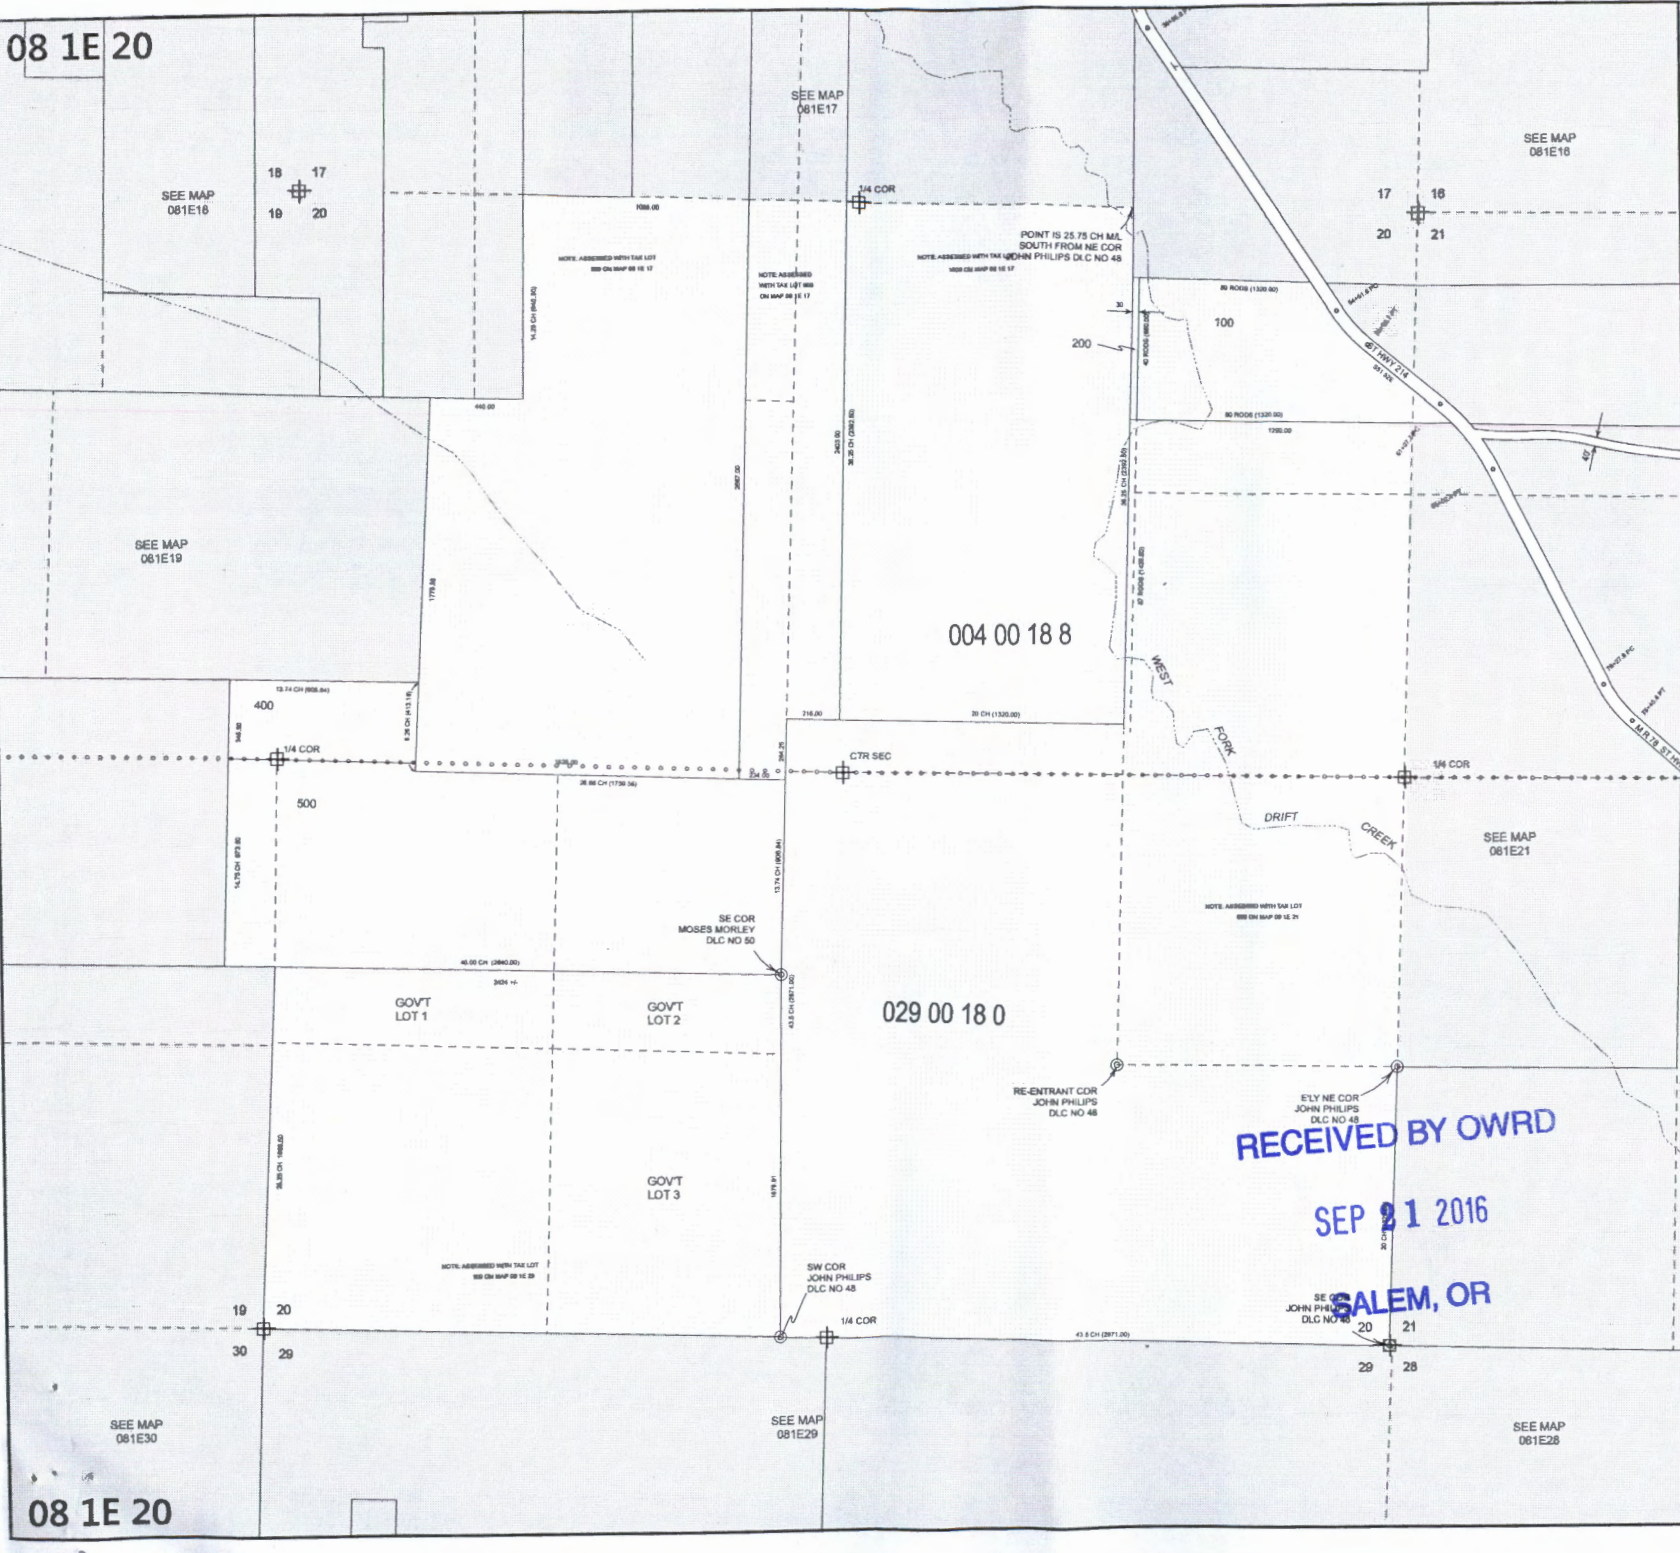

RECEIVED BY OWRD

SEP 21 2016

SALEM, OR

R-0029

08 1E 17

12 feet

08 1E 17



MARION COUNTY, OREGON  
SEC 17 T8S R1E W.M.  
SCALE 1" = 400'

LEGEND

LINE TYPES

- Taxlot Boundary
- Road Right-of-Way
- Railroad Right-of-Way
- Private Road ROW
- Subdivision/Plat Boundary
- Waterline - Taxlot Boundary
- Historical Boundary
- Easement
- Railroad Centerline
- Taxcode Line
- Map Boundary
- Waterline - Non Boundary

SYMBOL TYPES

- Survey Monument
- Road Station
- DLC Corner
- 1/16TH Section Cor.
- 1/4 Section Cor.
- 16/21 Section Corner

NUMBERS

Tax Code Number  
000 00 00 0

Acres 0.25 AC All acres listed are Net Acres, excluding any portions of the taxlot within public right-of-ways

NOTES

Tick Marks: If a tick mark is indicated on the end of a line, then the dimension goes to the tick mark. This is used when dimensions extend into public right-of-ways.

CANCELLED NUMBERS

BOOK 1				
--------	--	--	--	--

RECEIVED BY OWRD

SEP 21 2016

SALEM, OR


DISCLAIMER: THIS MAP WAS PREPARED FOR ASSESSMENT PURPOSES ONLY



FOR ADDITIONAL MAPS VISIT OUR WEBSITE AT www.co.marion.or.us

PLOT DATE: 10/8/2015

08 1E 17

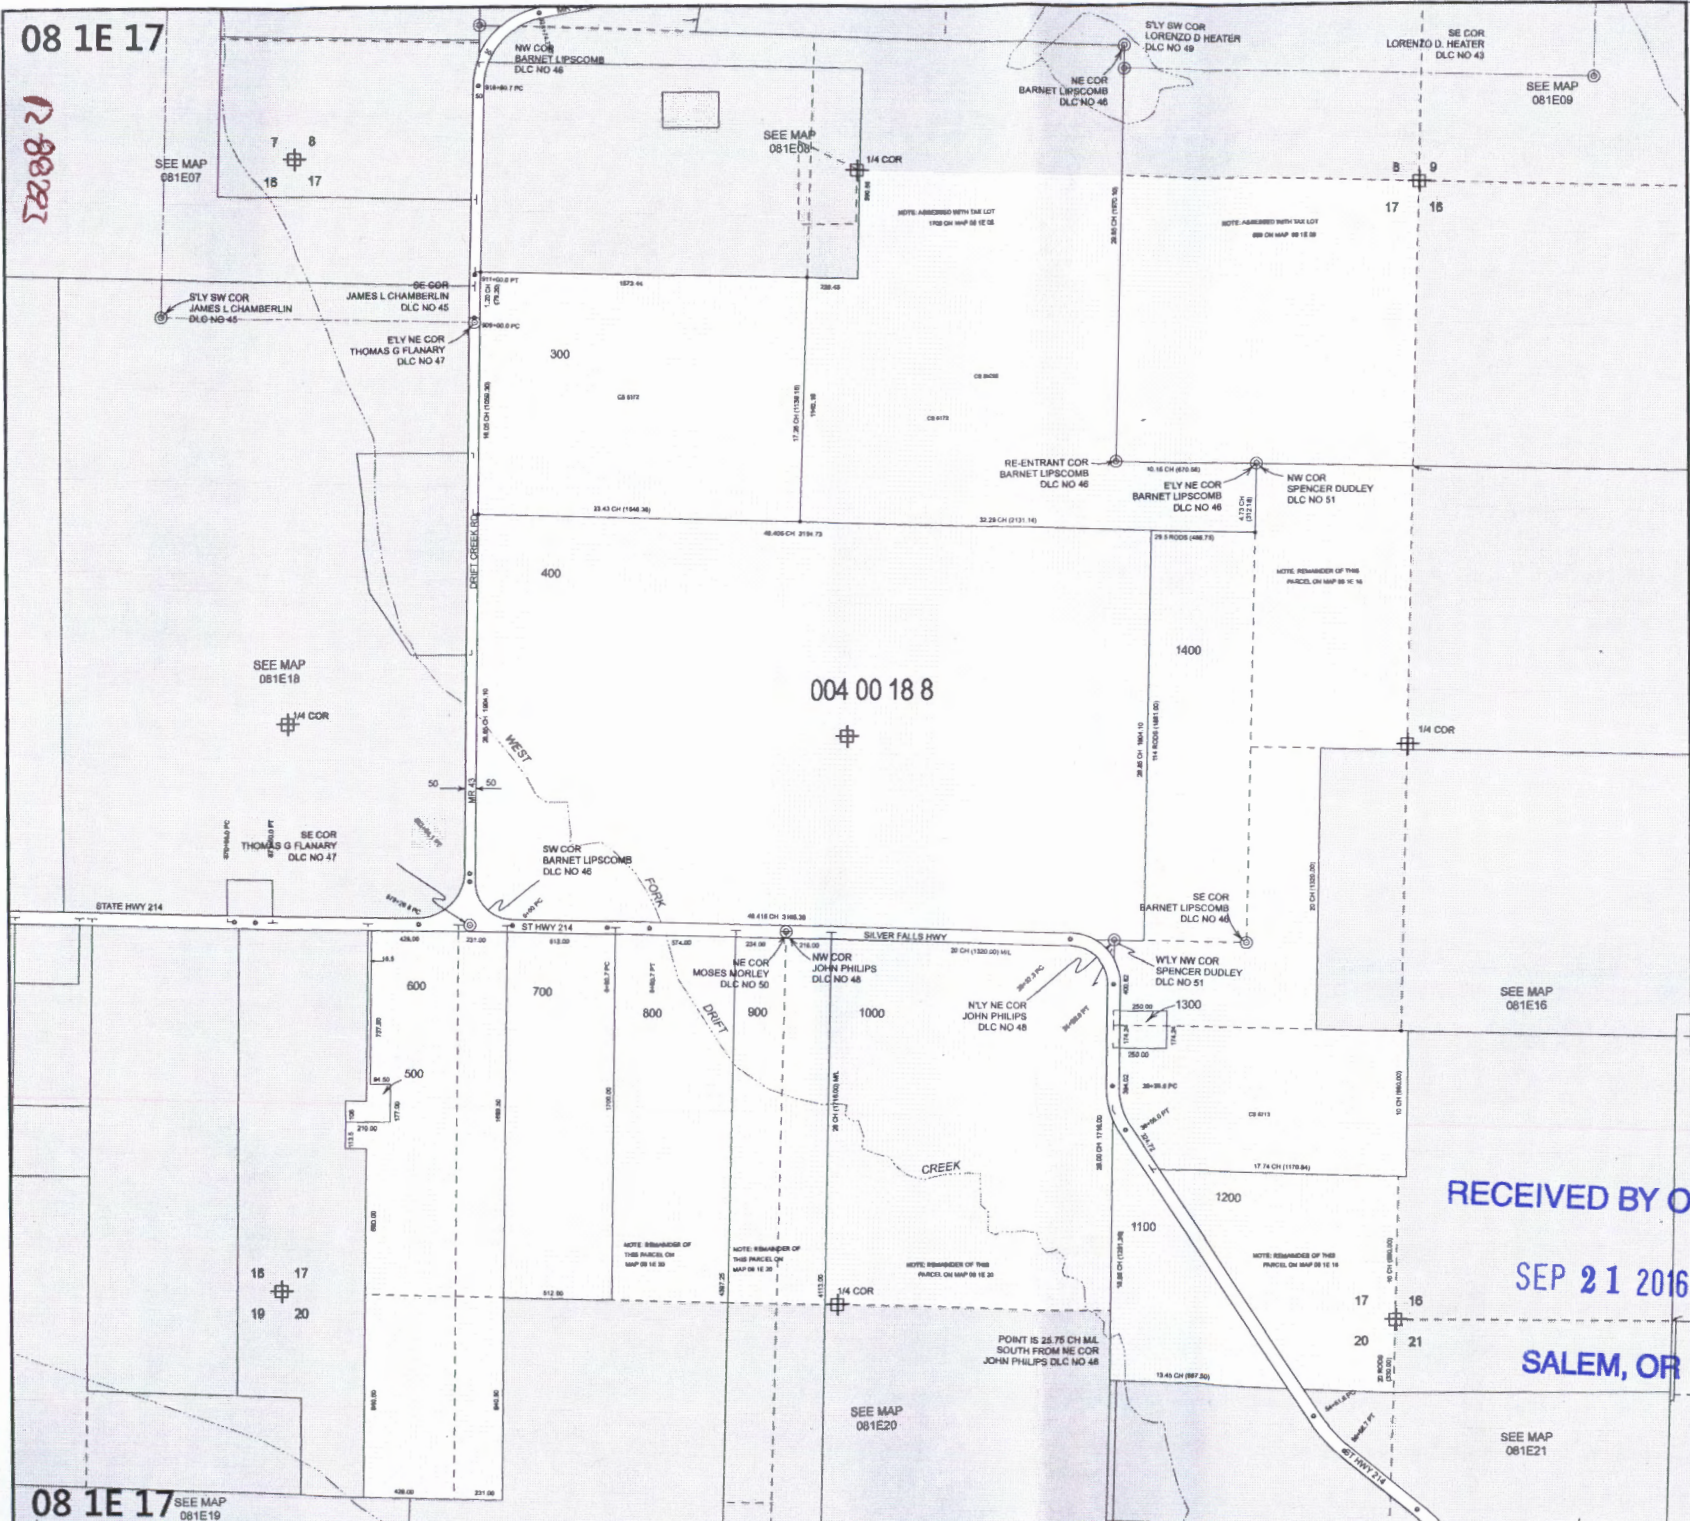

08 1E 17 SEE MAP 081E19

SEE MAP 081E21

SEE MAP 081E20

SEE MAP 081E15

SEE MAP 081E09

SEE MAP 081E07

SEE MAP 081E08

SEE MAP 081E18

004 00 18 8

POINT IS 26.75 CH MAL SOUTH FROM NE COR JOHN PHILIPS DLC NO 48

NOTE: REMAINDER OF THIS PARCEL ON MAP 88 1E 30

NOTE: REMAINDER OF THIS PARCEL ON MAP 88 1E 31

NOTE: REMAINDER OF THIS PARCEL ON MAP 88 1E 30

NOTE: REMAINDER OF THIS PARCEL ON MAP 88 1E 16


NOTE: REMAINDER OF THIS PARCEL ON MAP 88 1E 16

NOTE: REMAINDER OF THIS PARCEL ON MAP 88 1E 16

NOTE: ADJACENT WITH TAX LOT 688 CH MAP 88 1E 30

NOTE: ADJACENT WITH TAX LOT 1782 CH MAP 88 1E 30

R-88293

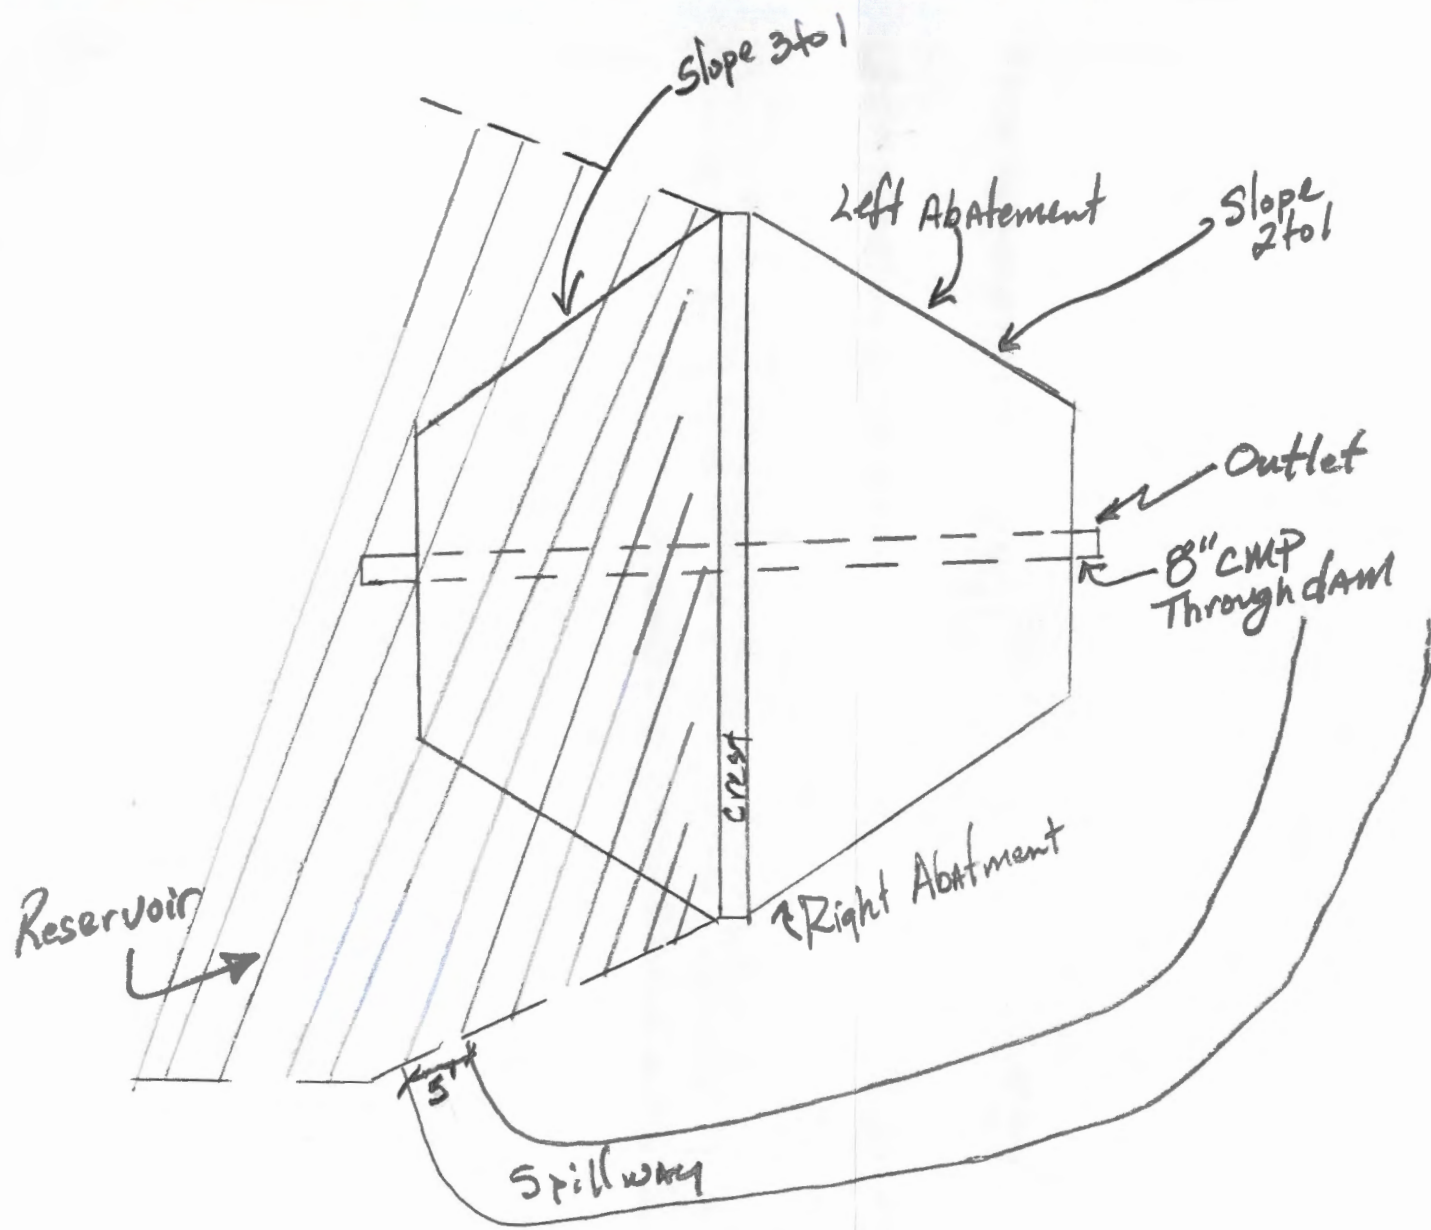

Plan View

RECEIVED BY OWRD

SEP 21 2016

SALEM, OR