

18050900


FOR ASSESSMENT AND
TAXATION ONLY

SECTION 9 T.18S. R.5W. W.M.
Lane County

1" = 1000'

GIS DATA
11/18/2009 10:12:40 AM : build

CANCELLED:
200
202
504
800
506

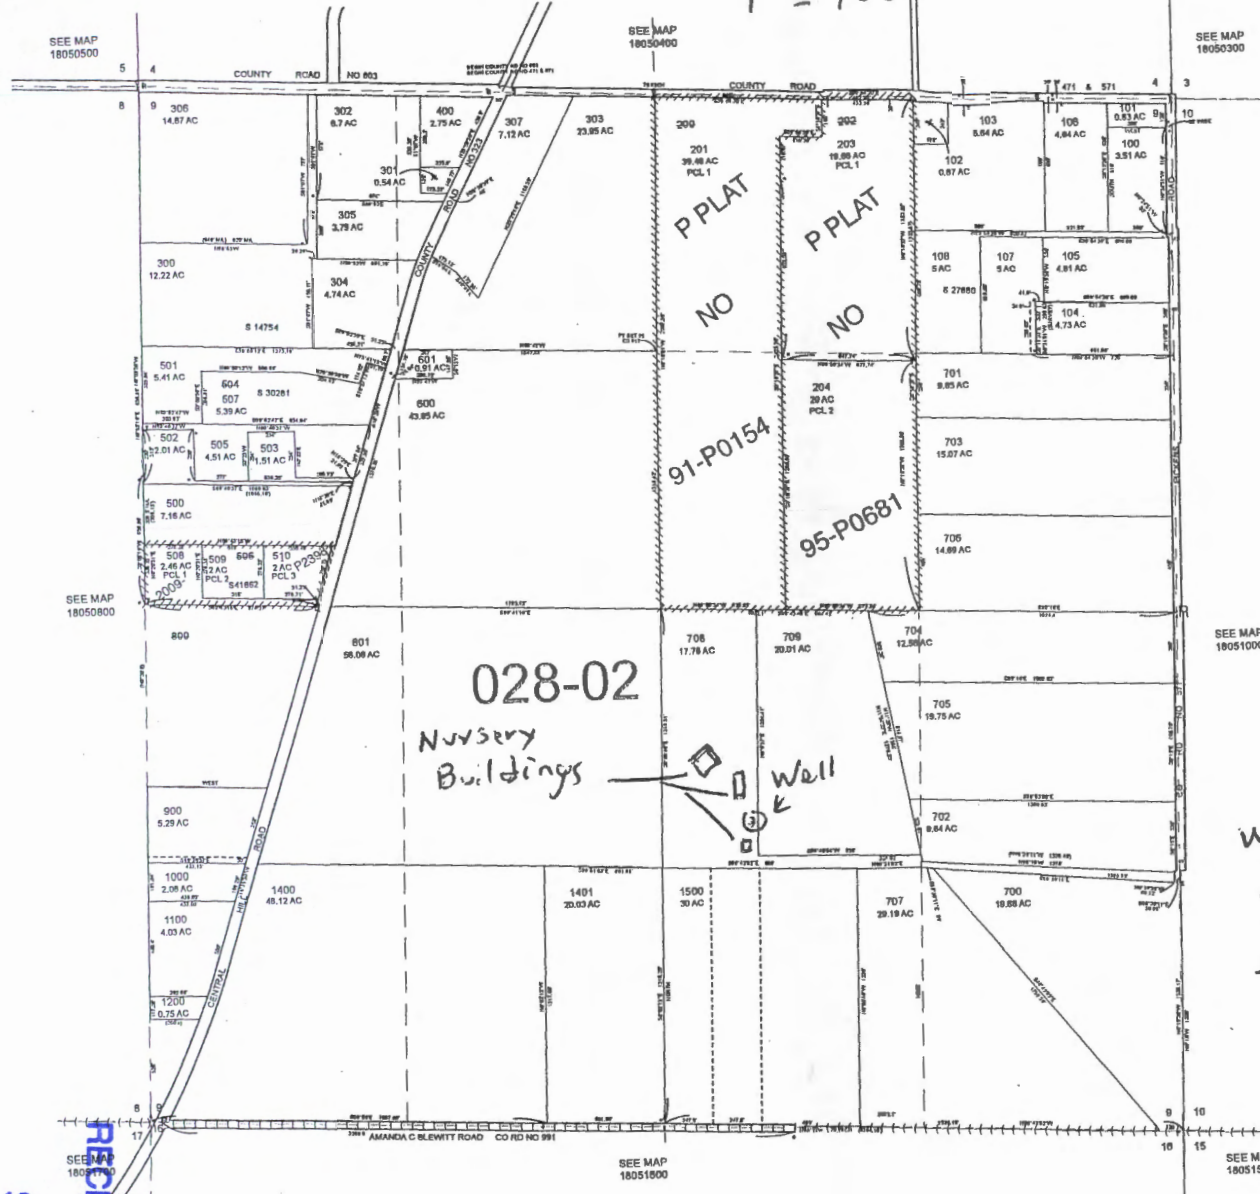

TL 708
in NW 1/4
of SE 1/4
sec 9

Well is 1620 ft N
and 2220 ft W
from SW corner
section 9

REVISIONS:
REV 0001 - LOC 118 - CONVEY MAP TO 180
11/18/2009 - LOC 101 - CANCEL PL 180 0010 2000 P228

18050900

G-18585

SALEM, OR

SEP 14 2016

RECEIVED BY OWRD