

TAX PARCEL: 17-01-25-00-00502

PROPERTY ID: 1717360

ADDRESS: DEERHORN ROAD

SPRINGFIELD, OREGON 97478

LANE COUNTY

CONTACT:

TERESA HALVERSON



CELL PHONE: 541-912-7890

EMAIL: tk.halverson@me.com

2 3/8" DIA LANE

LANE COUNTY BRASS CAP

SET 1997

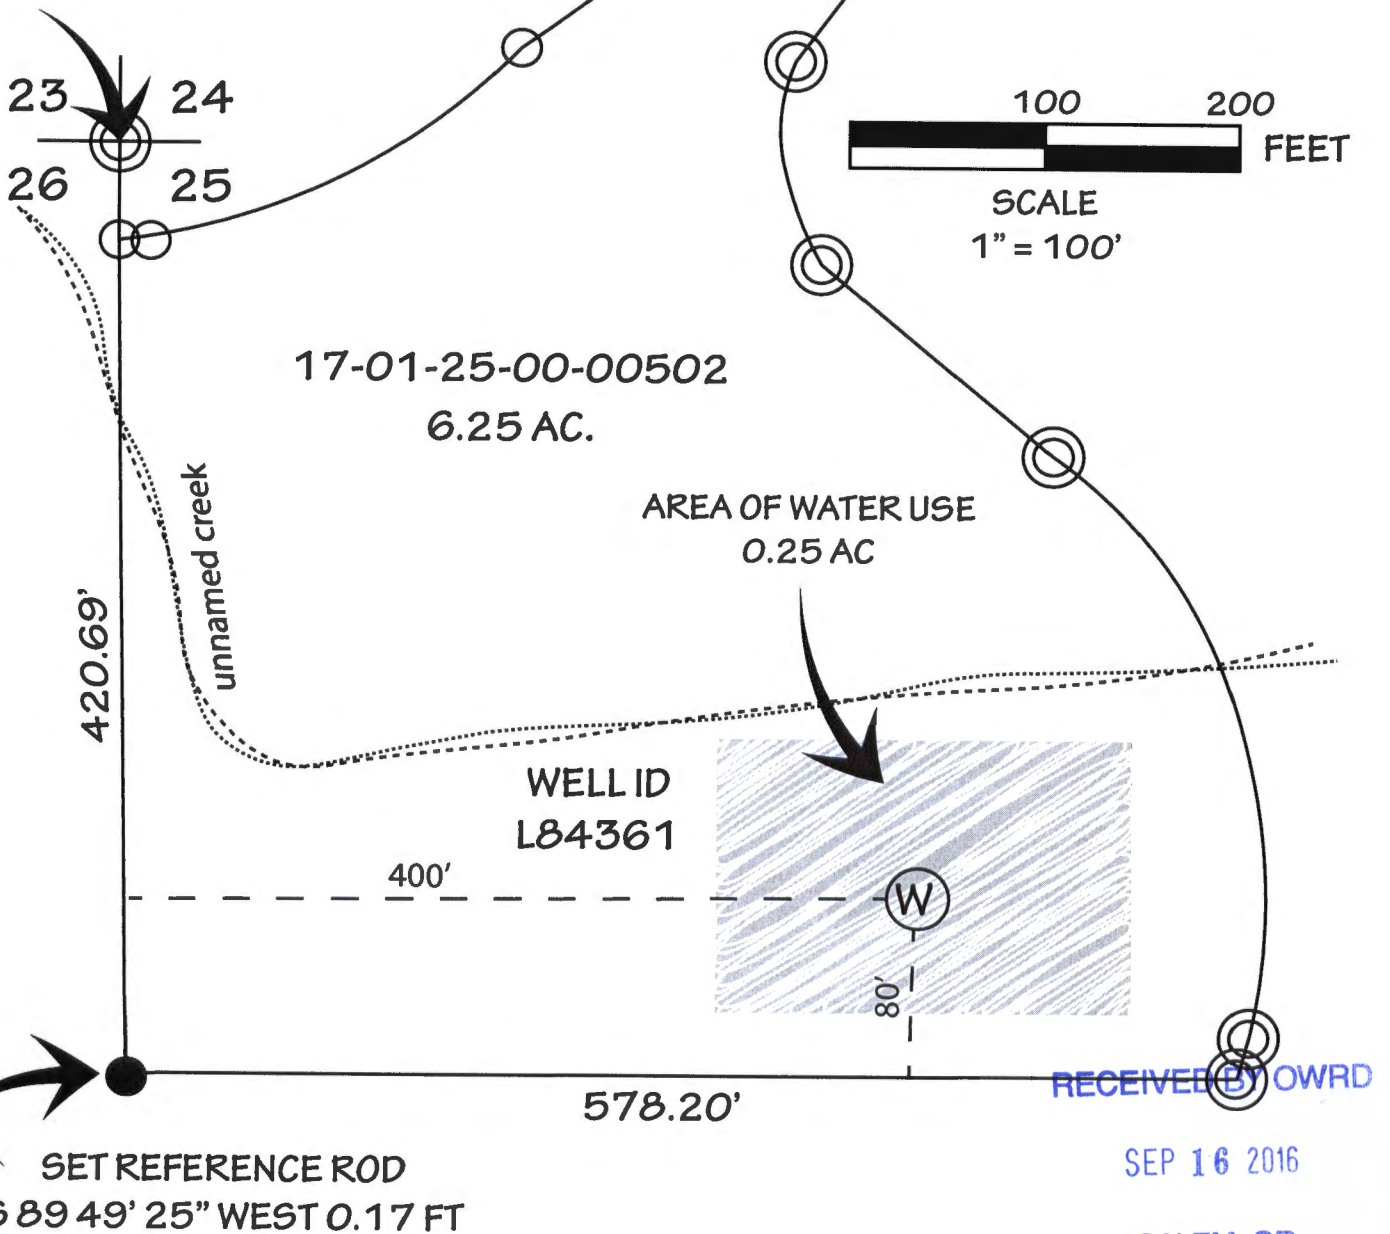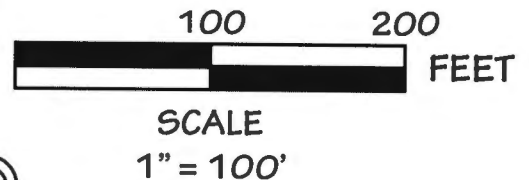

G-18J86