


T36S R6W Southwest Quarter Section 6

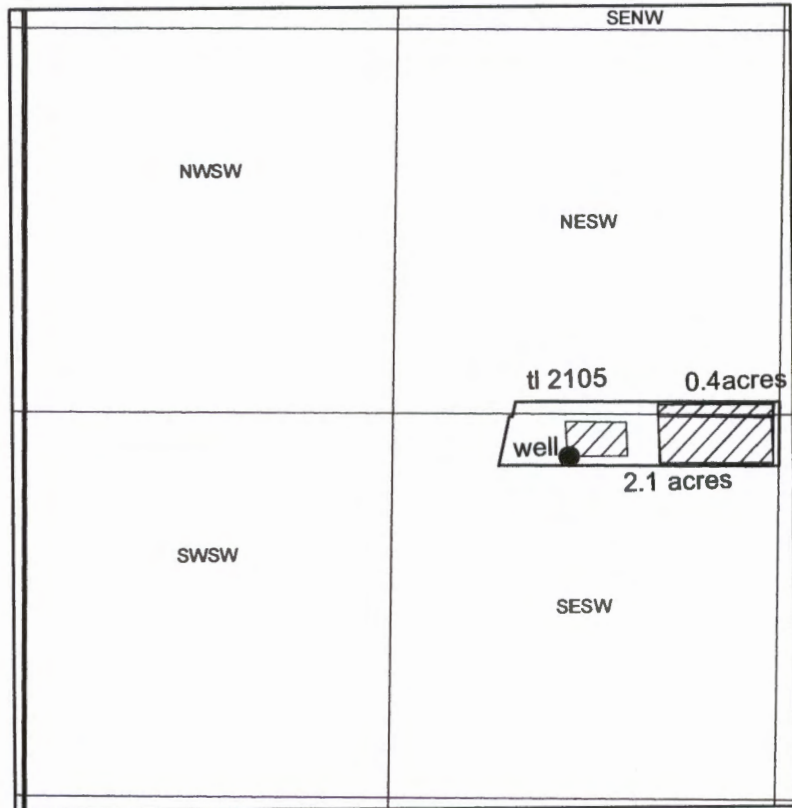

Southwest corner Section 6

1 inch = 660 feet

The well is located approximately 181 ft north and 1873 ft east of the southwest corner of Section 6, according to the landowner.

RECEIVED BY OWRD

SEP 19 2016

SALEM, OR

G-18387