




T 2 S., R 4 E.

Section 2, SW 1/4 NW 1/4

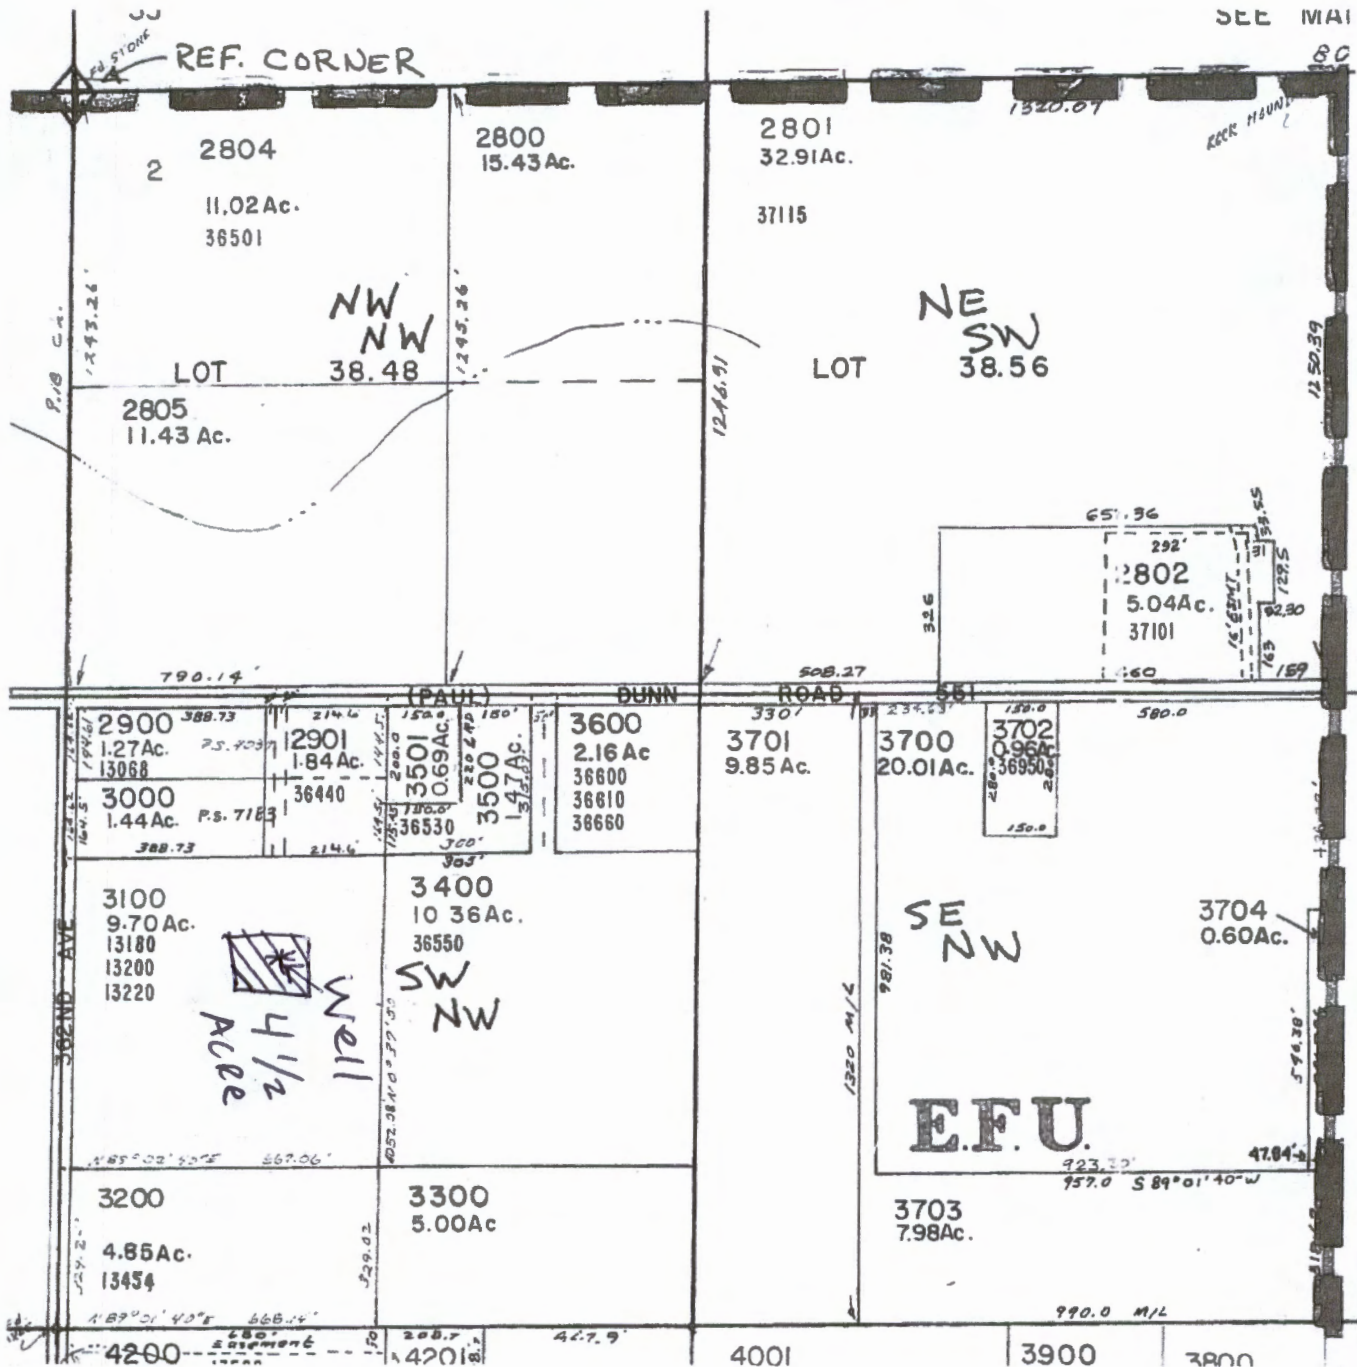

Well is located approximately 2039 feet South and 574 feet East from the
Northwest corner of Section 3.


RECEIVED BY OWRD

Scale 1" = 400'

SEP 26 2016

SALEM, OR

G-18393

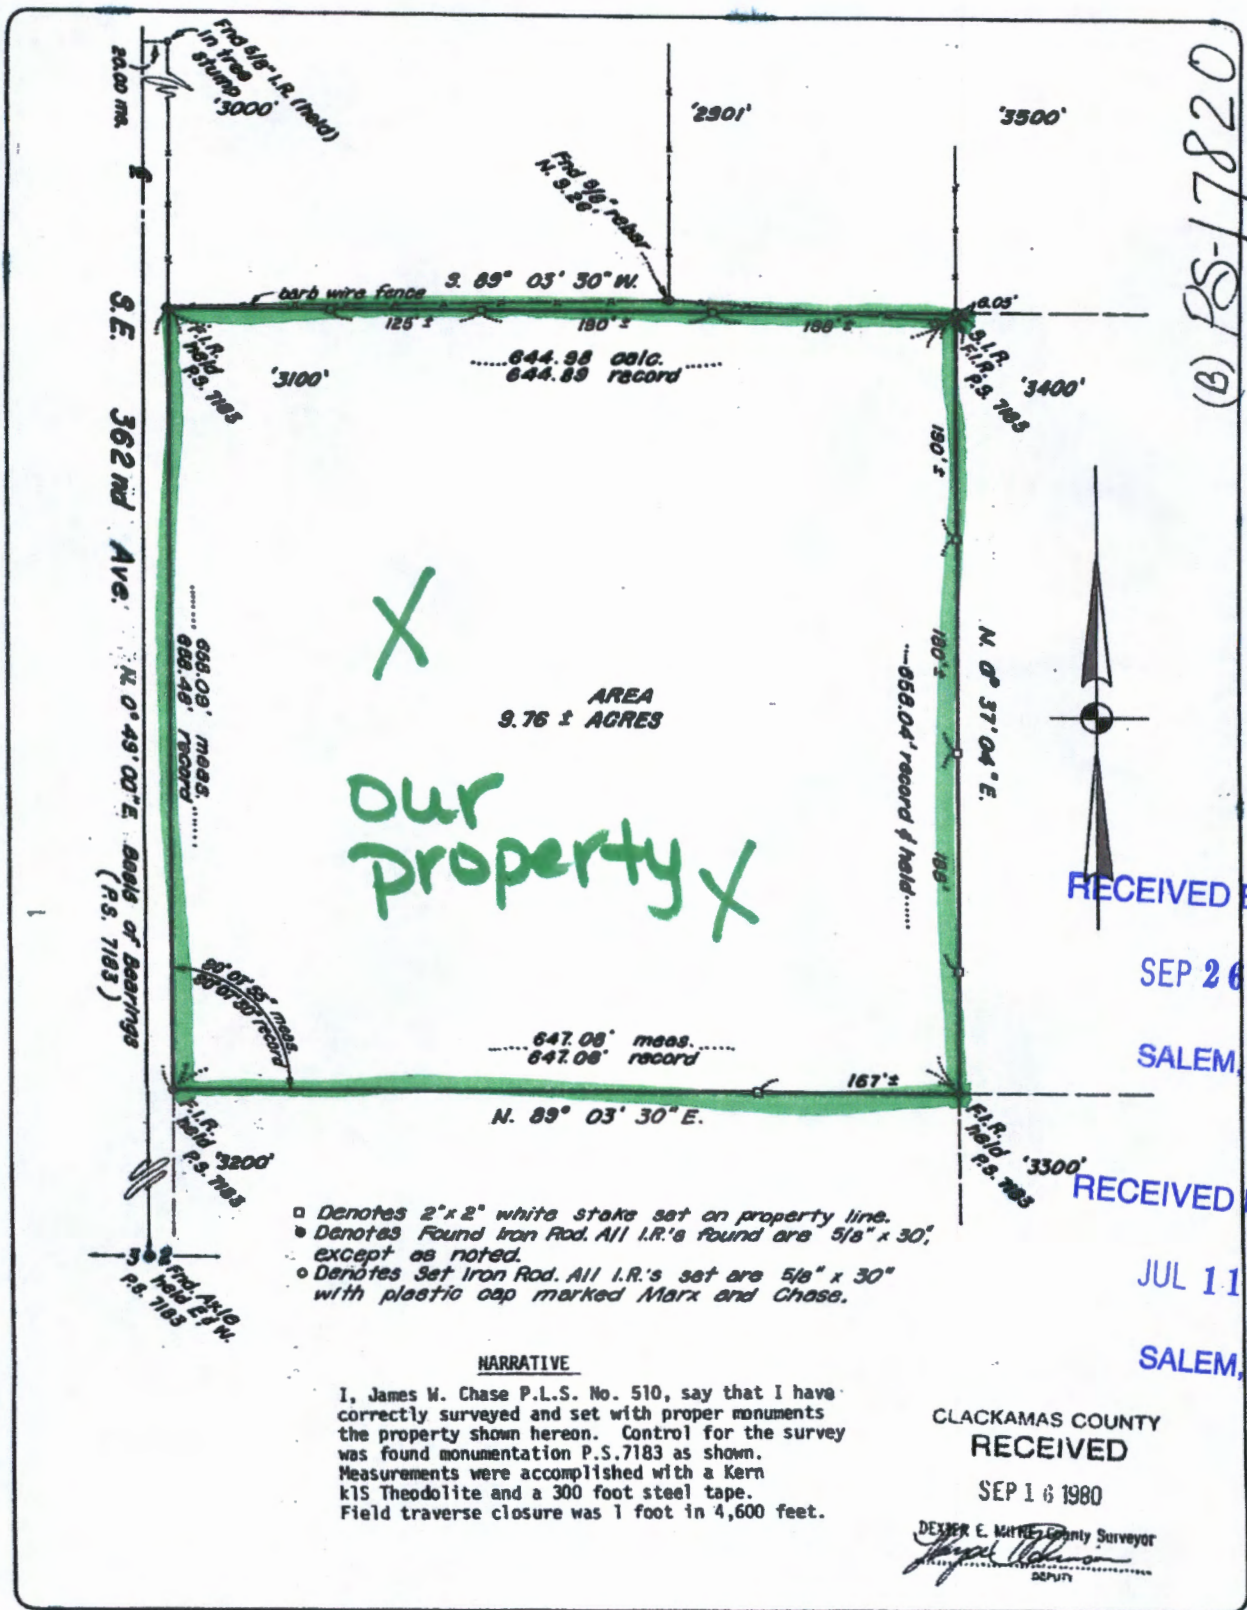

MARX and CHASE Incorporated 600 Northwest Fariss Road Clackamas Oregon 97030 503-667-5550	PROPERTY SURVEY ~ of ~ A TRACT OF LAND Situated in Sec. 2, T.2S., R.4E. W.M. Clackamas County, Oreg.	REGISTERED PROFESSIONAL LAND SURVEYOR James W. Chase OREGON JULY 6, 1960 JAMES W. CHASE 510	Designed _____ Date _____ Drawn <u>dro</u> Date <u>8-80</u> Checked <u>dem</u> Date <u>8-80</u> Scale 1" = 100' Project No. <u>0190</u> Sheet No. _____
---	---	---	---

(B) PS-17820

RECEIVED BY OWRD
SEP 26 2016
SALEM, OR

RECEIVED BY OWRD
JUL 11 2016
SALEM, OR

G-18J23

2 4 E 2 B C

4/17/2015

486'

135'

INDOOR PRODUCTION

well

112'

OUR HOUSE

PROPOSED OUTDOOR PRODUCTION

13220 se 362nd ave boring or 97009

647'

462'

driveway

658'

362nd ave

Imagery Date: 4/17/2015 45°25'38.34" N 122°17'23.62" W elev 773 ft

RECEIVED BY OWR/RECEIVED BY OWRD

SEP 26 2016

JUL 11 2016

G-183793

SALEM, OR

SALEM, OR

4/17/2015



486'

135'

INDOOR PRODUCTION

well

112'

OUR HOUSE

PROPOSED OUTDOOR PRODUCTION



13220 se 362nd ave boring or 97009



462'

driveway

RECEIVED BY OWRD

SEP 26 2016

SALEM, OR

647'

Our Property

658'

362nd ave

Imagery Date: 4/17/2015 45°25'38.34" N 122°17'23.62" W elev 773 ft

1995

RECEIVED BY OWRD

JUL 11 2016

SALEM, OR

G-18293