


T39S R8W Northeast Quarter Section 15

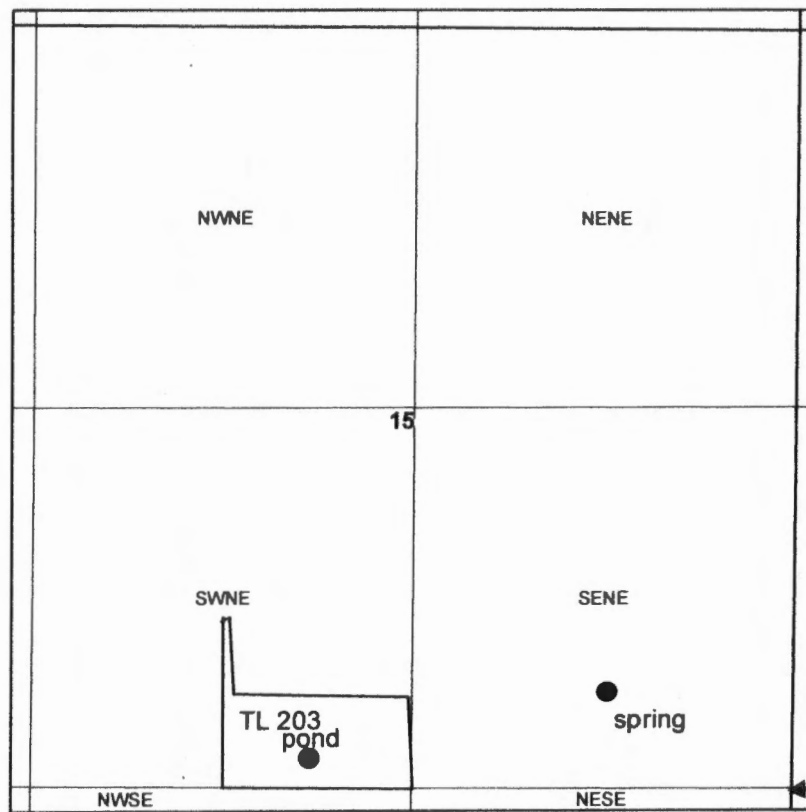

RECEIVED BY OWRD

SEP 26 2016

SALEM, OR


1 inch = 668 feet

The spring is located 350 ft north and 650 ft west from east corner Section 15.

The pond will be located 104 ft north and 1678 ft west of the east corner of Section 15.

R-88874

T39S R8W Northeast Quarter Section 15

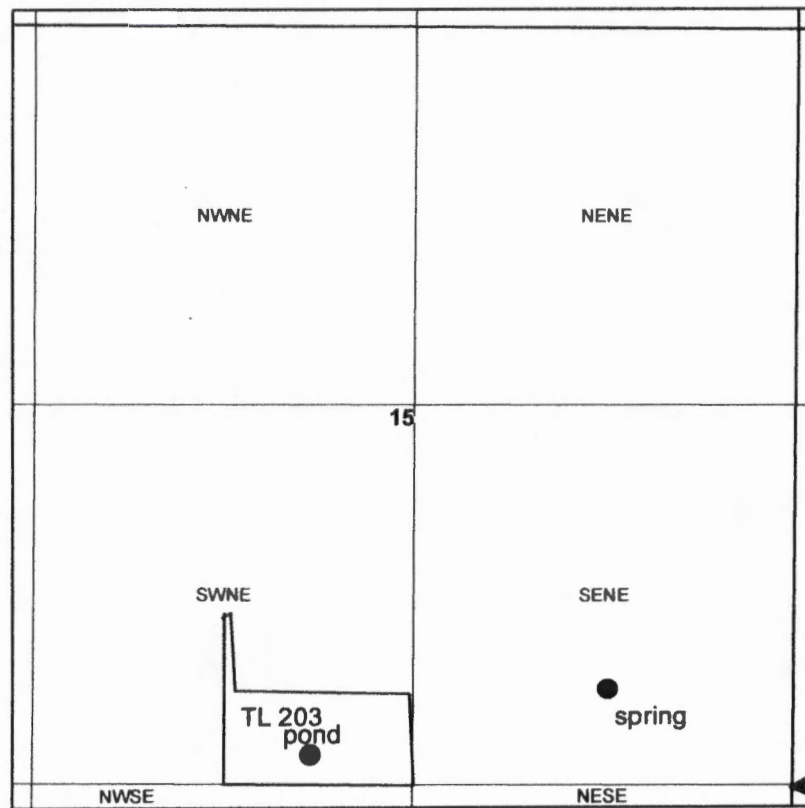

RECEIVED BY OWRD

East corner Section 15

SEP 26 2016



SALEM, OR

1 inch = 668 feet

The spring is located 350 ft north and 650 ft west from east corner Section 15.

The pond will be located 104 ft north and 1678 ft west of the east corner of Section 15.


 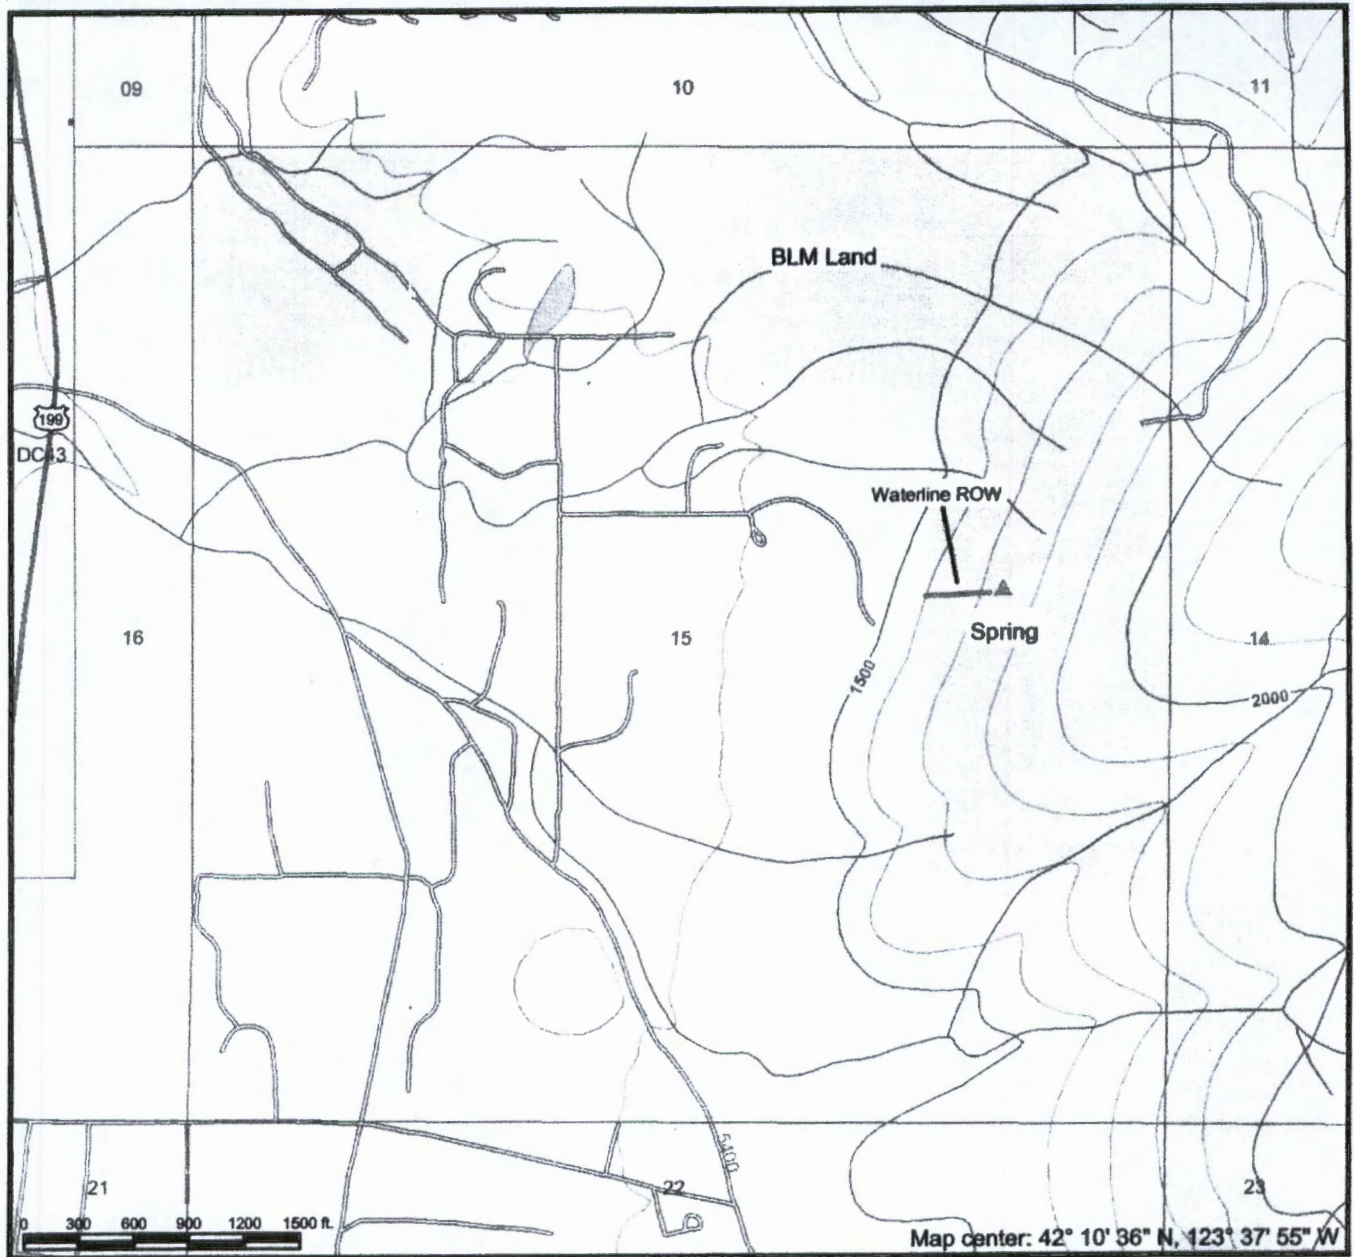

- ☐ Forest Operations Inventory
- ☐ TPCC
- ☐ Township and Range
- ☐ Sections

- Non BLM ☐ Lakes
- ☐ Streams
- ☐ Wetlands
- ☐ Highways
- ☐ Roads
- ☐ Trails

RECEIVED BY OWRD

SEP 26 2016

SALEM, OR



Internal Use Only



United States Department of the Interior
Bureau of Land Management
Medford District Office
3040 Biddle Road
Medford, OR 97504


Printed: Nov 1, 2010 3:37:53 PM
http://web.maps.or.blm.gov/foi_section

Scale 1:12,000
Universal Transverse Mercator
Zone 10, North American Datum of 1983

Designed For: OWRD
 Designed By: JON CARROLL
 Date: 7-28-16
 Scale: N/A

Hunter Industries Incorporated • The Irrigation Innovators
 1940 Diamond Street • San Marcos, CA 92069 • U.S.A. • Tel: (760) 744-5240 • Fax: (760) 471-9626
 www.hunterindustries.com

Hunter®
 DIAGRAM 1A

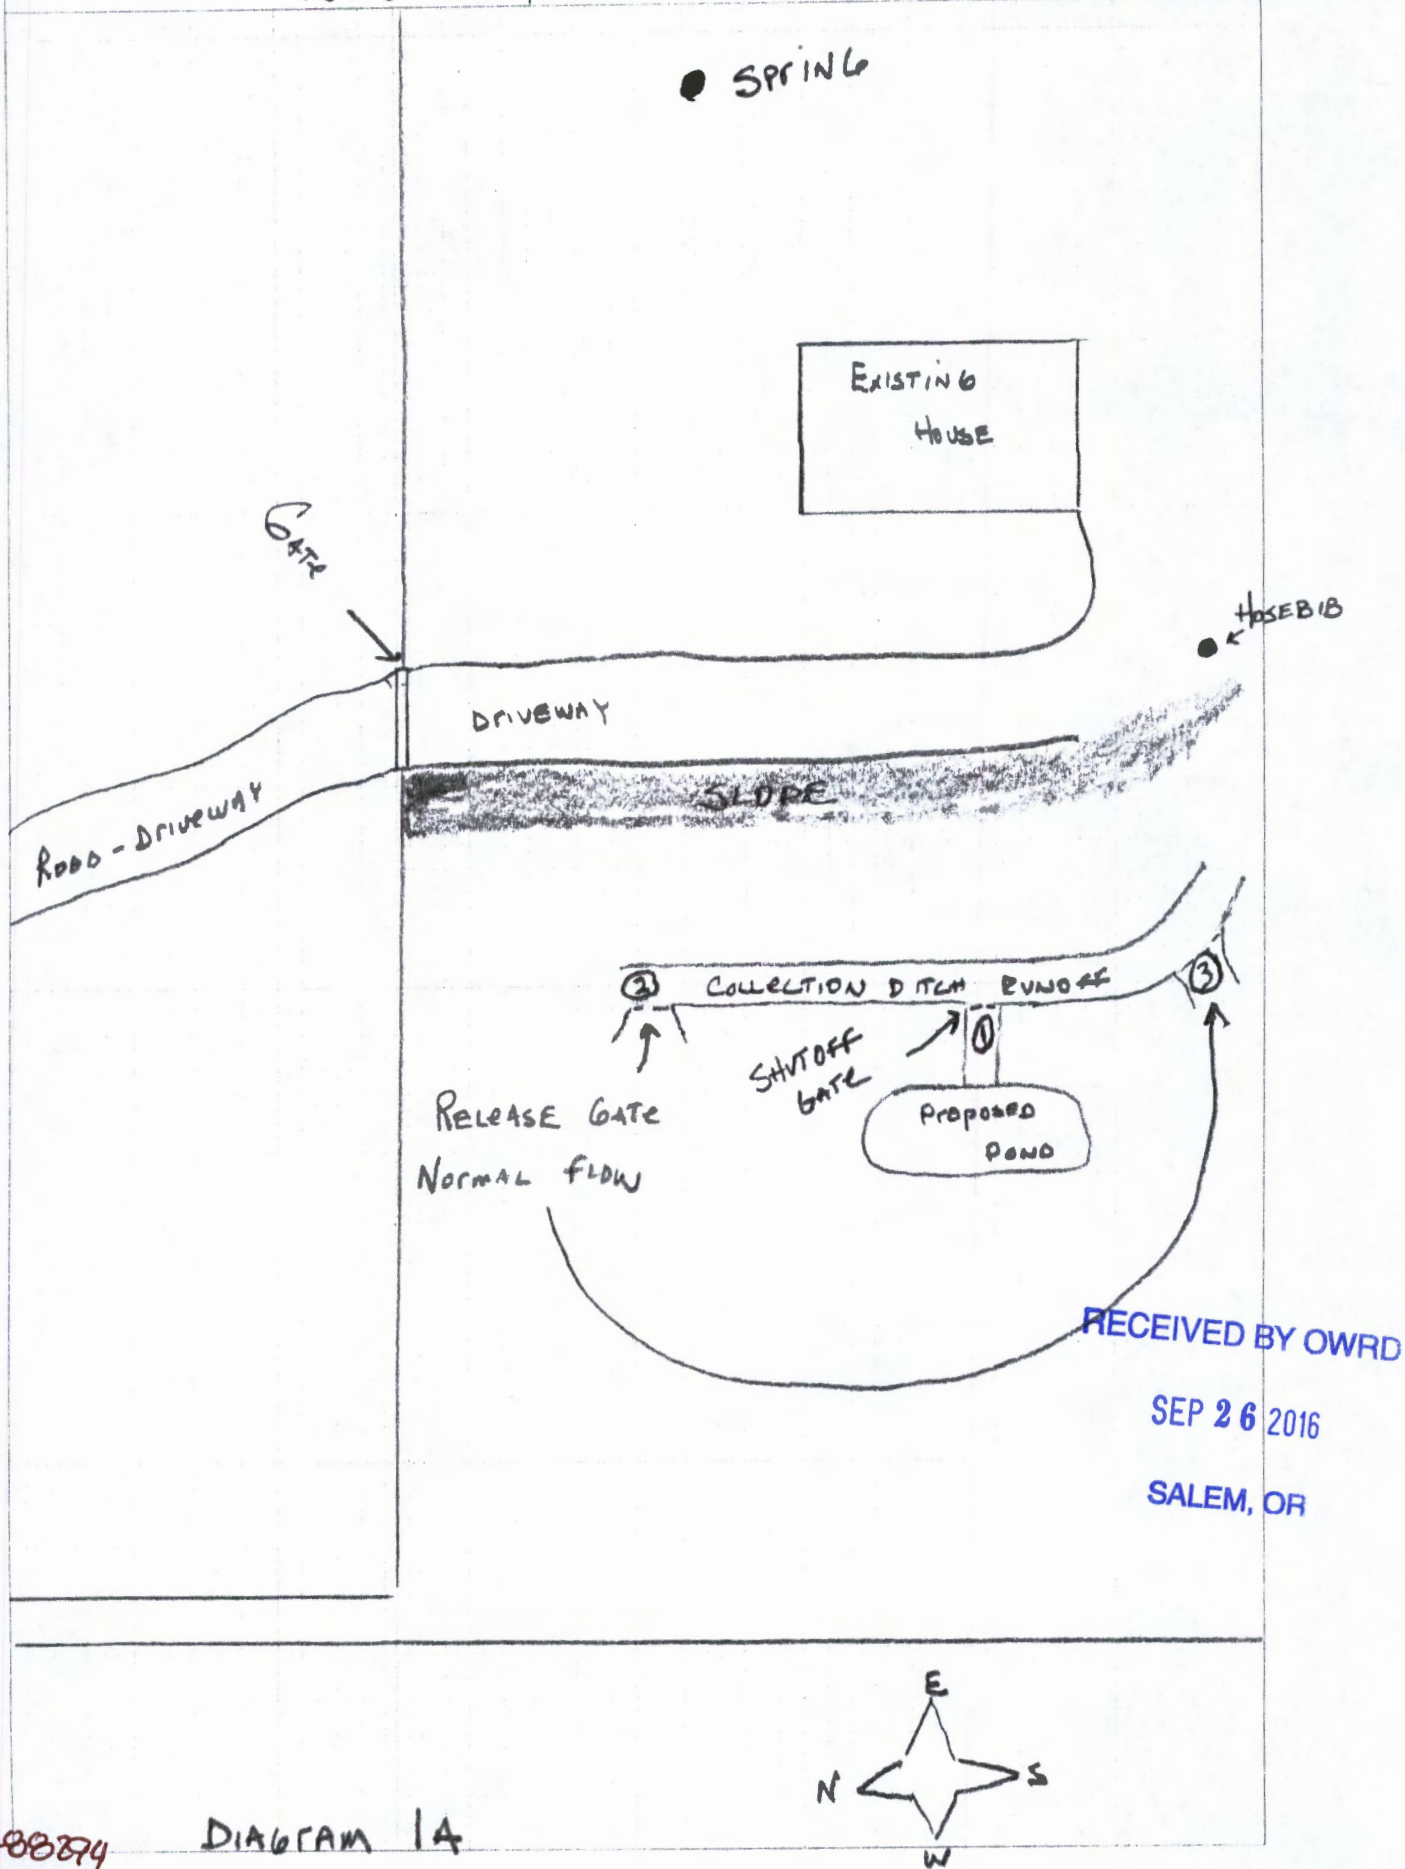

R-88874 DIAGRAM 1A