↑ N

This map was prepared for Assessment & Taxation purposes only and was NOT prepared nor is it suitable for legal, engineering or surveying purposes.

SCALE 1"=200'

NE1/4 SEC 7 T4N R29E WM
UMATILLA COUNTY

4N 29 07A
AERIAL PHOTO NO NZ 1P 125

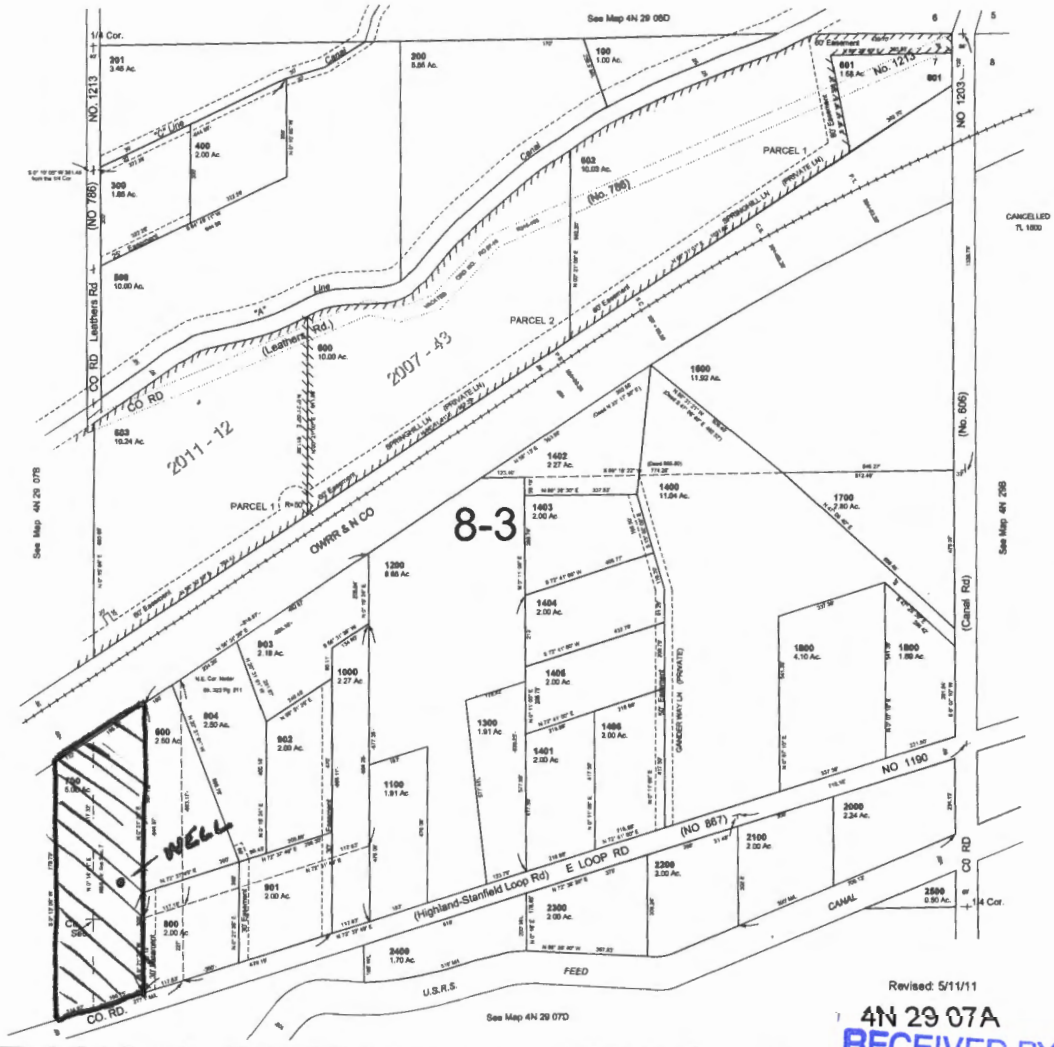

RECEIVED BY OWRD

SEP 28 2016

SALEM, OR

Acres to be irrigated all in section 7

- .8ac NW/SE
- .7ac NE/SW

1.4ac SE/NW
2.1ac SW/NE

Well located 120 ft north and 100 ft east from center of section 7

G-18394

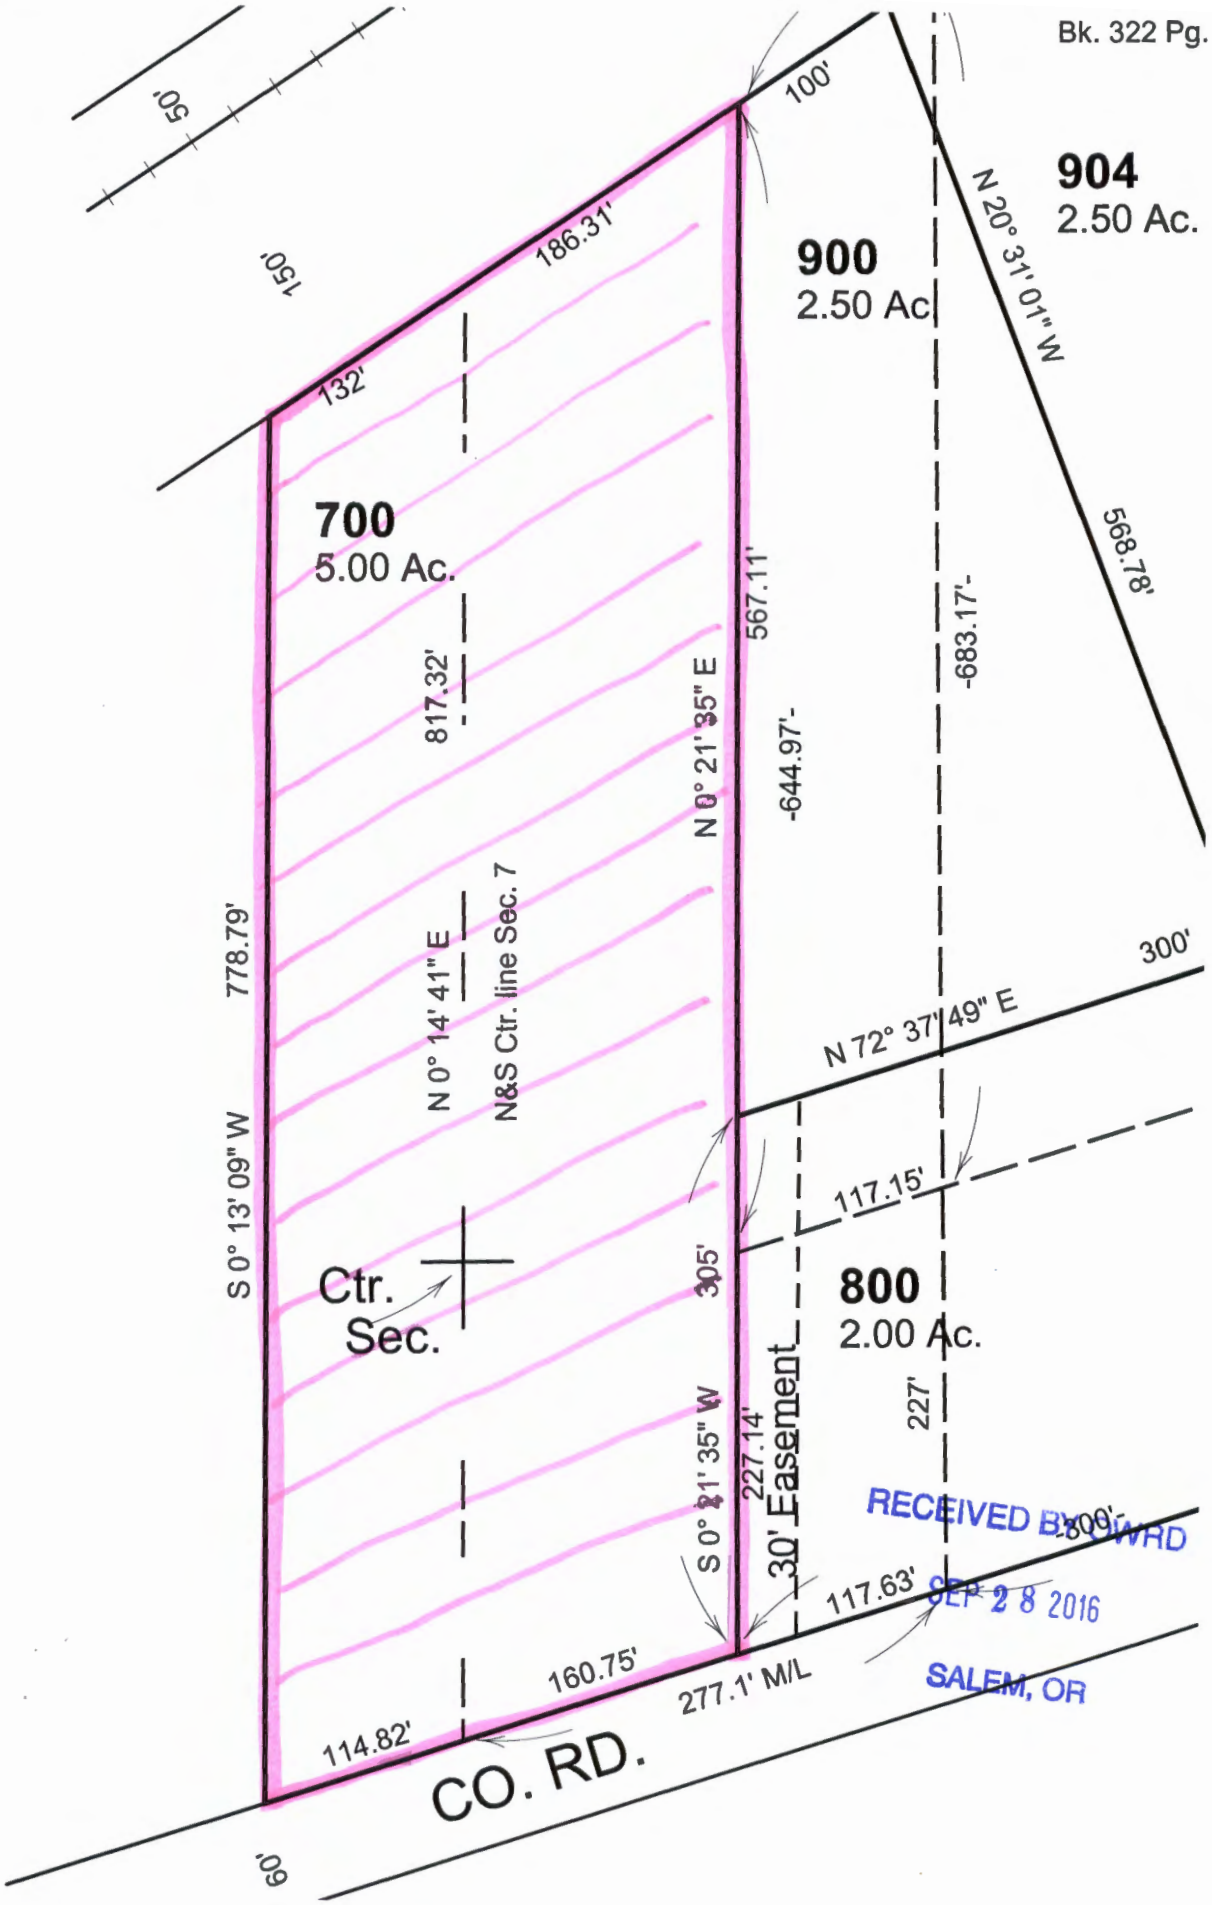

RECEIVED BY OWRD
SEP 28 2016
SALEM, OR

G-18394