

S.E. 1/4 SEC. 5 T.4S. R.2E. W.M.
Clackamas County
1" = 200'


D.L.C.
FRANCIS T. HOWARD NO. 46

103
104
301
500
590
580
690
692
693
703
704
705
792
793
801
891
901
1000
1401

SEP 22 2016

SALEM, OR

Parcel Boundary
 Private Road ROW
 Historical Boundary
 Railroad Centerline
 Tax Code Lines
 Map Index
 Waterlines
 Land Use Zoning
 Plats
 Water
 Corner
 Section Corner
 1/10th Line
 Govt Lot Line
 DLC Line
 Meander Line
 PLSS Section Line
 Historic Corner 40
 Historic Corridor 20

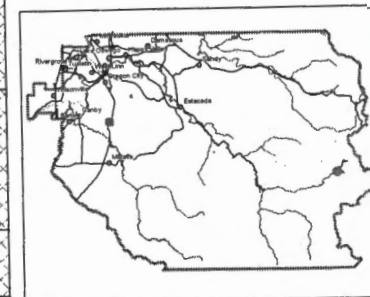



THIS MAP IS FOR ASSESSMENT PURPOSES ONLY

[illegible]

4 2 E 05 D

66581-5

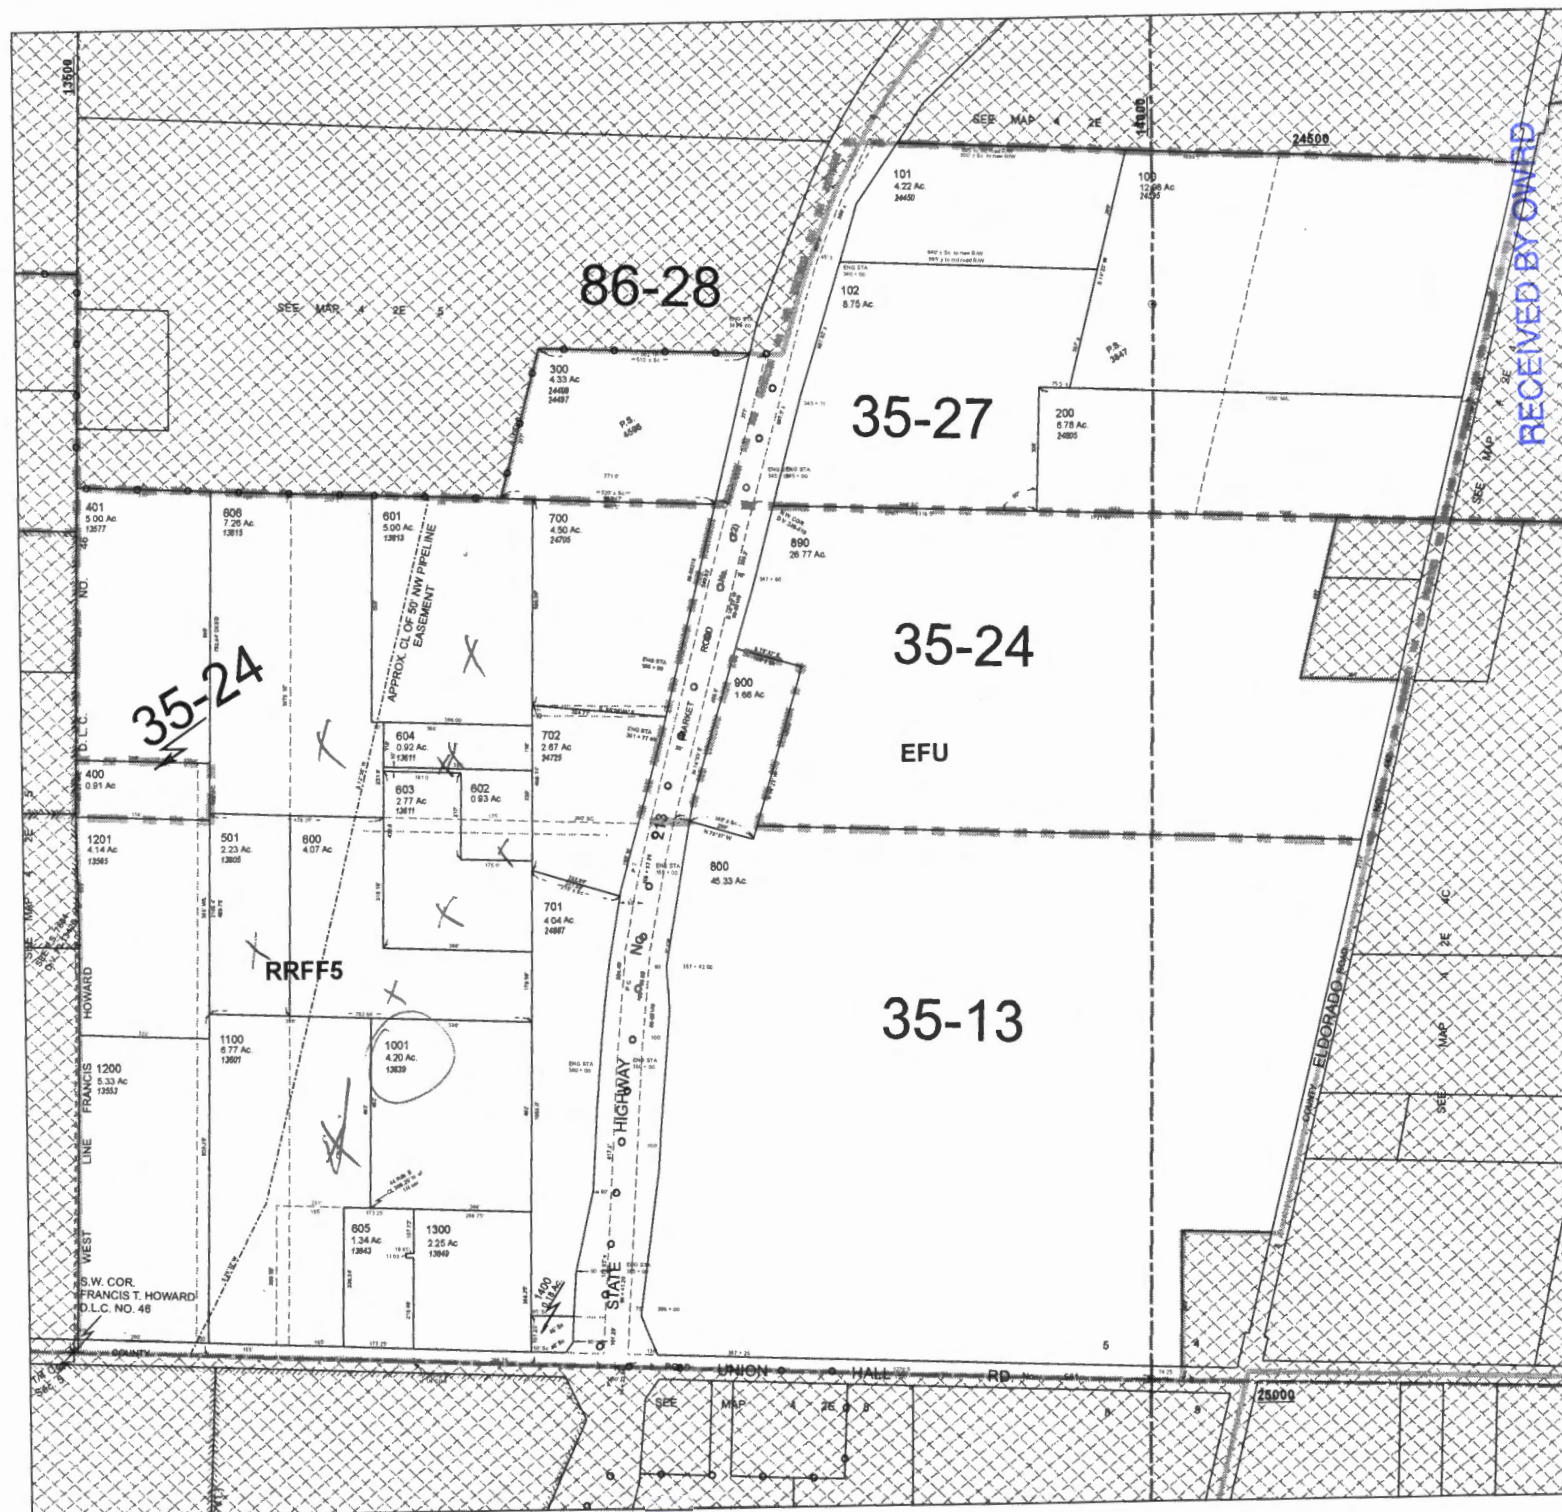

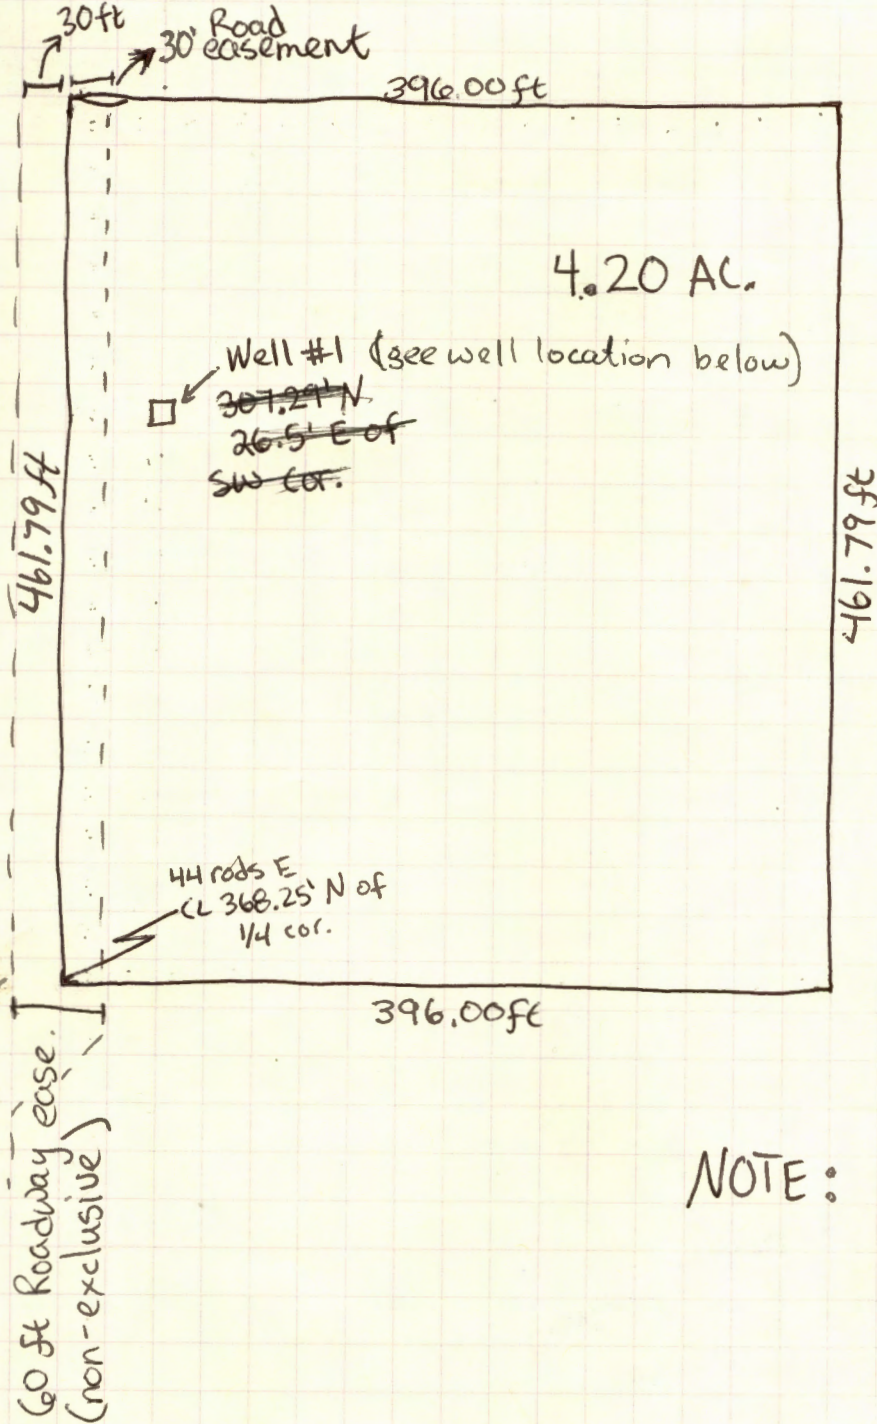

290



Township 4S

Rang 2E

Section 5SW 1/4 SE 1/4

Tax lot 01001

NOTE: Proposed area of Use is all area within identified property

Well Location

650.1 ft N

1335.0 ft E

From South Corner Corner of Section 5

SCALE

1" = 100 ft

G-18299

RECEIVED BY OWRD

SEP 22 2016

RECEIVED BY OWRD

OCT 14 2016

SALEM, OR

Located x N ft
x E ft
from SW corner
of Howard corner

this is to the well not the corner

~~650.1~~ 650.1 ft N
1335.0 ft E
from S corn. corn.
of Sec. 5

RECEIVED BY OWRD

OCT 14 2016

SALEM, OR

288.75

173.25

165

165

290