

MAP LEGEND




1" = 400'

2 N 5 W Sec 34

NE/SW T.L. 801

+ SW/SE T.L. 1000

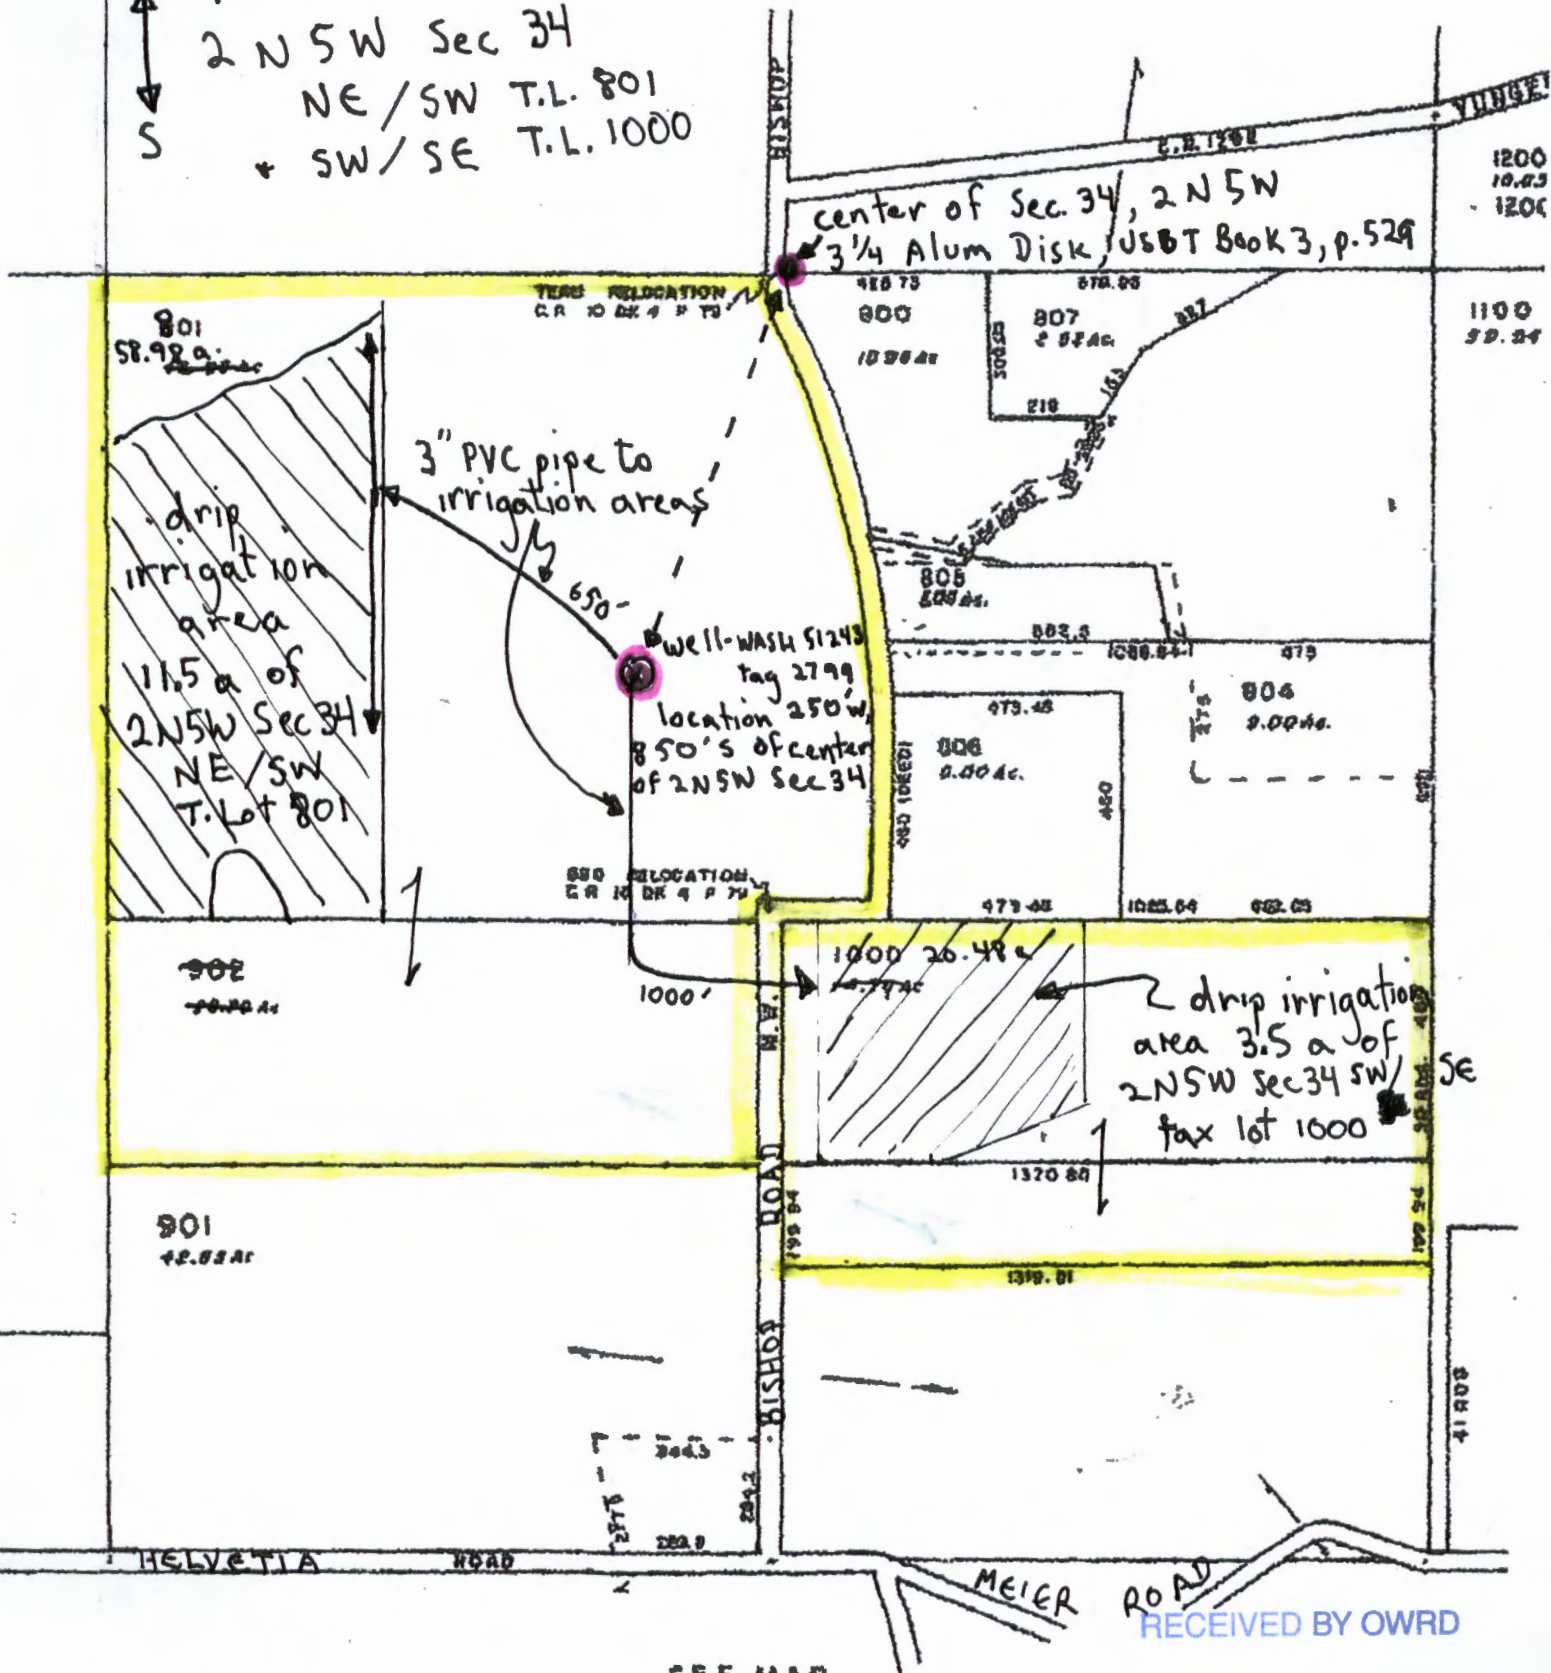

SEE MAP

RECEIVED BY OWRD

NOV 03 2016

SALEM, OR

G-18409


SECTION 34 T2N R2W W.M.
WASHINGTON COUNTY OREGON

SCALE 1"=400'

For location only..
* See larger map for project details

SEE MAP
2N 2 27

2N

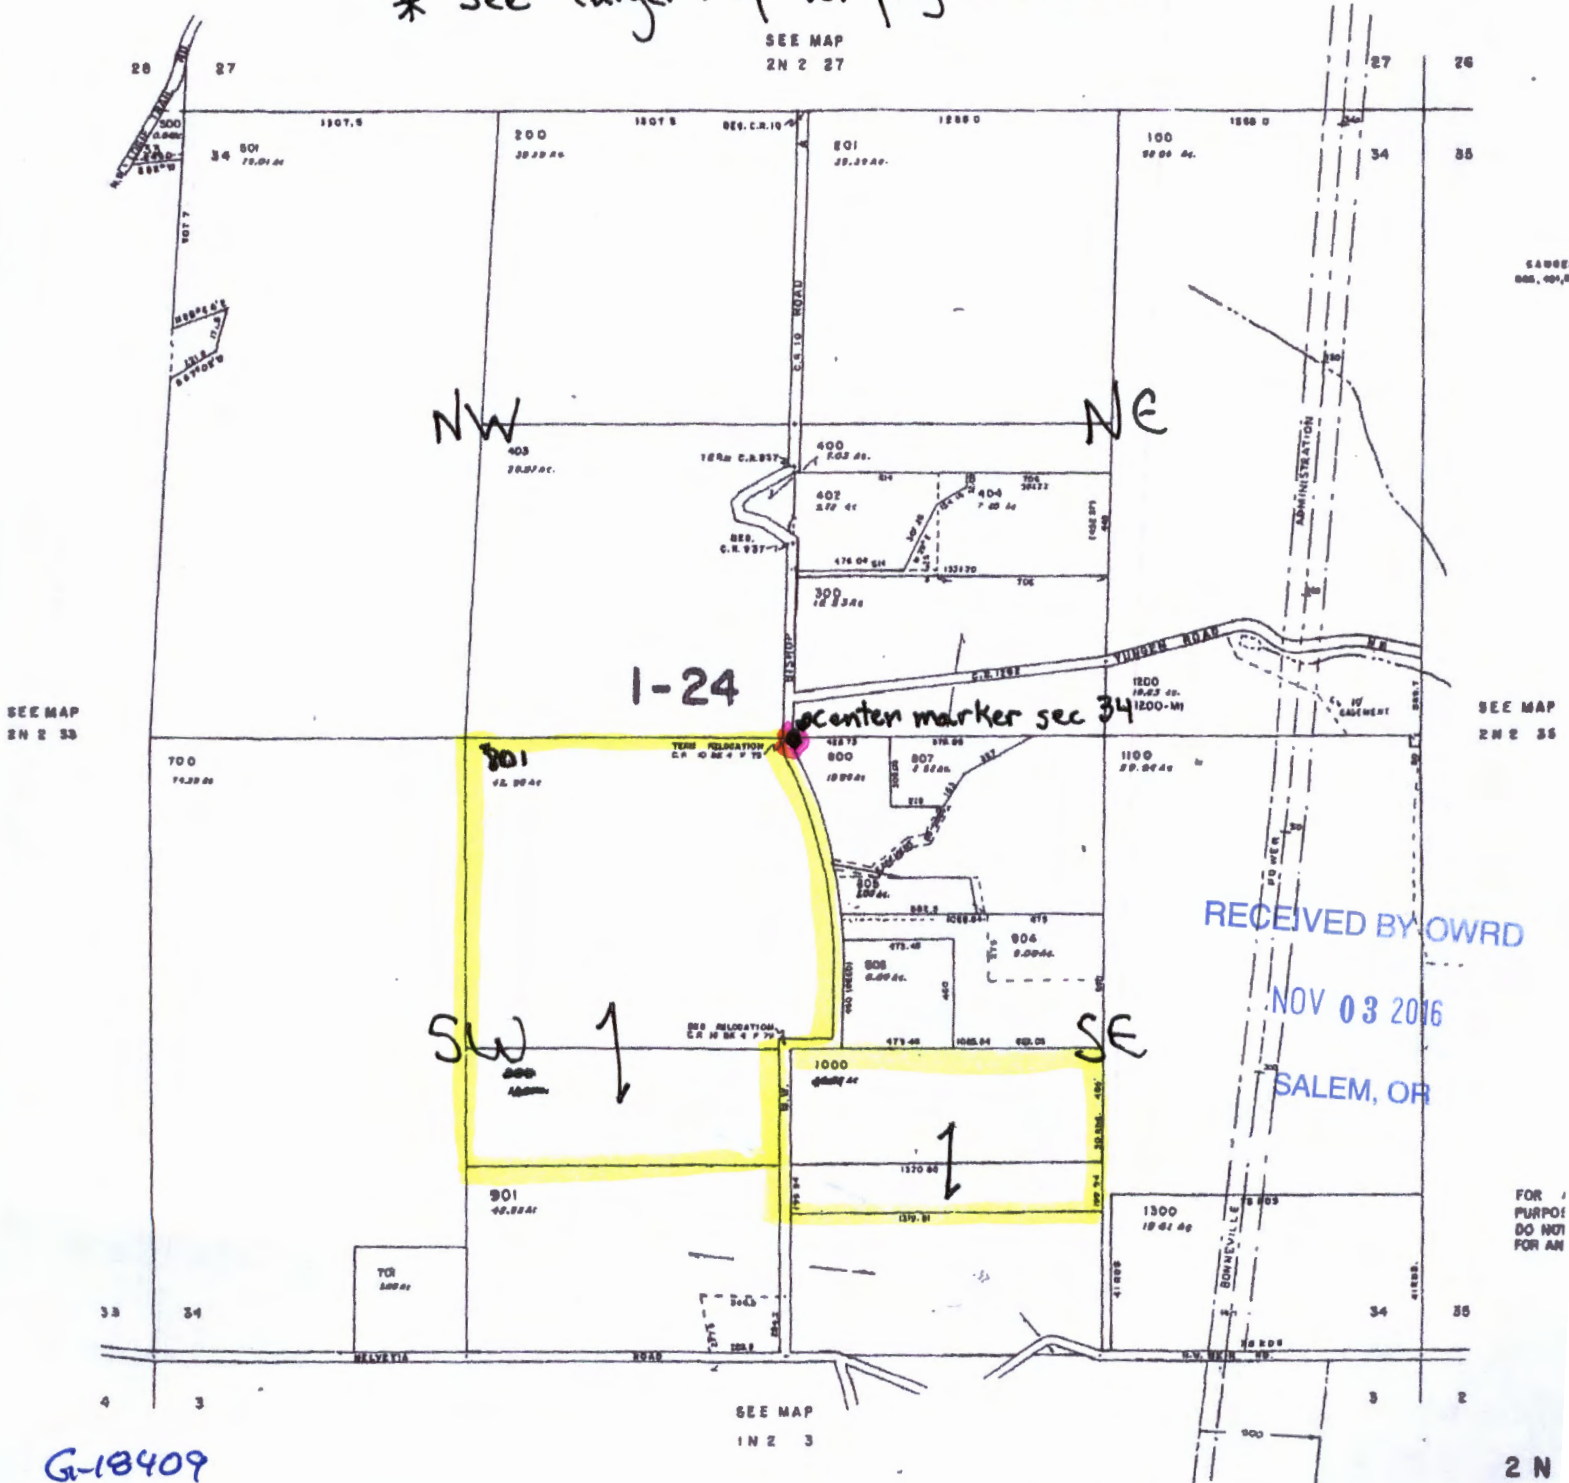

G-18409