


T. 37 S., R. 2 W.

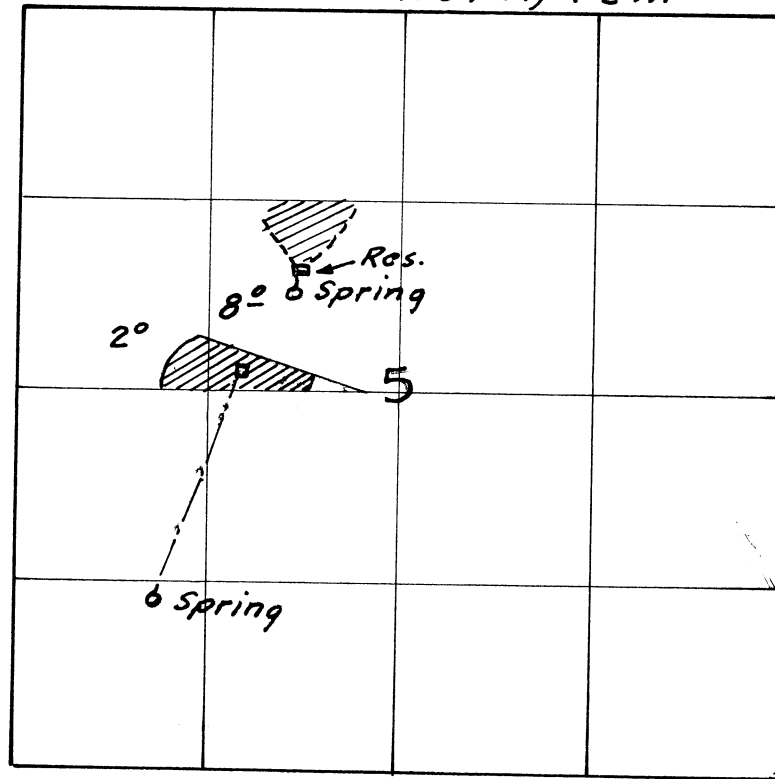

sketched from app map
acreage from proof

A. — 22479