


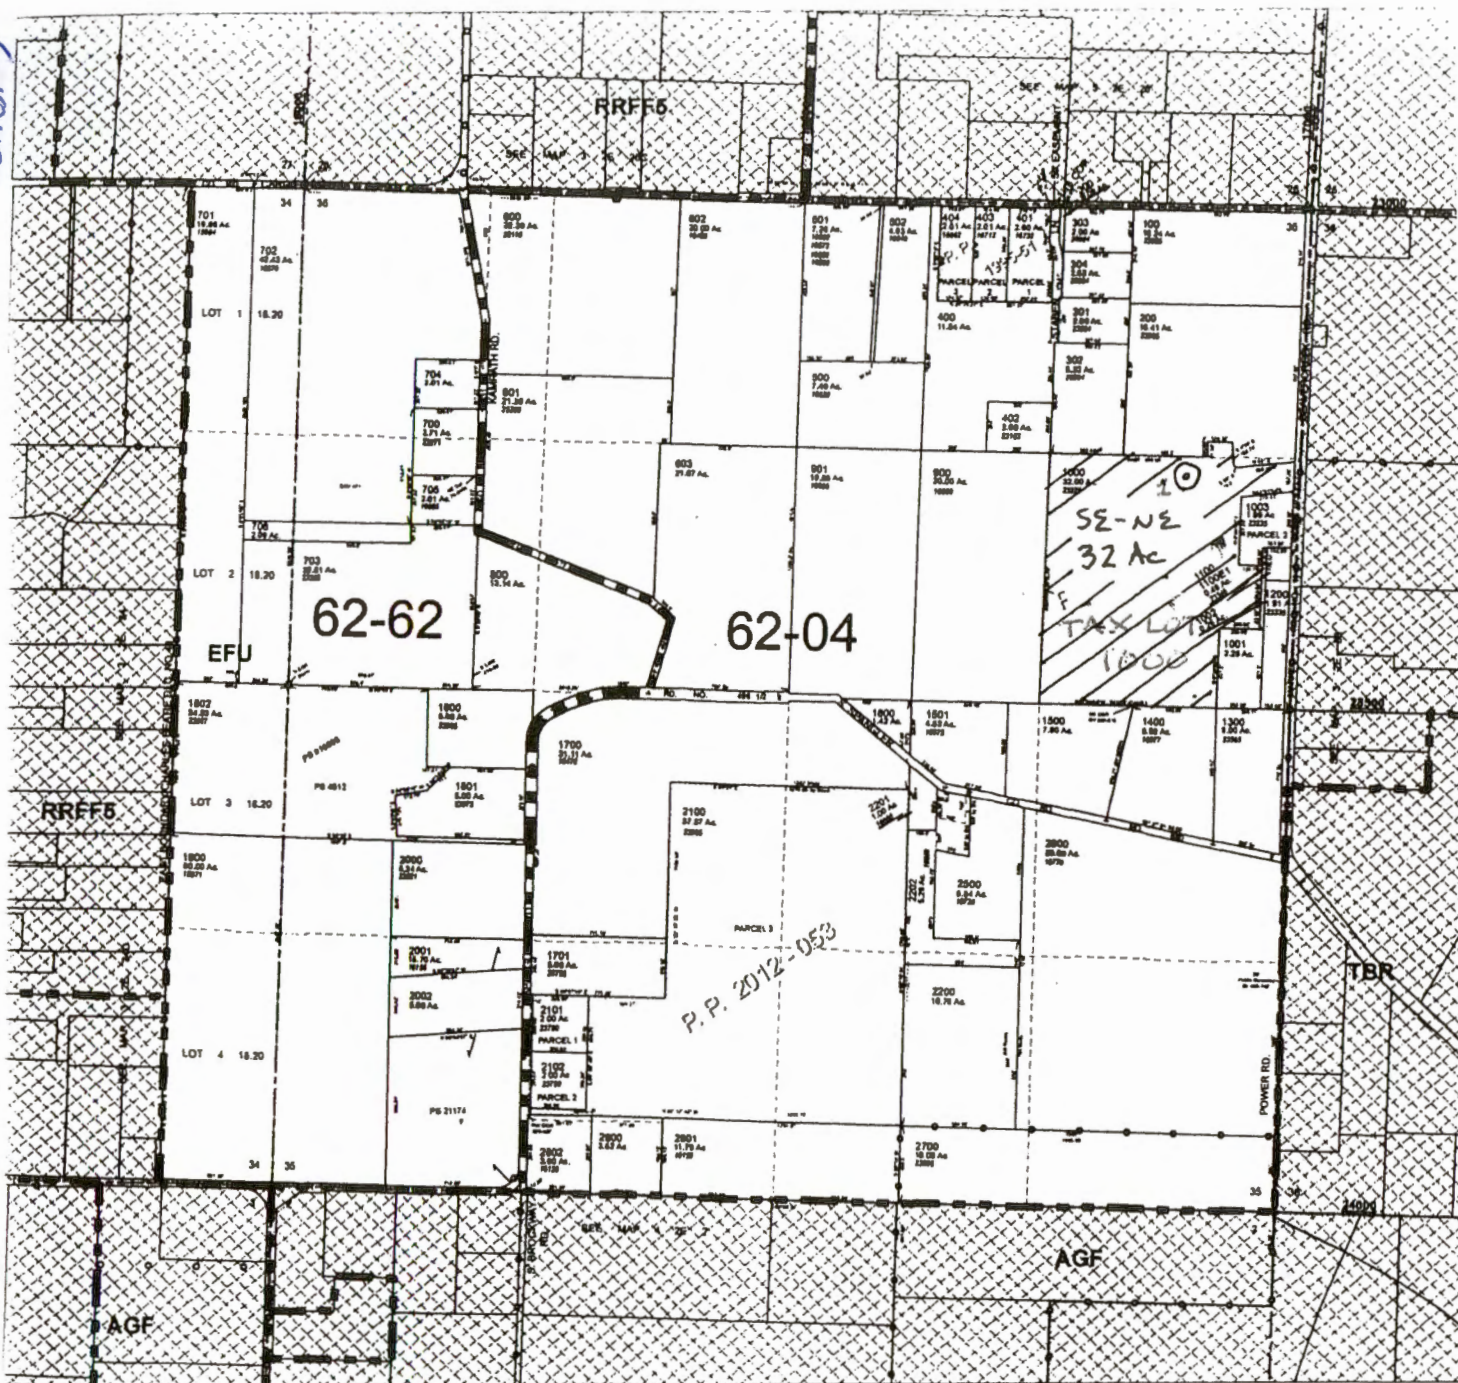

T 35 R 2 E
 Section 35
 1" = 1000'

Well is located 3850 ft N
 and 600' W from the SE
 corner of section 35

3850



RECEIVED

DEC 28 2016

WATER RESOURCES DEPT
 SALEM, OREGON

SE corner section 35

600'

ZONED - EFU