


TENT 308

75 FEET SOUTH AND 132 FEET EAST FROM NW CORNER, SECTION 14
SEC.14 T9S R6W WM POLK COUNTY Scale 1" = 400'

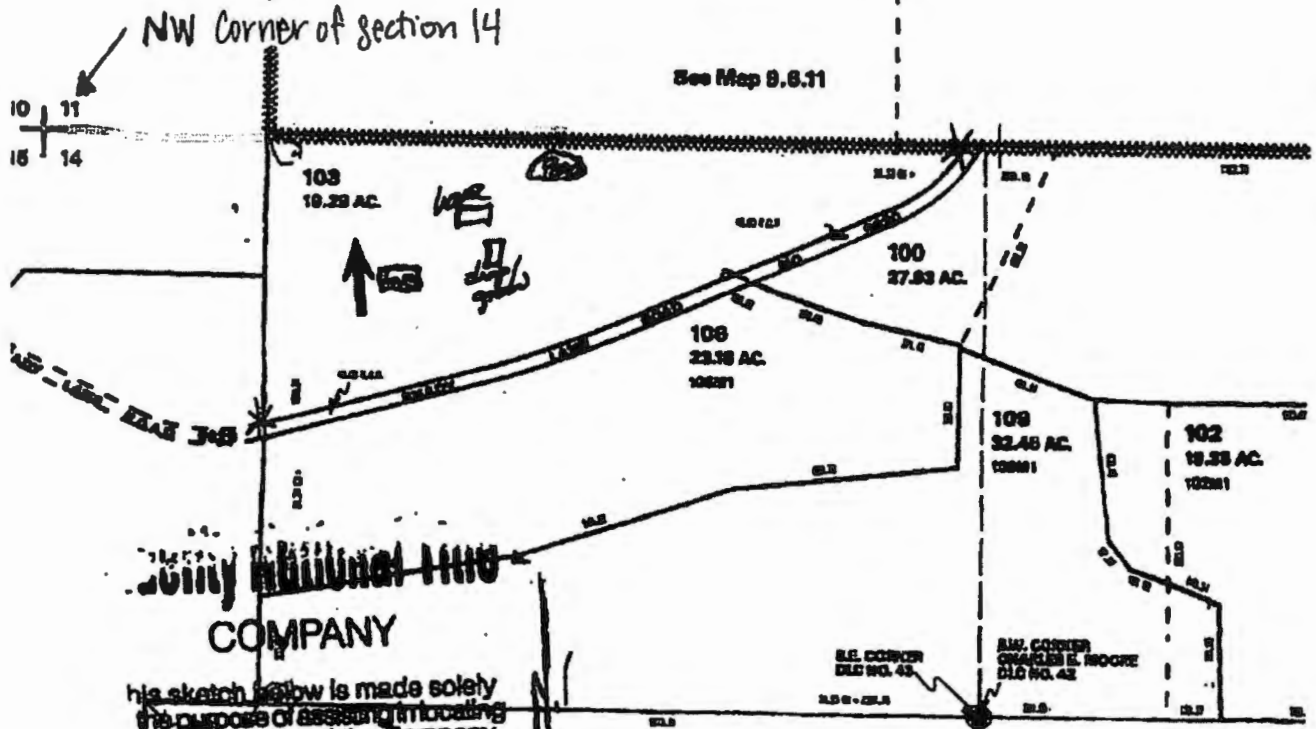

COMPANY

This sketch is made solely for the purpose of assessing and locating the premises and the Company assumes no liability for variations, if any, in dimensions and location ascertained by actual survey.

* PROPERTY CORNERS ON SHADY LANE ARE MARKED WITH AN ORANGE RIBBON ON FENCE.

[Signature]
1/12/2017

RECEIVED
JAN 12 2017
OWRD