


Steve + Stacey Kierner
Simple Life Farms, Inc
33815 Bond Rd.
Lebanon OR 97355

T 11 S, R 1 W
Sections 32 & 33

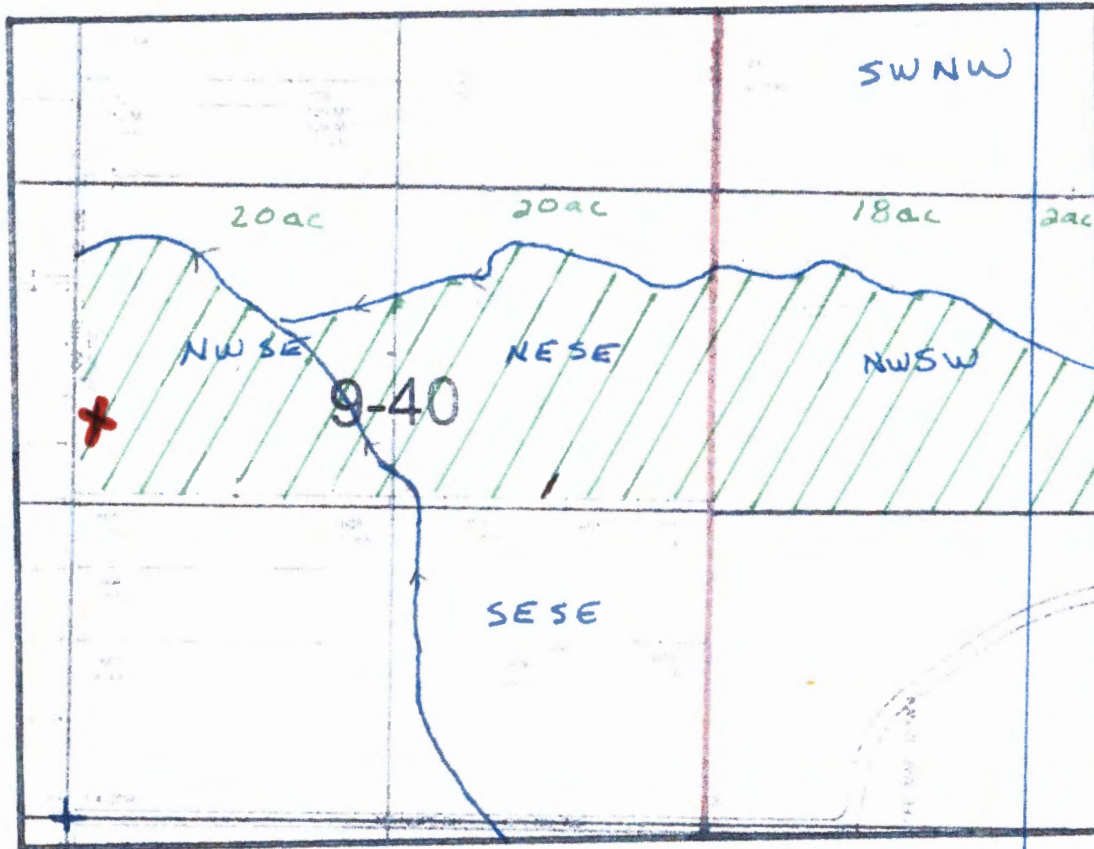

N
1" = 800'

RECEIVED

JAN 11 2017

OWRD

✗ Well #1 located approximately 1600 feet North and 25 feet East;
Well #2 located approximately _____ feet North and _____ feet East;
From the South 1/4 corner of Section 32

1587-15