


SEE MAP 11 10 06

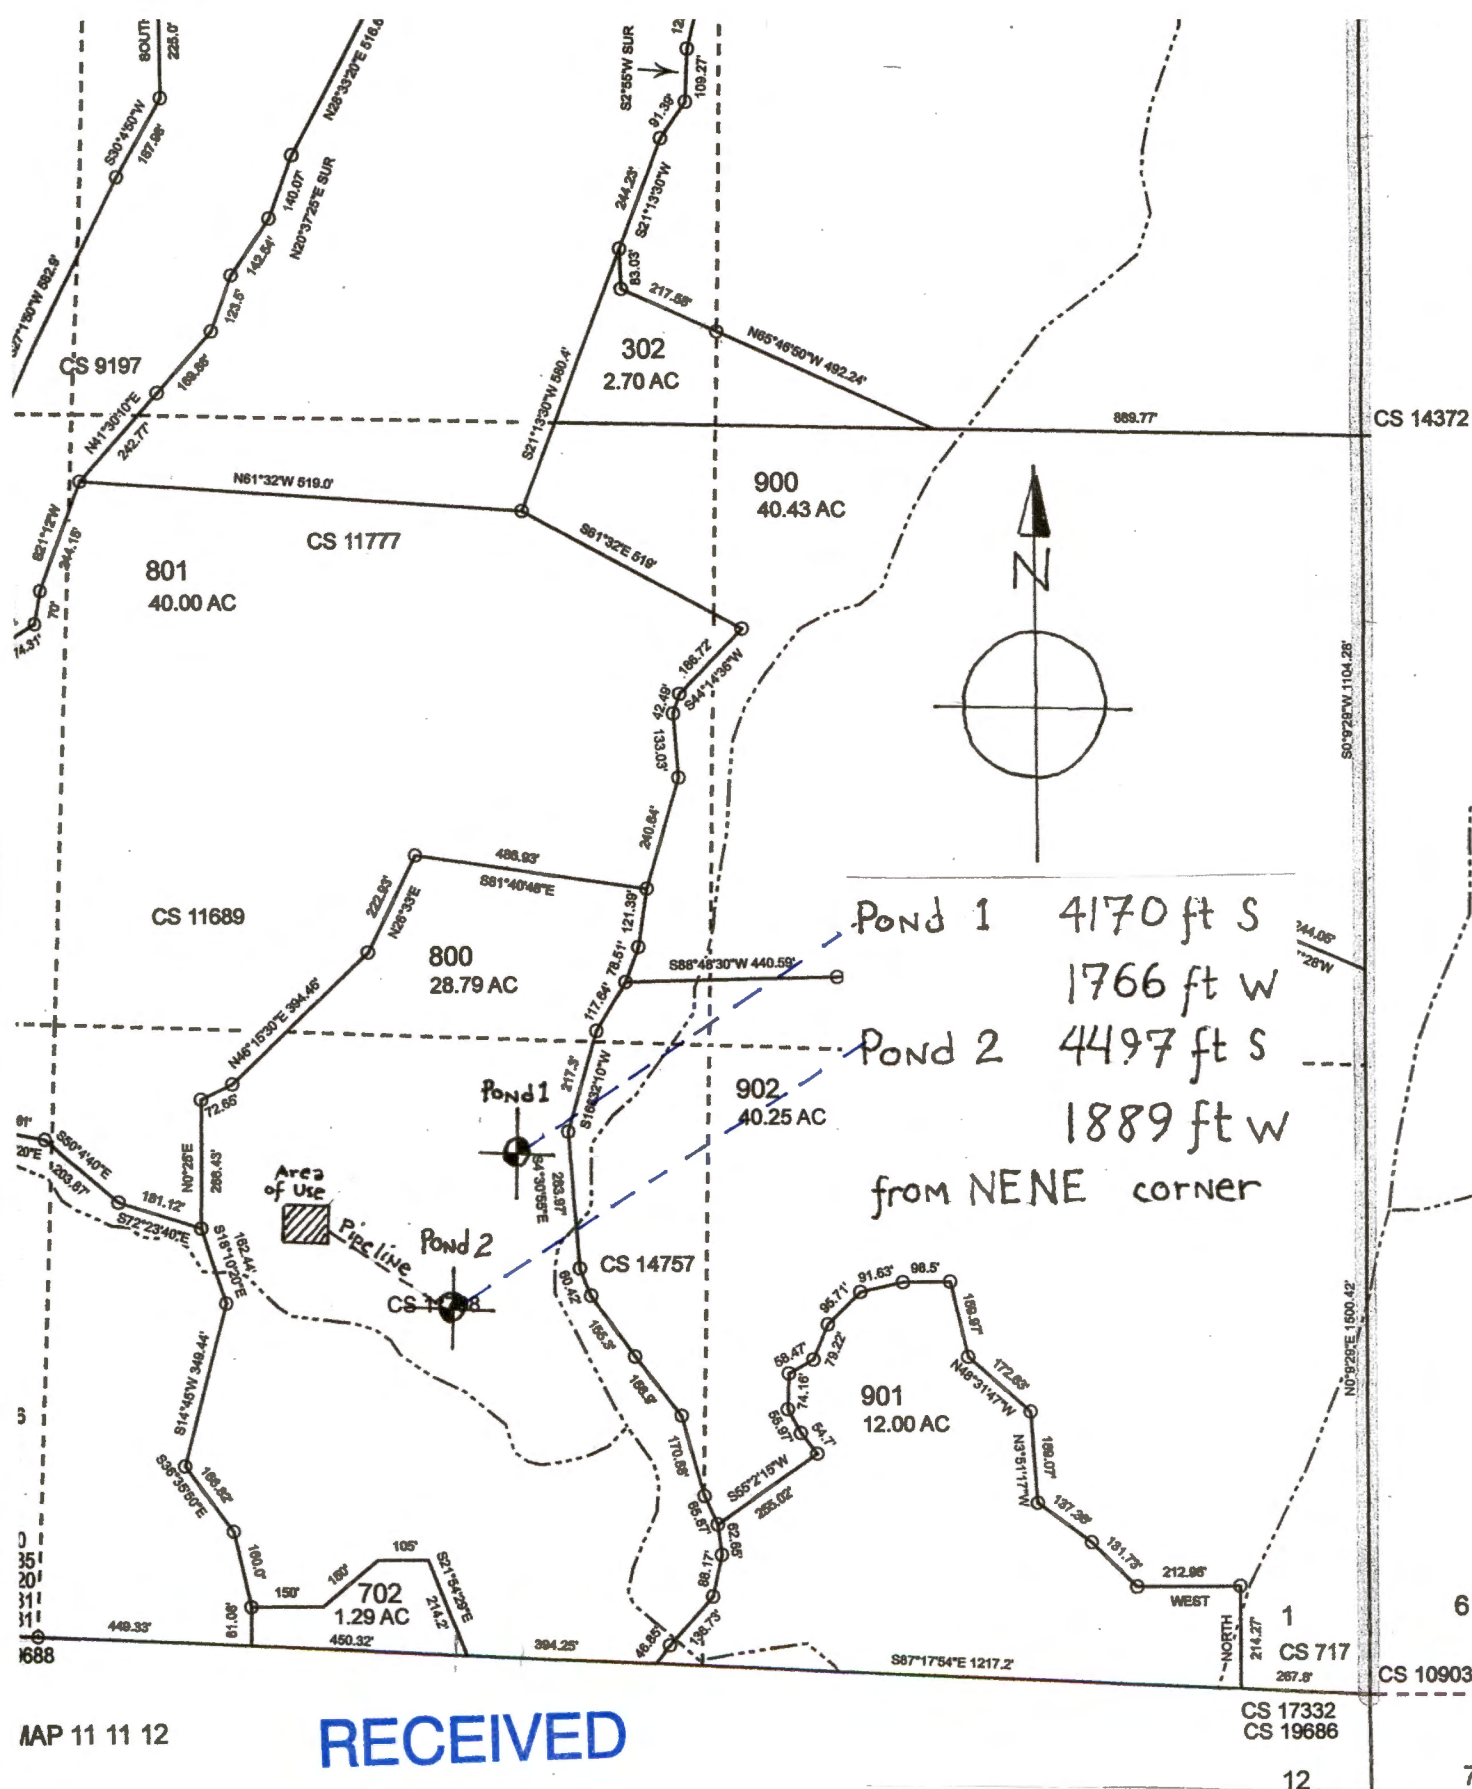

RECEIVED

JAN 12 2017

OWRD

SECTION 1 T.11S. R.11W. W.M. QQ SWSE Tax Lot 800
LINCOLN COUNTY

1" = 400'

R-8837