


# T. 6 S. R. 1 W. W.M.

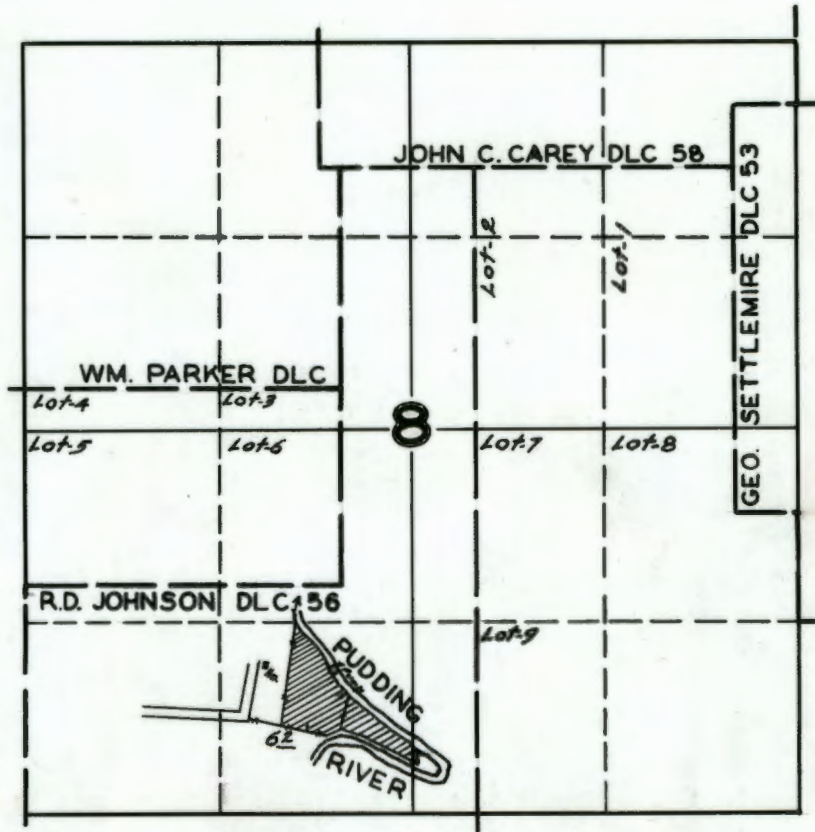

## FINAL PROOF SURVEY UNDER

Application No. 17685 Permit No. 13375

IN NAME OF  
V.L. STEWARD

Surveyed JUNE 9 1944, by J. B. [Signature]