

Groundwater Irrigation Application Map  
 TS 35S, R 4W, Sec 03  
 10 Acres NWNW

33 SESE SE

34

SESW

Reference Corner

Well #1  
 JACK 4688

NENE

NWNW

NENW

04 NE

NW

354W

03

SENE

SWNW

RECEIVED BY OWRD

JAN 18 2017


SALEM, OR

SENW

**Legend**

-  TL 1200/1201
-  Well
-  Place of Irrigation Use

Well #1:  
 1300 ft E and 547 ft S  
 from NW Corner Section 3

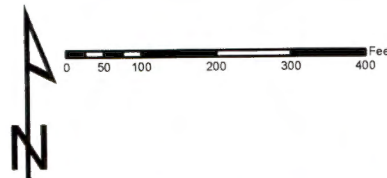

JACKSON COUNTY  
 WATERMASTER

Prepared by Shavon Haynes

This map is based on a digital database compiled by Jackson County from a variety of sources. Jackson County cannot accept responsibility for errors, omissions, or positional accuracy. There are no warranties, expressed or implied.

Date: 12/30/2016 35-4w-03 tl 1200-1201.mxd:haynes