


MAP FOR
Limited License Application
 S8 & S9, T6S, R5W, POLK COUNTY

RECEIVED BY OWRD

JAN 19 2017

SALEM, OR

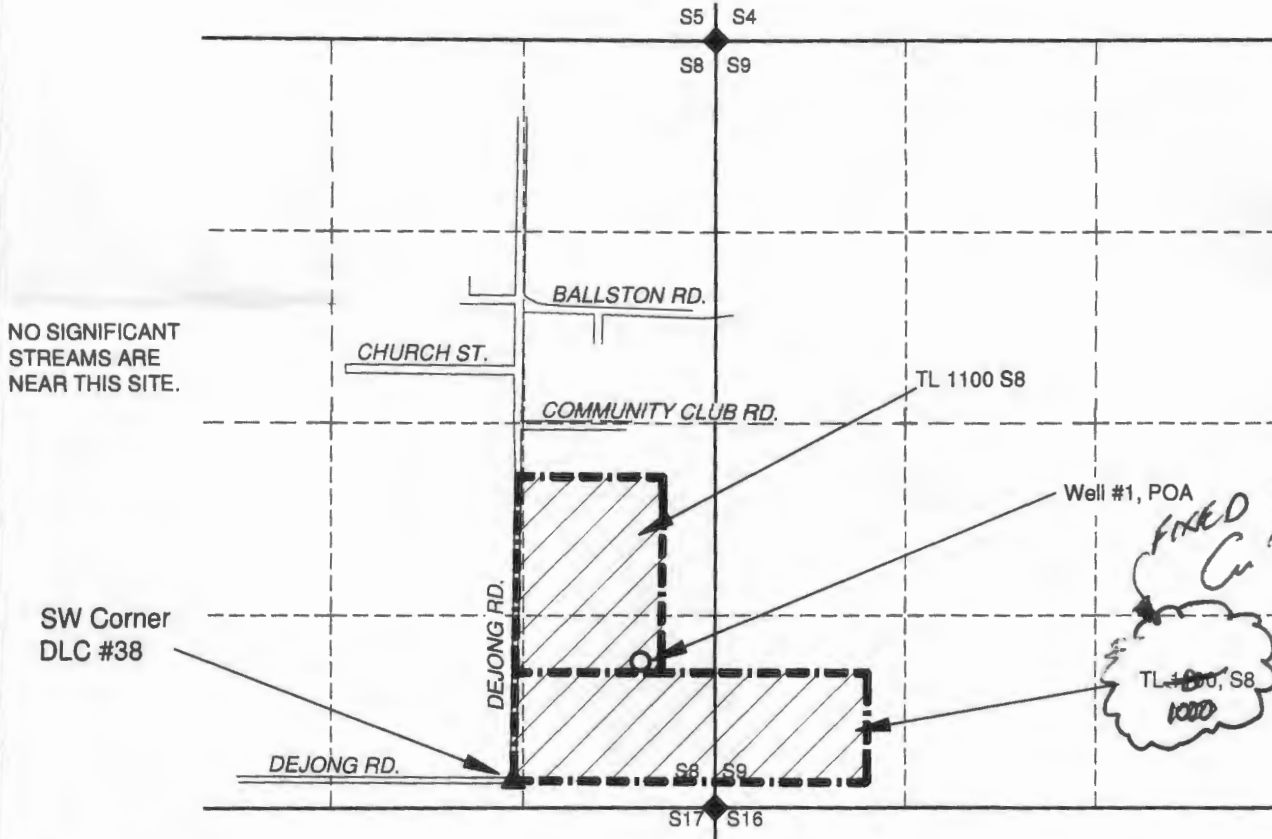

WELL #1 IS 820' N & 875' E FROM SW DLC 38

RECEIVED BY OWRD

DEC 21 2016


SALEM, OR

- LEGEND**
- ▲ DONATION LAND CLAIM (DLC) CORNER
 - STREAM OR SURFACE DRAINAGE
 - ◆ SECTION OR QUARTER CORNER
 - POINT OF APPROPRIATION (WELL)
 - TAX LOT LINE
 - ==== SECTION LINE
 - - - - QUARTER-QUARTER LINE
 - AREA TO BE WATERED BY LIMITED LICENSE
71.8 ACRES



NOTES:

- THIS MAP IS NOT INTENDED TO PROVIDE LEGAL DIMENSIONS OR LOCATIONS OF PROPERTY OWNERSHIP LINES.
- PROPERTY LINES AND QUARTER-QUARTER LINES ARE BASED THE TAX ASSESSOR MAP FOR SECTIONS 8 & 9, T6S, R5W. THE TAX LOTS ARE BOTH SHOWN ON THE TAX ASSESSOR MAP FOR S8.
- WATER CONVEYANCE LINES SHALL BE ALL WITHIN THE PROPERTY AND THEREFORE ARE NOT SHOWN.

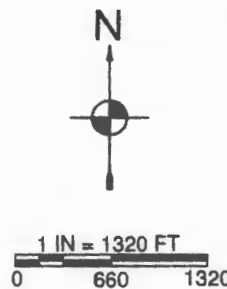

MAP BY:
ASPEN RURAL LAND CONSULTING

ERIC URSTADT, PE, PLS
 971-250-1520
 Dec 2016
 WillVallLand-BallstonLL1

LL-1685