


RECEIVED BY OWRD

JAN 18 2017


SALEM, OR

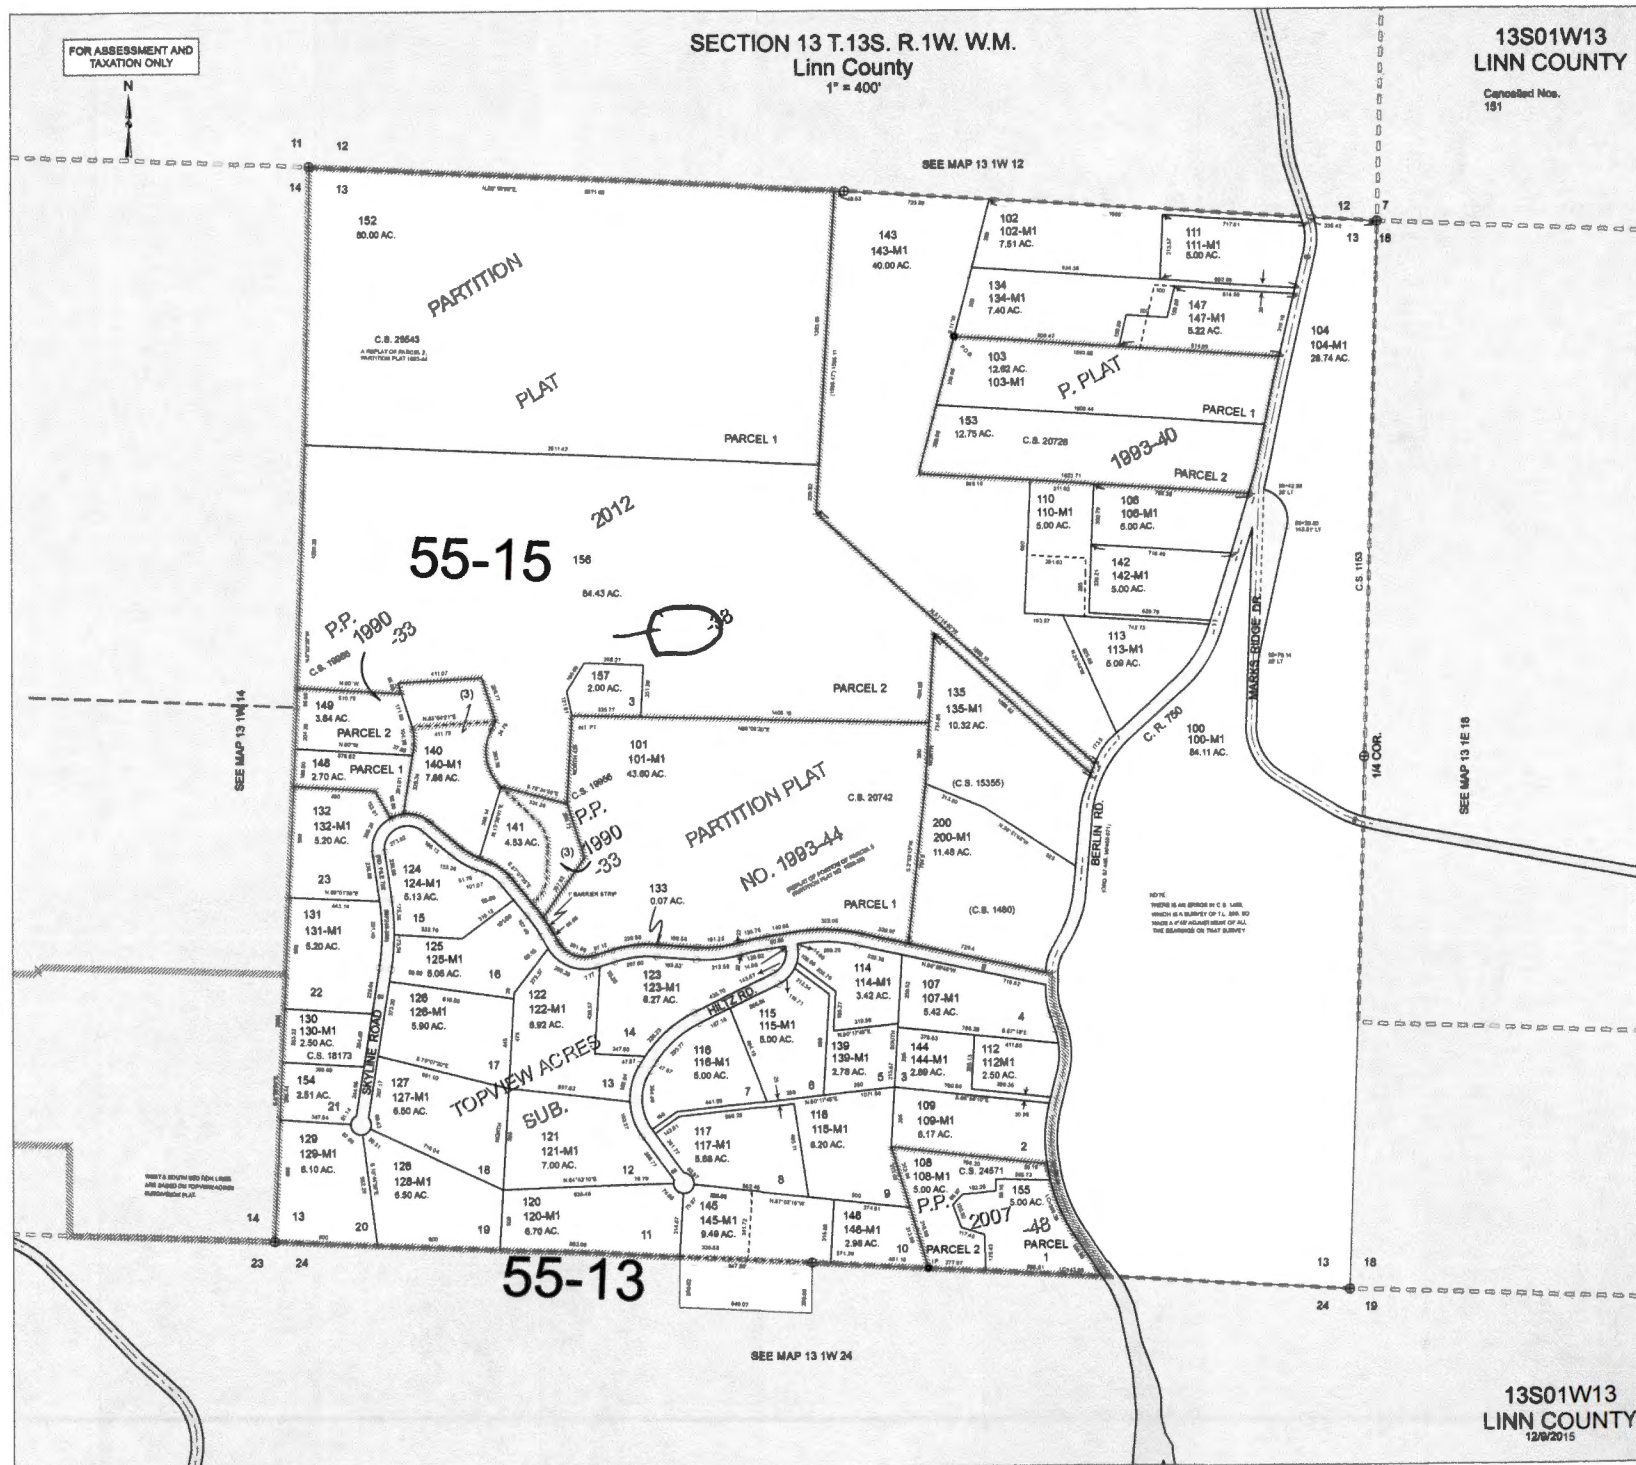

1" = 1320'

Tax Lot: 156

13S1W13

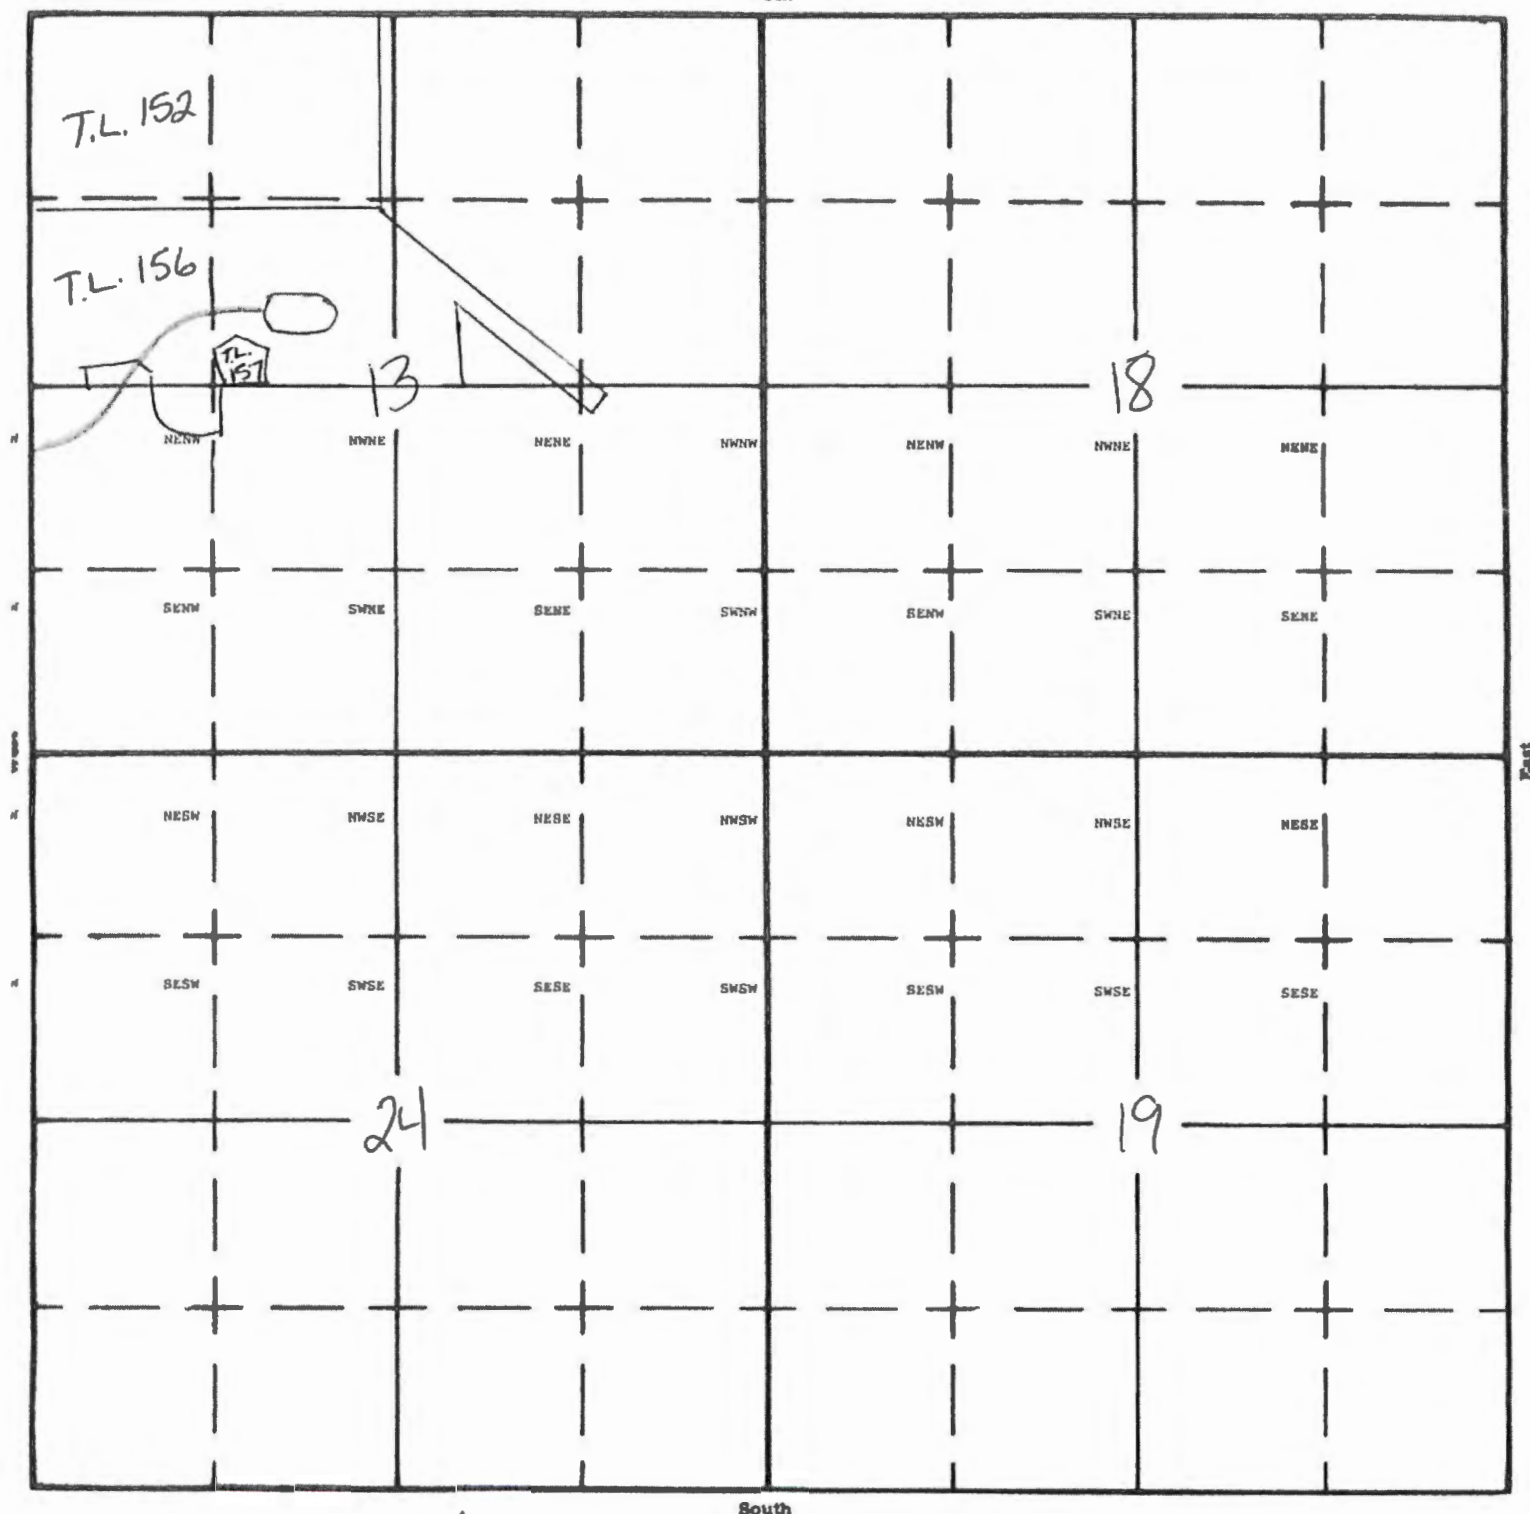

Dam located approximately 400' North and 800' west
from the center corner of Section 13

RECEIVED

JAN 23 2017

OWRD

R-88360


1" = 1320'

Tax Lot: 156

13 S 1 W 13



NW CORNER
OF SEC. 13

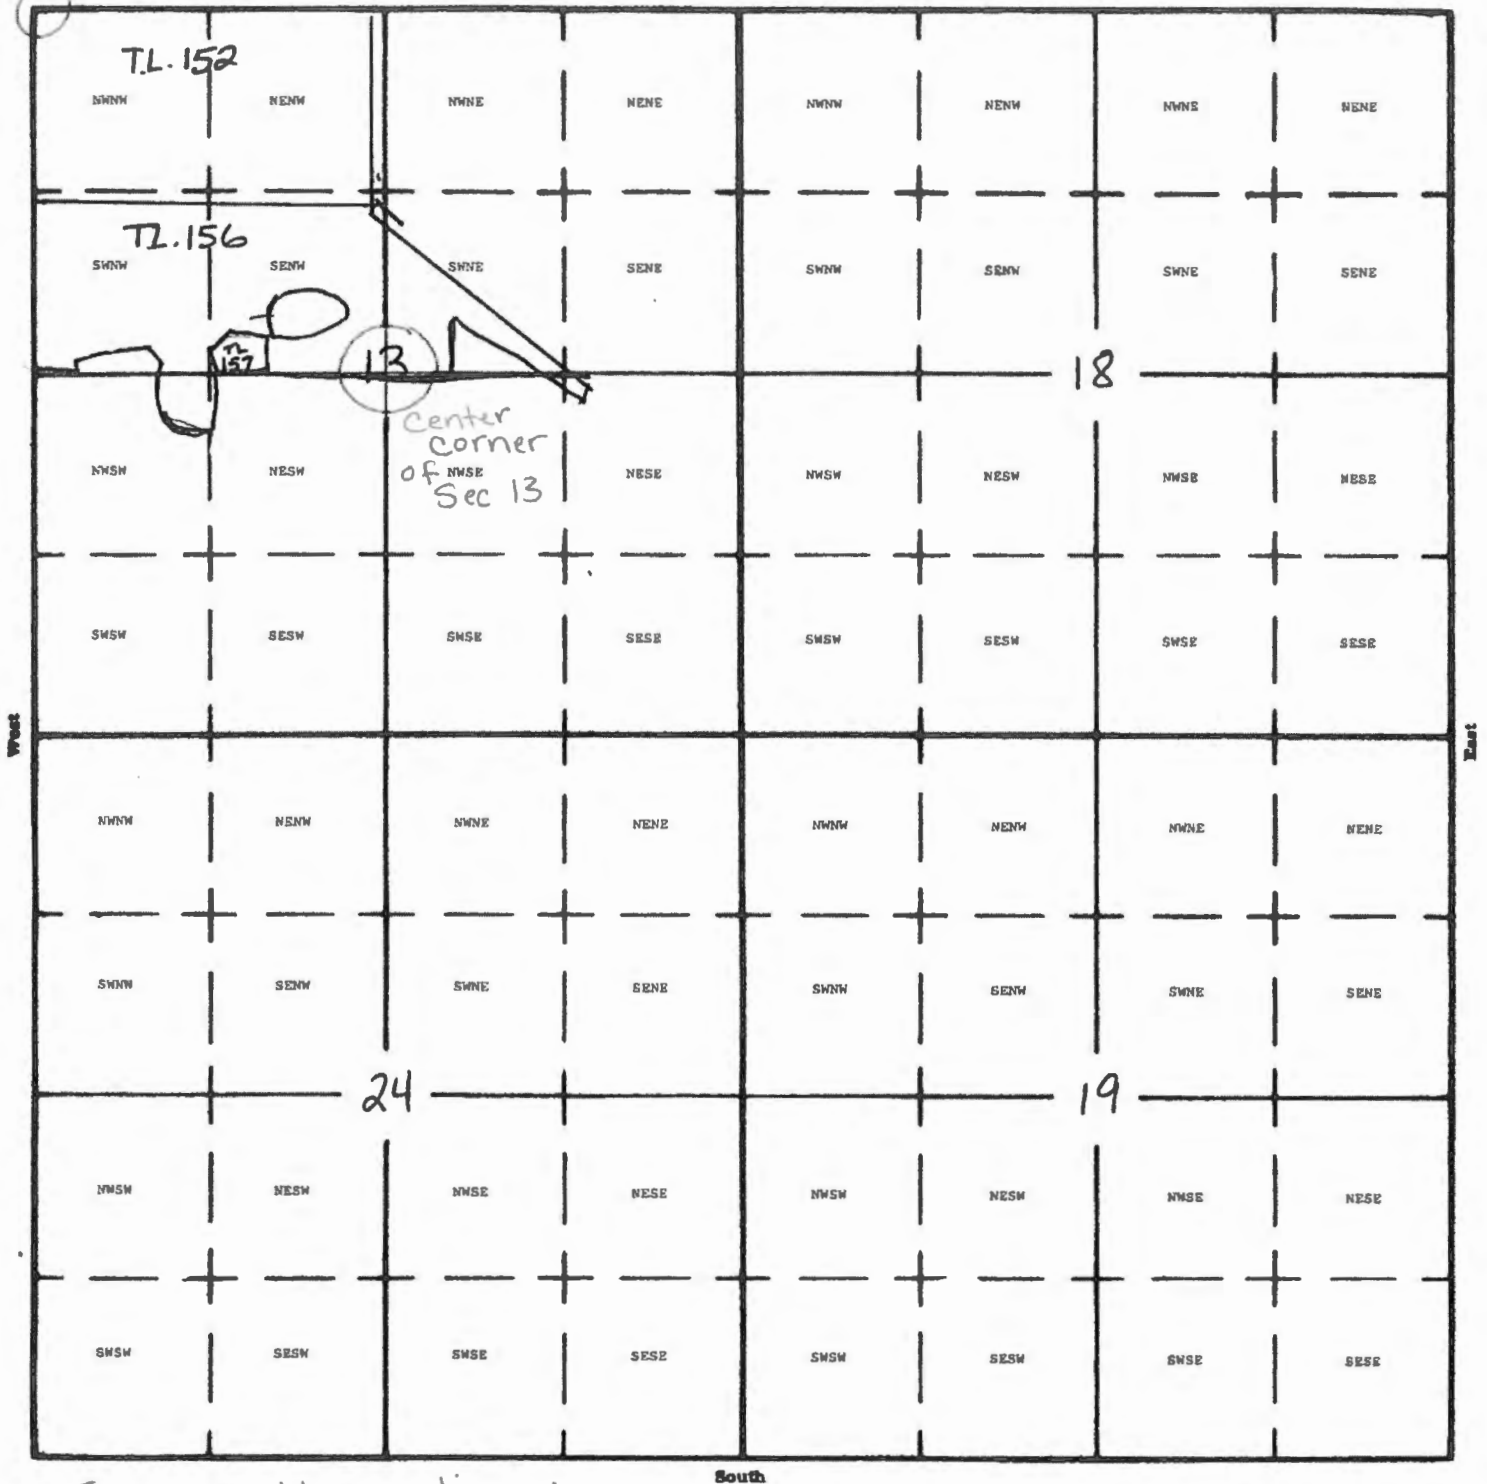

Sample Narrative:

Dam located approx.
395' North and 800' West
from the center corner
of Section 13

R-88360

RECEIVED BY OWRD


JAN 18 2017

SALEM, OR

1" = 1320'

Tax Lot: 156

13 S 1 W 13

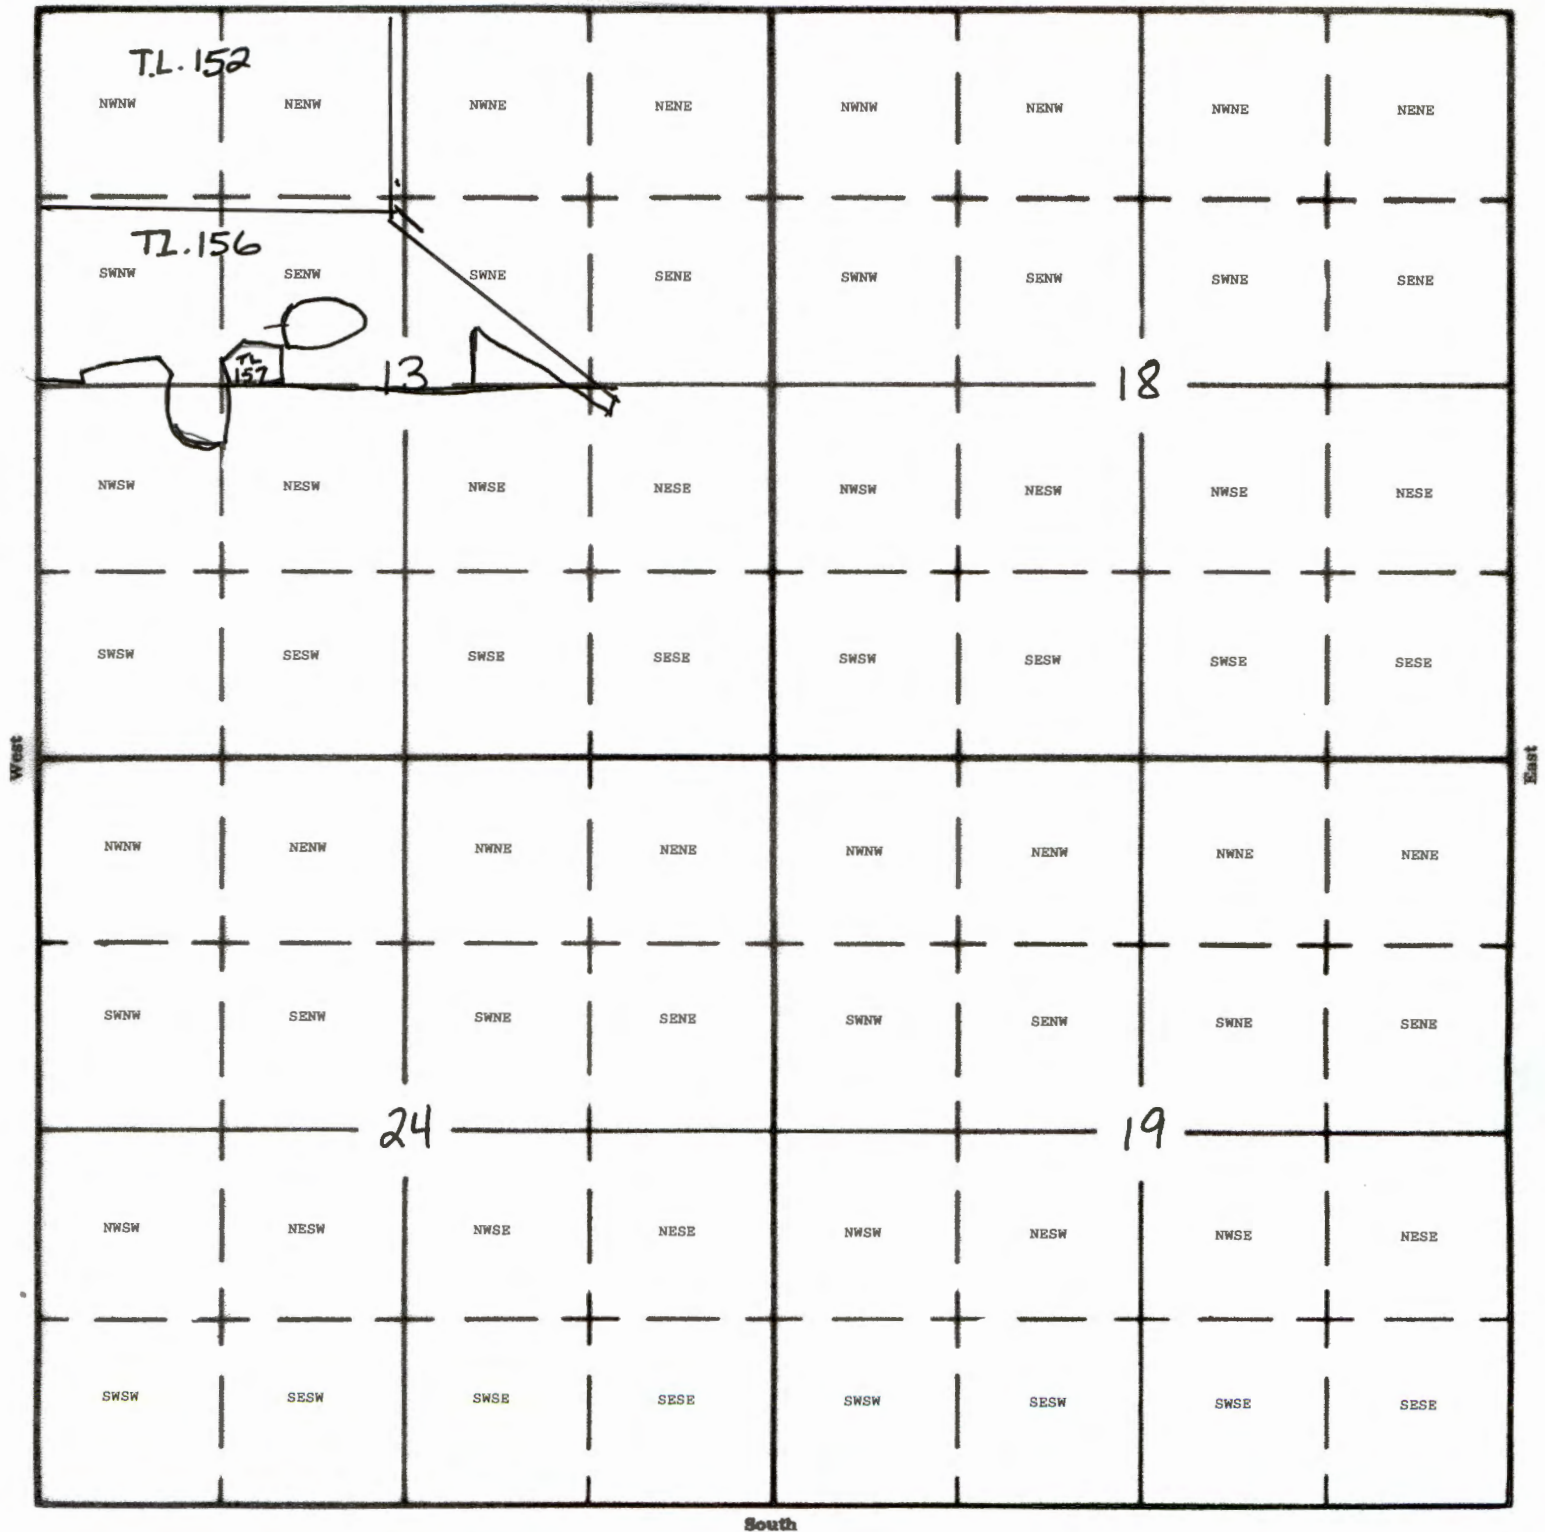

RECEIVED BY OWRD

JAN 18 2017

SALEM, OR

R-88360